


B.H. No. 1-40  
2 10' 2" broken  
3 10' 2" broken  
BoreHoles in Red Openings

26  
11  
8

1920  
1920

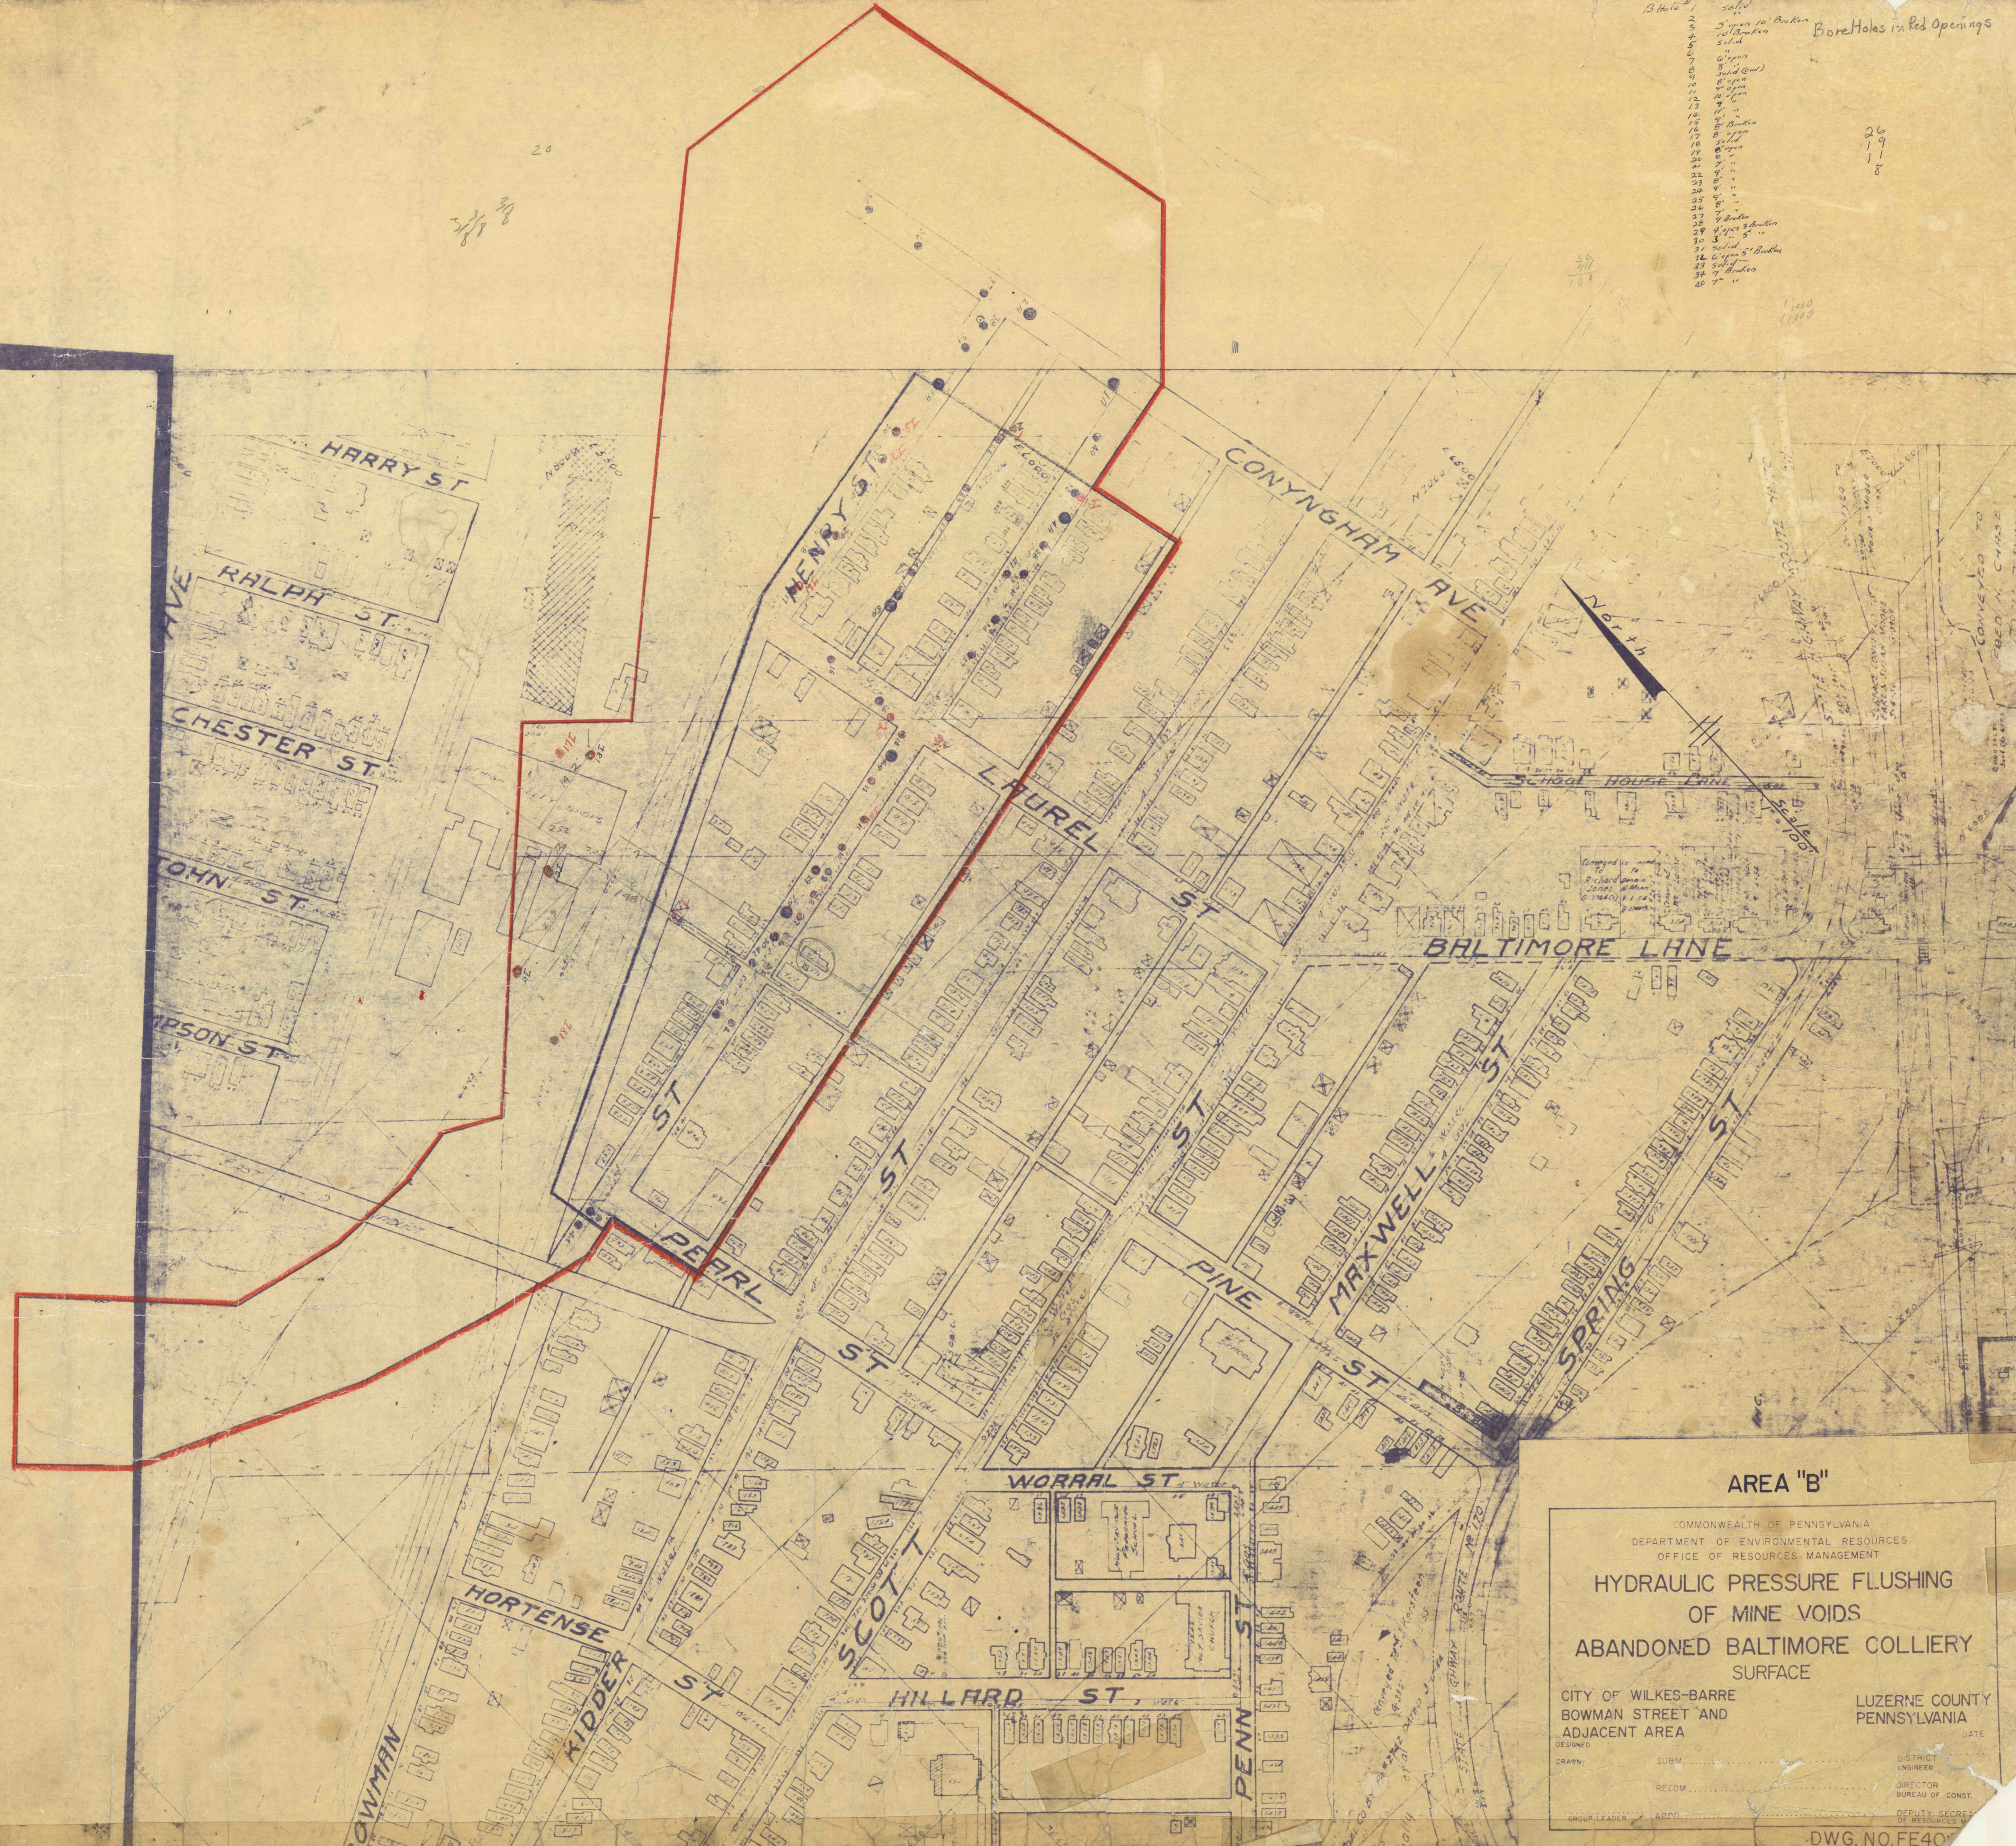

**AREA "B"**

COMMONWEALTH OF PENNSYLVANIA  
DEPARTMENT OF ENVIRONMENTAL RESOURCES  
OFFICE OF RESOURCES MANAGEMENT

**HYDRAULIC PRESSURE FLUSHING  
OF MINE VOIDS  
ABANDONED BALTIMORE COLLIERY  
SURFACE**

CITY OF WILKES-BARRE  
BOWMAN STREET AND  
ADJACENT AREA

LUZERNE COUNTY  
PENNSYLVANIA

DESIGNED \_\_\_\_\_  
DRAWN \_\_\_\_\_  
RECOM \_\_\_\_\_  
GROUP LEADER \_\_\_\_\_

SUBM \_\_\_\_\_  
DATE \_\_\_\_\_

DISTRICT  
ENGINEER

DIRECTOR  
BUREAU OF CONST.

DEPUTY SECRETARY  
OF RESOURCES MGMT.

DWG. NO. FE40

Bowman St. [unclear] [unclear] [unclear]

CONVEYED TO  
BEO N. CHASE  
BOWMAN