



SUSQ RIVER

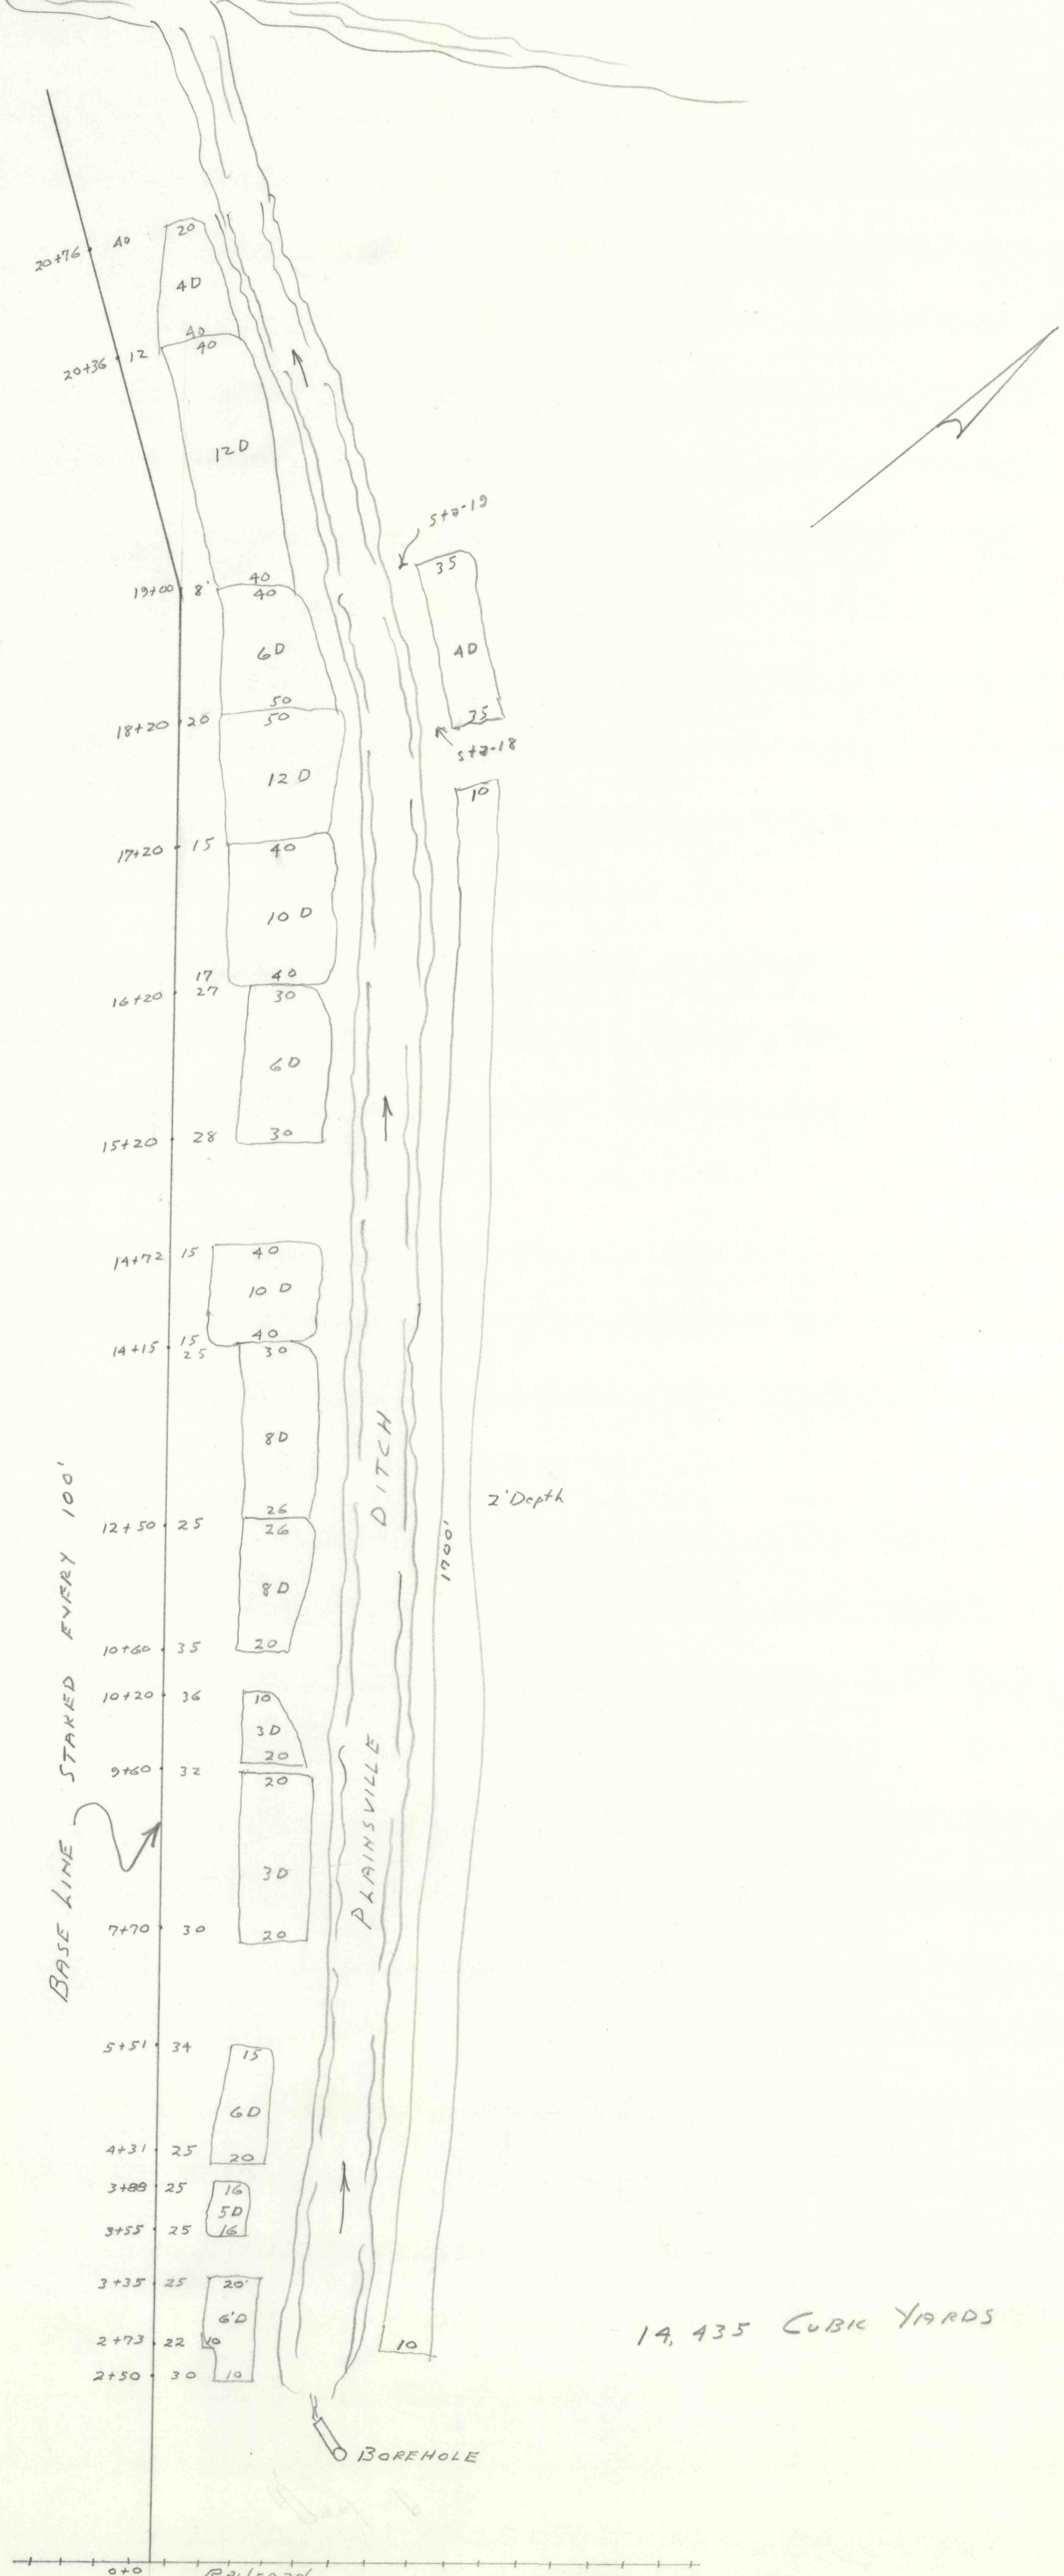

14,435 CUBIC YARDS

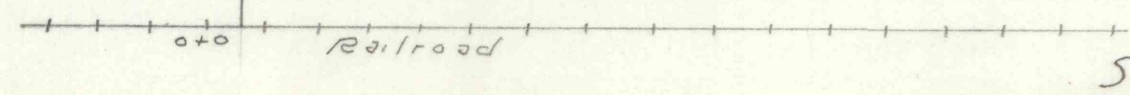

SKETCH
 FLOOD WASHOUTS
 PLAINSVILLE DITCH
 PLAINS TWP, PA.
 NOT TO SCALE
 DEC 10-75