



Top Soil Pit

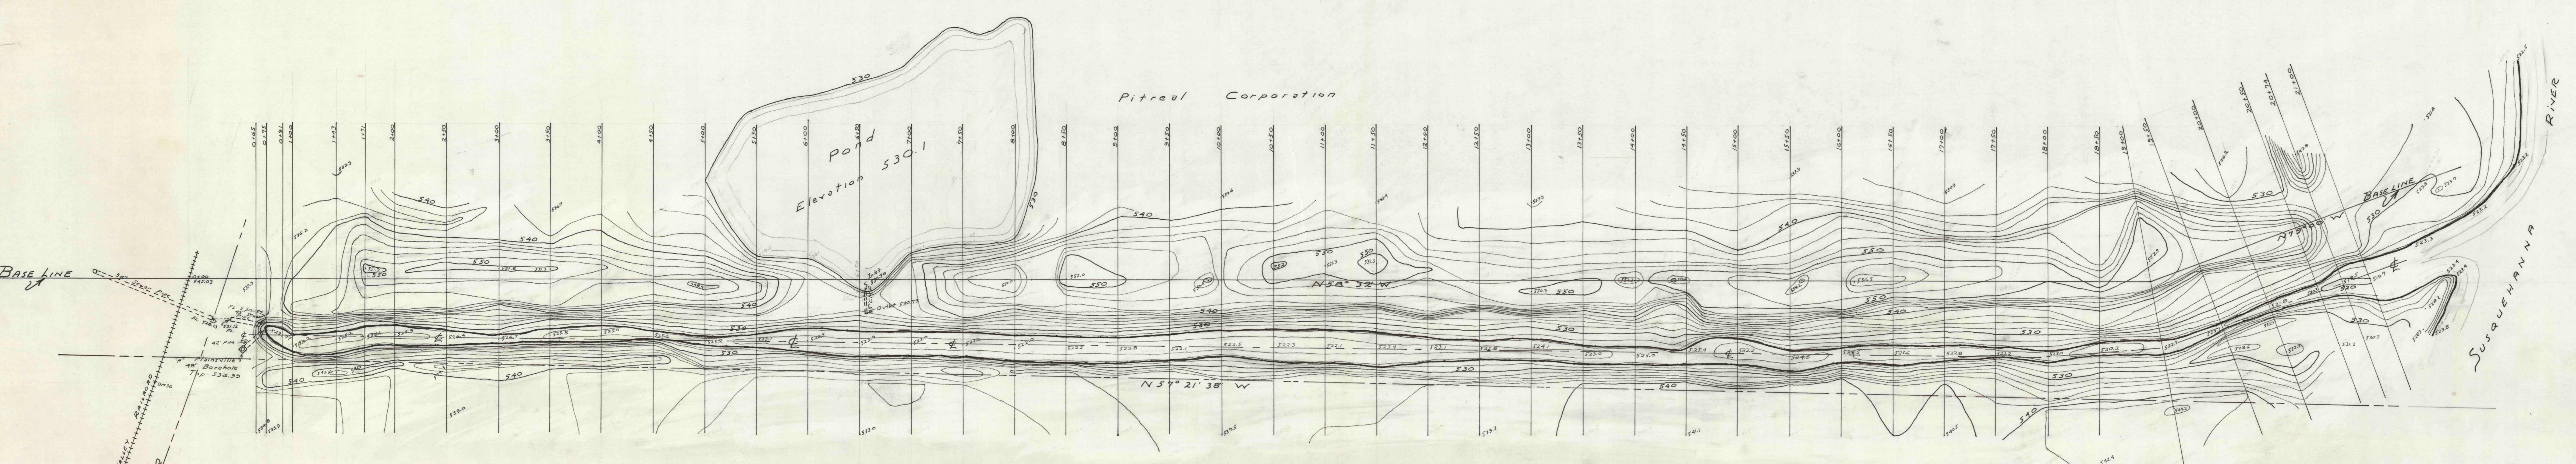

Harold J. Bernard E. Golemb

Form Land

SURFACE CONTOURS  
SCALE 1" = 50'

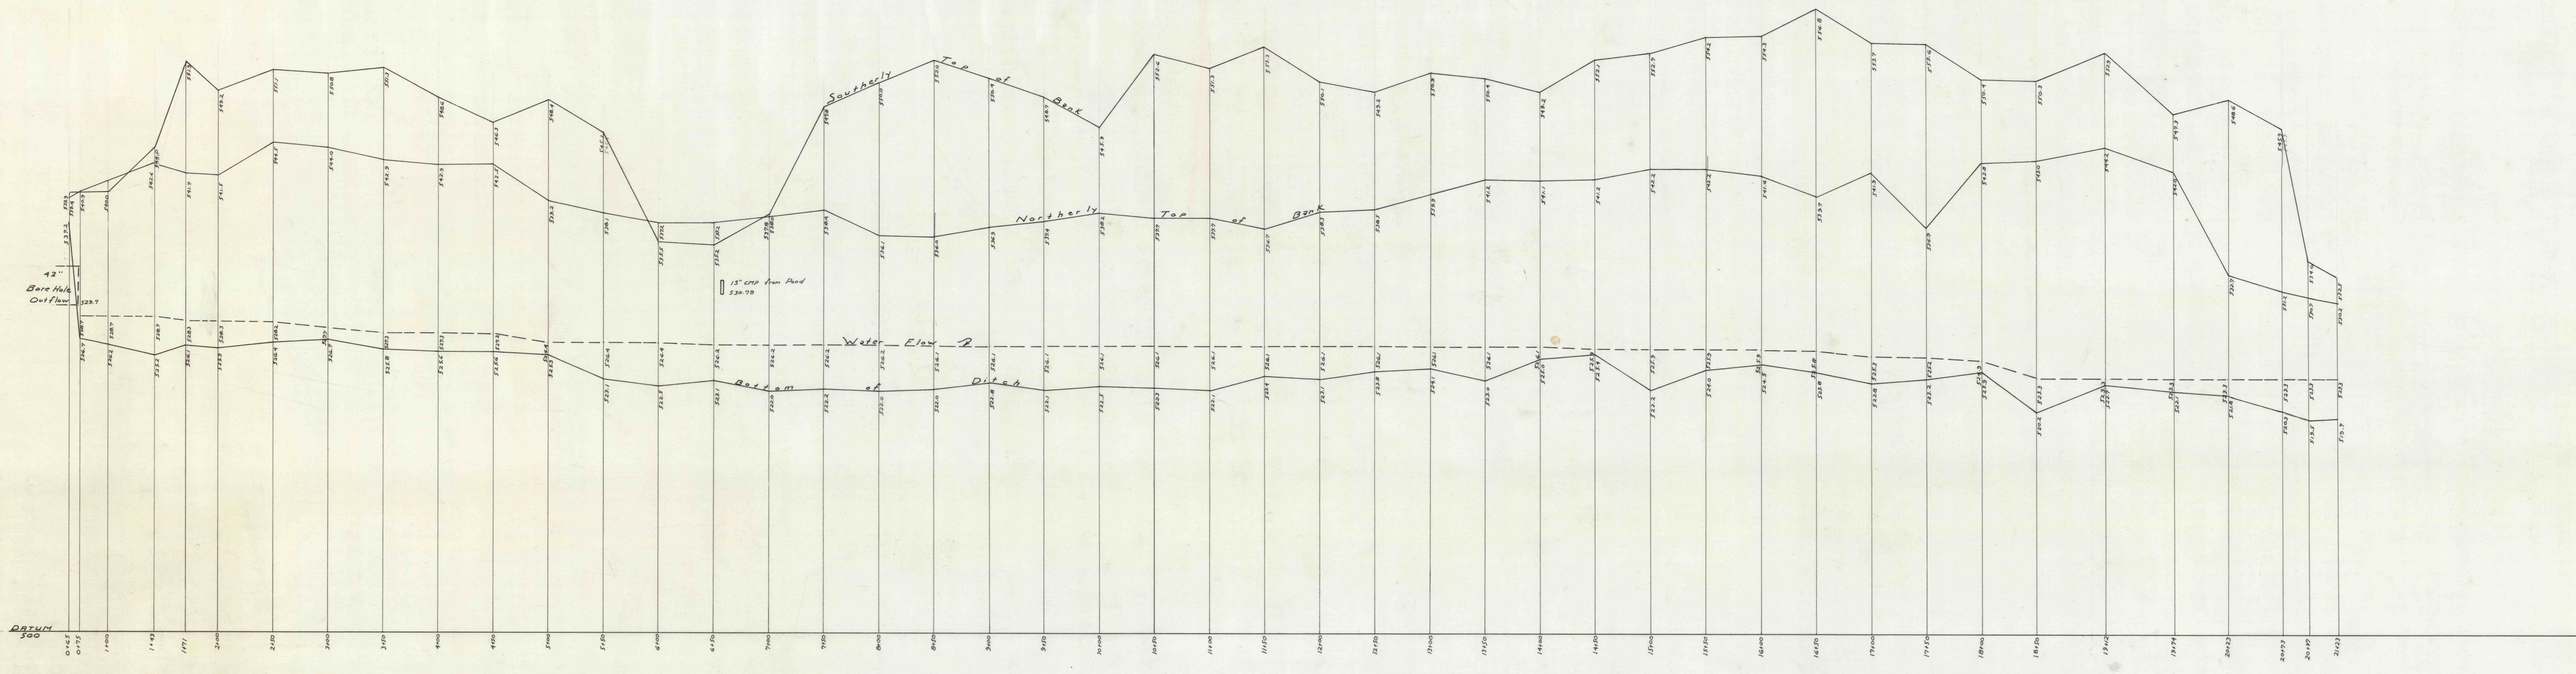

PROFILE ALONG  $\frac{1}{2}$  OF DITCH  
VERTICAL SCALE 1" = 5'  
HORIZONTAL SCALE 1" = 50'

NOTE:  
All elevations on U.S. Coast and  
Gadsden Base.

PLAINS TOWNSHIP DRAINAGE DITCH  
PLAINS TOWNSHIP, LUZERNE COUNTY, PA.  
DATE OF SURVEY - DEC. 12, 1975  
Pg. Stella CHIEF OF PARTY  
Philip J. Ravitch CHIEF OF PARTY  
Frank Debus Jr. - SURVEYOR