


CHECKER VEIN
STEVENS

CHECKER VEIN
STEVENS

CHECKER VEIN
STEVENS

CHECKER VEIN
STEVENS

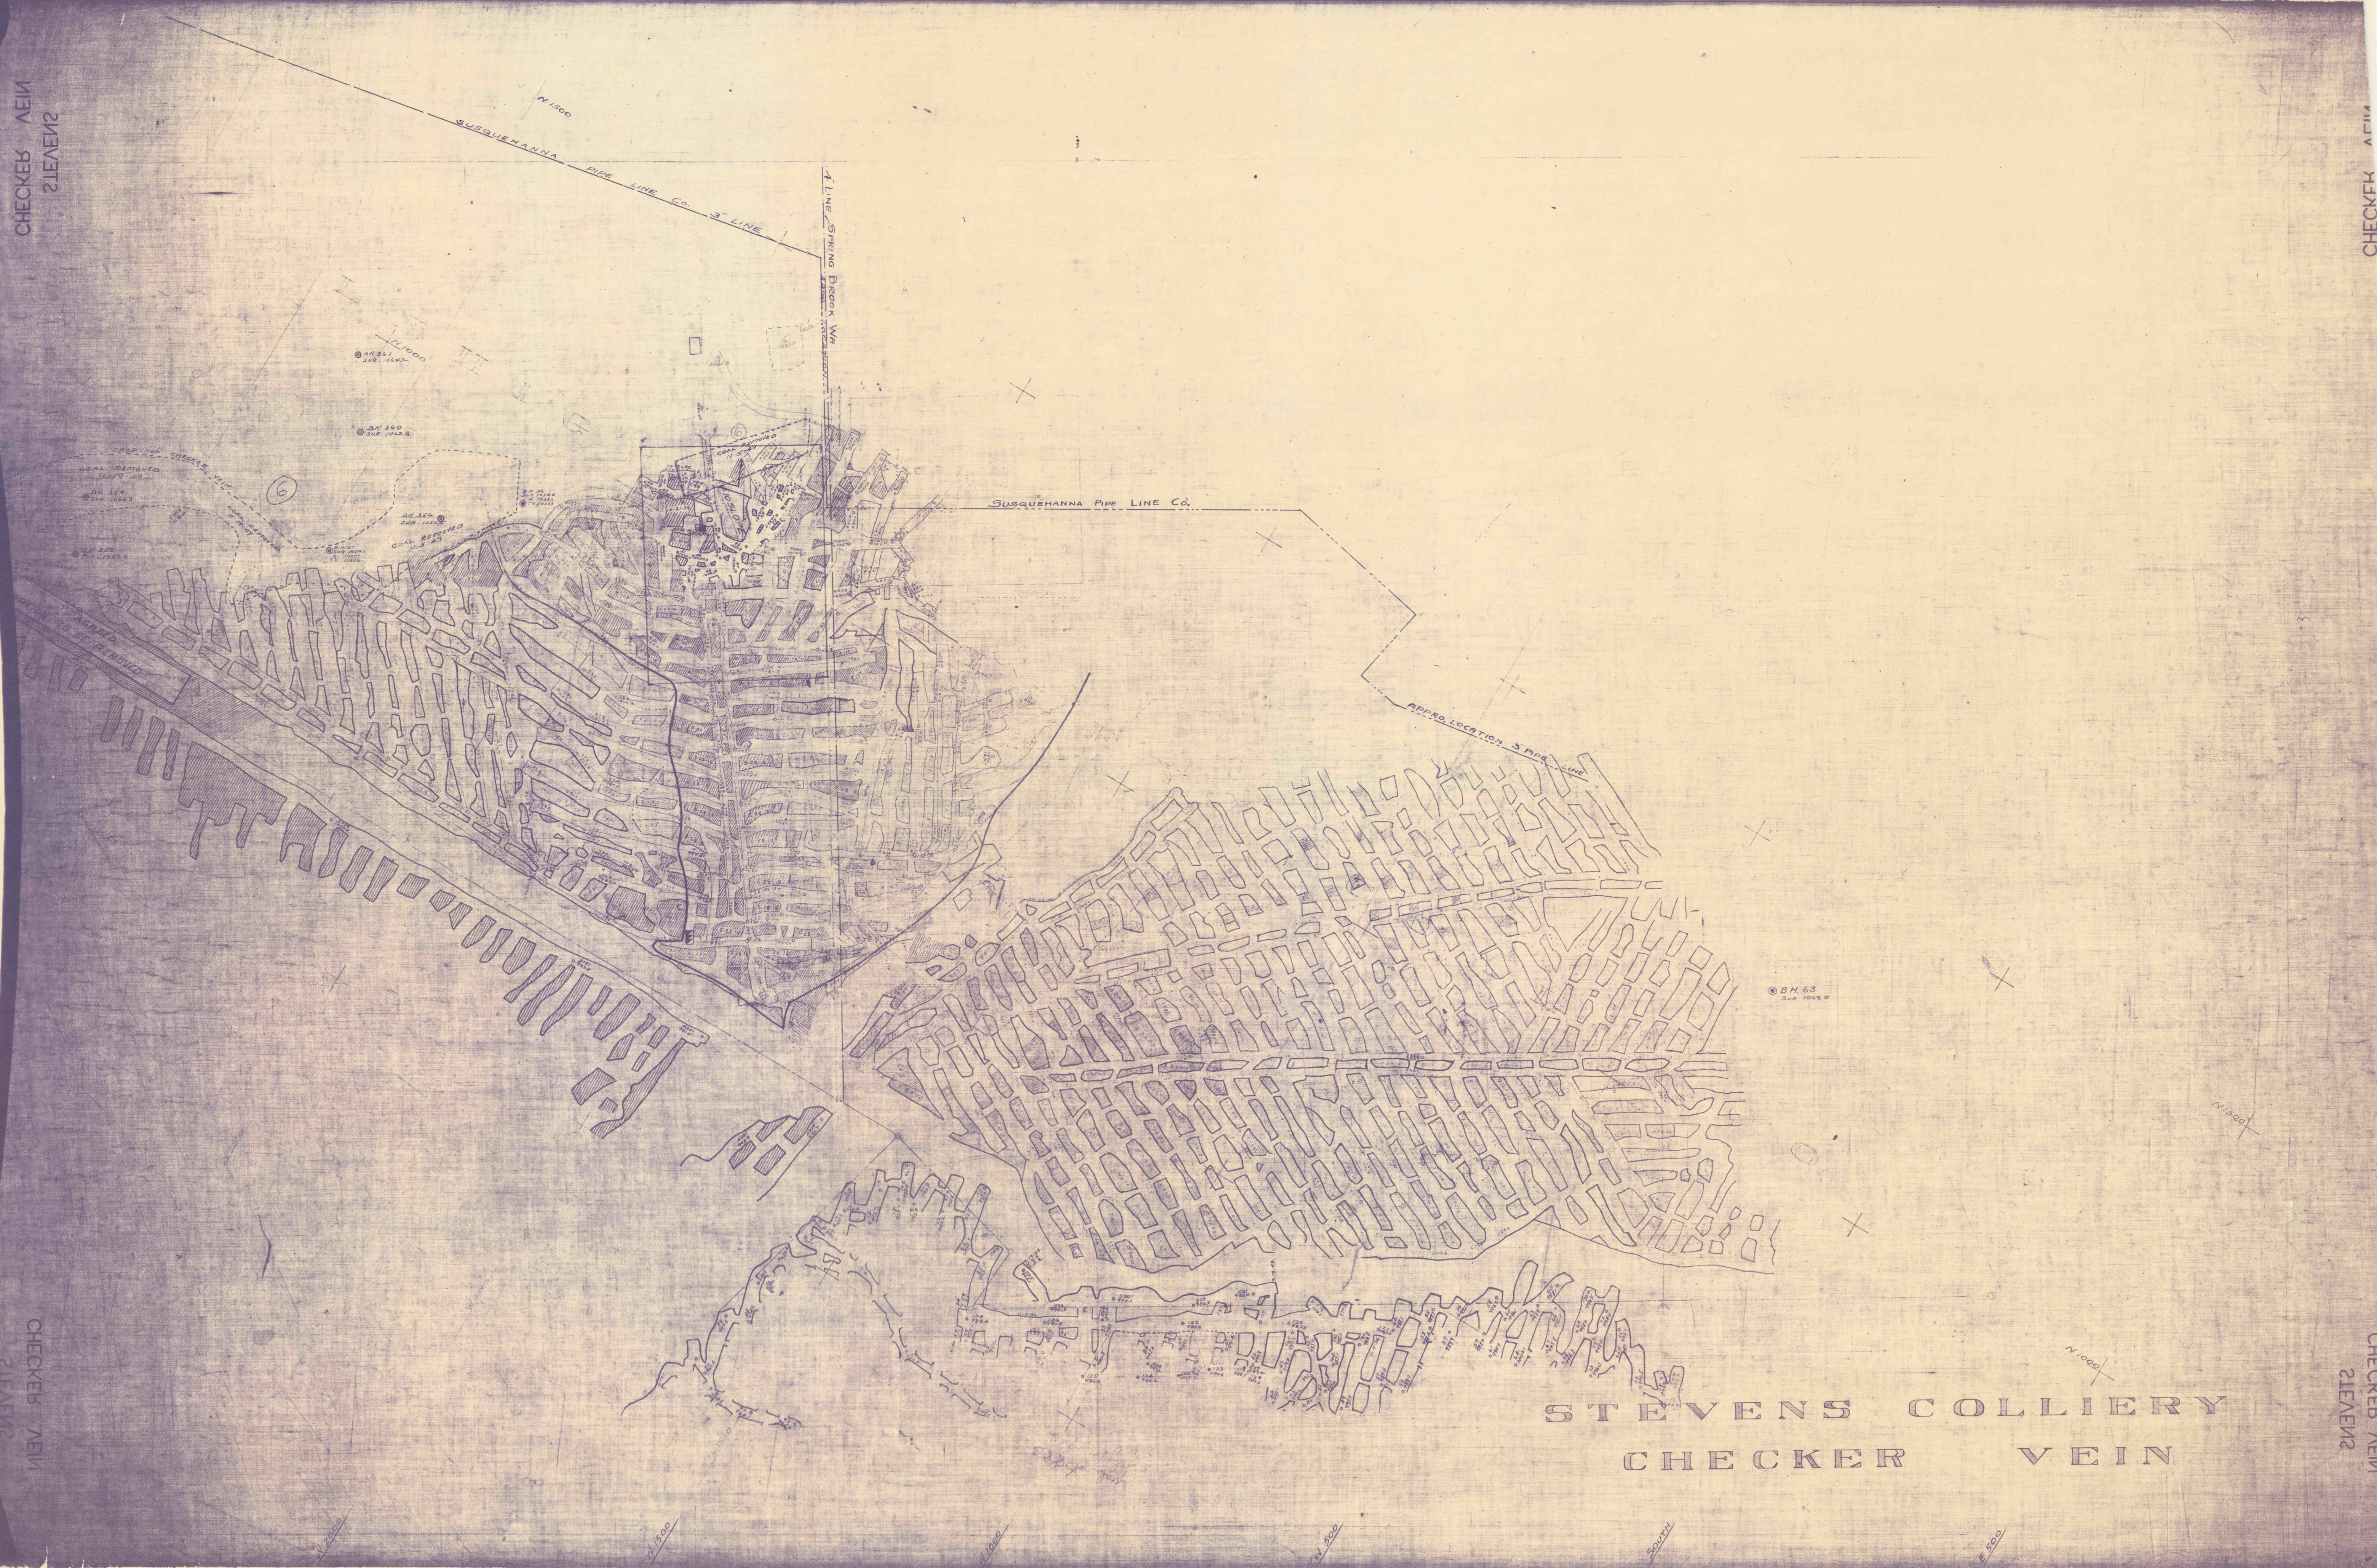

STEVENS COLLIERY
CHECKER VEIN

SUSQUEHANNA PIPE LINE CO. 3" LINE
N 1500

SUSQUEHANNA PIPE LINE CO.

APPROX. LOCATION 3" PIPE LINE

BH 63
SUR 1063.0

N 1000

N 1700

N 1600

N 2000

SOUTH

N 500