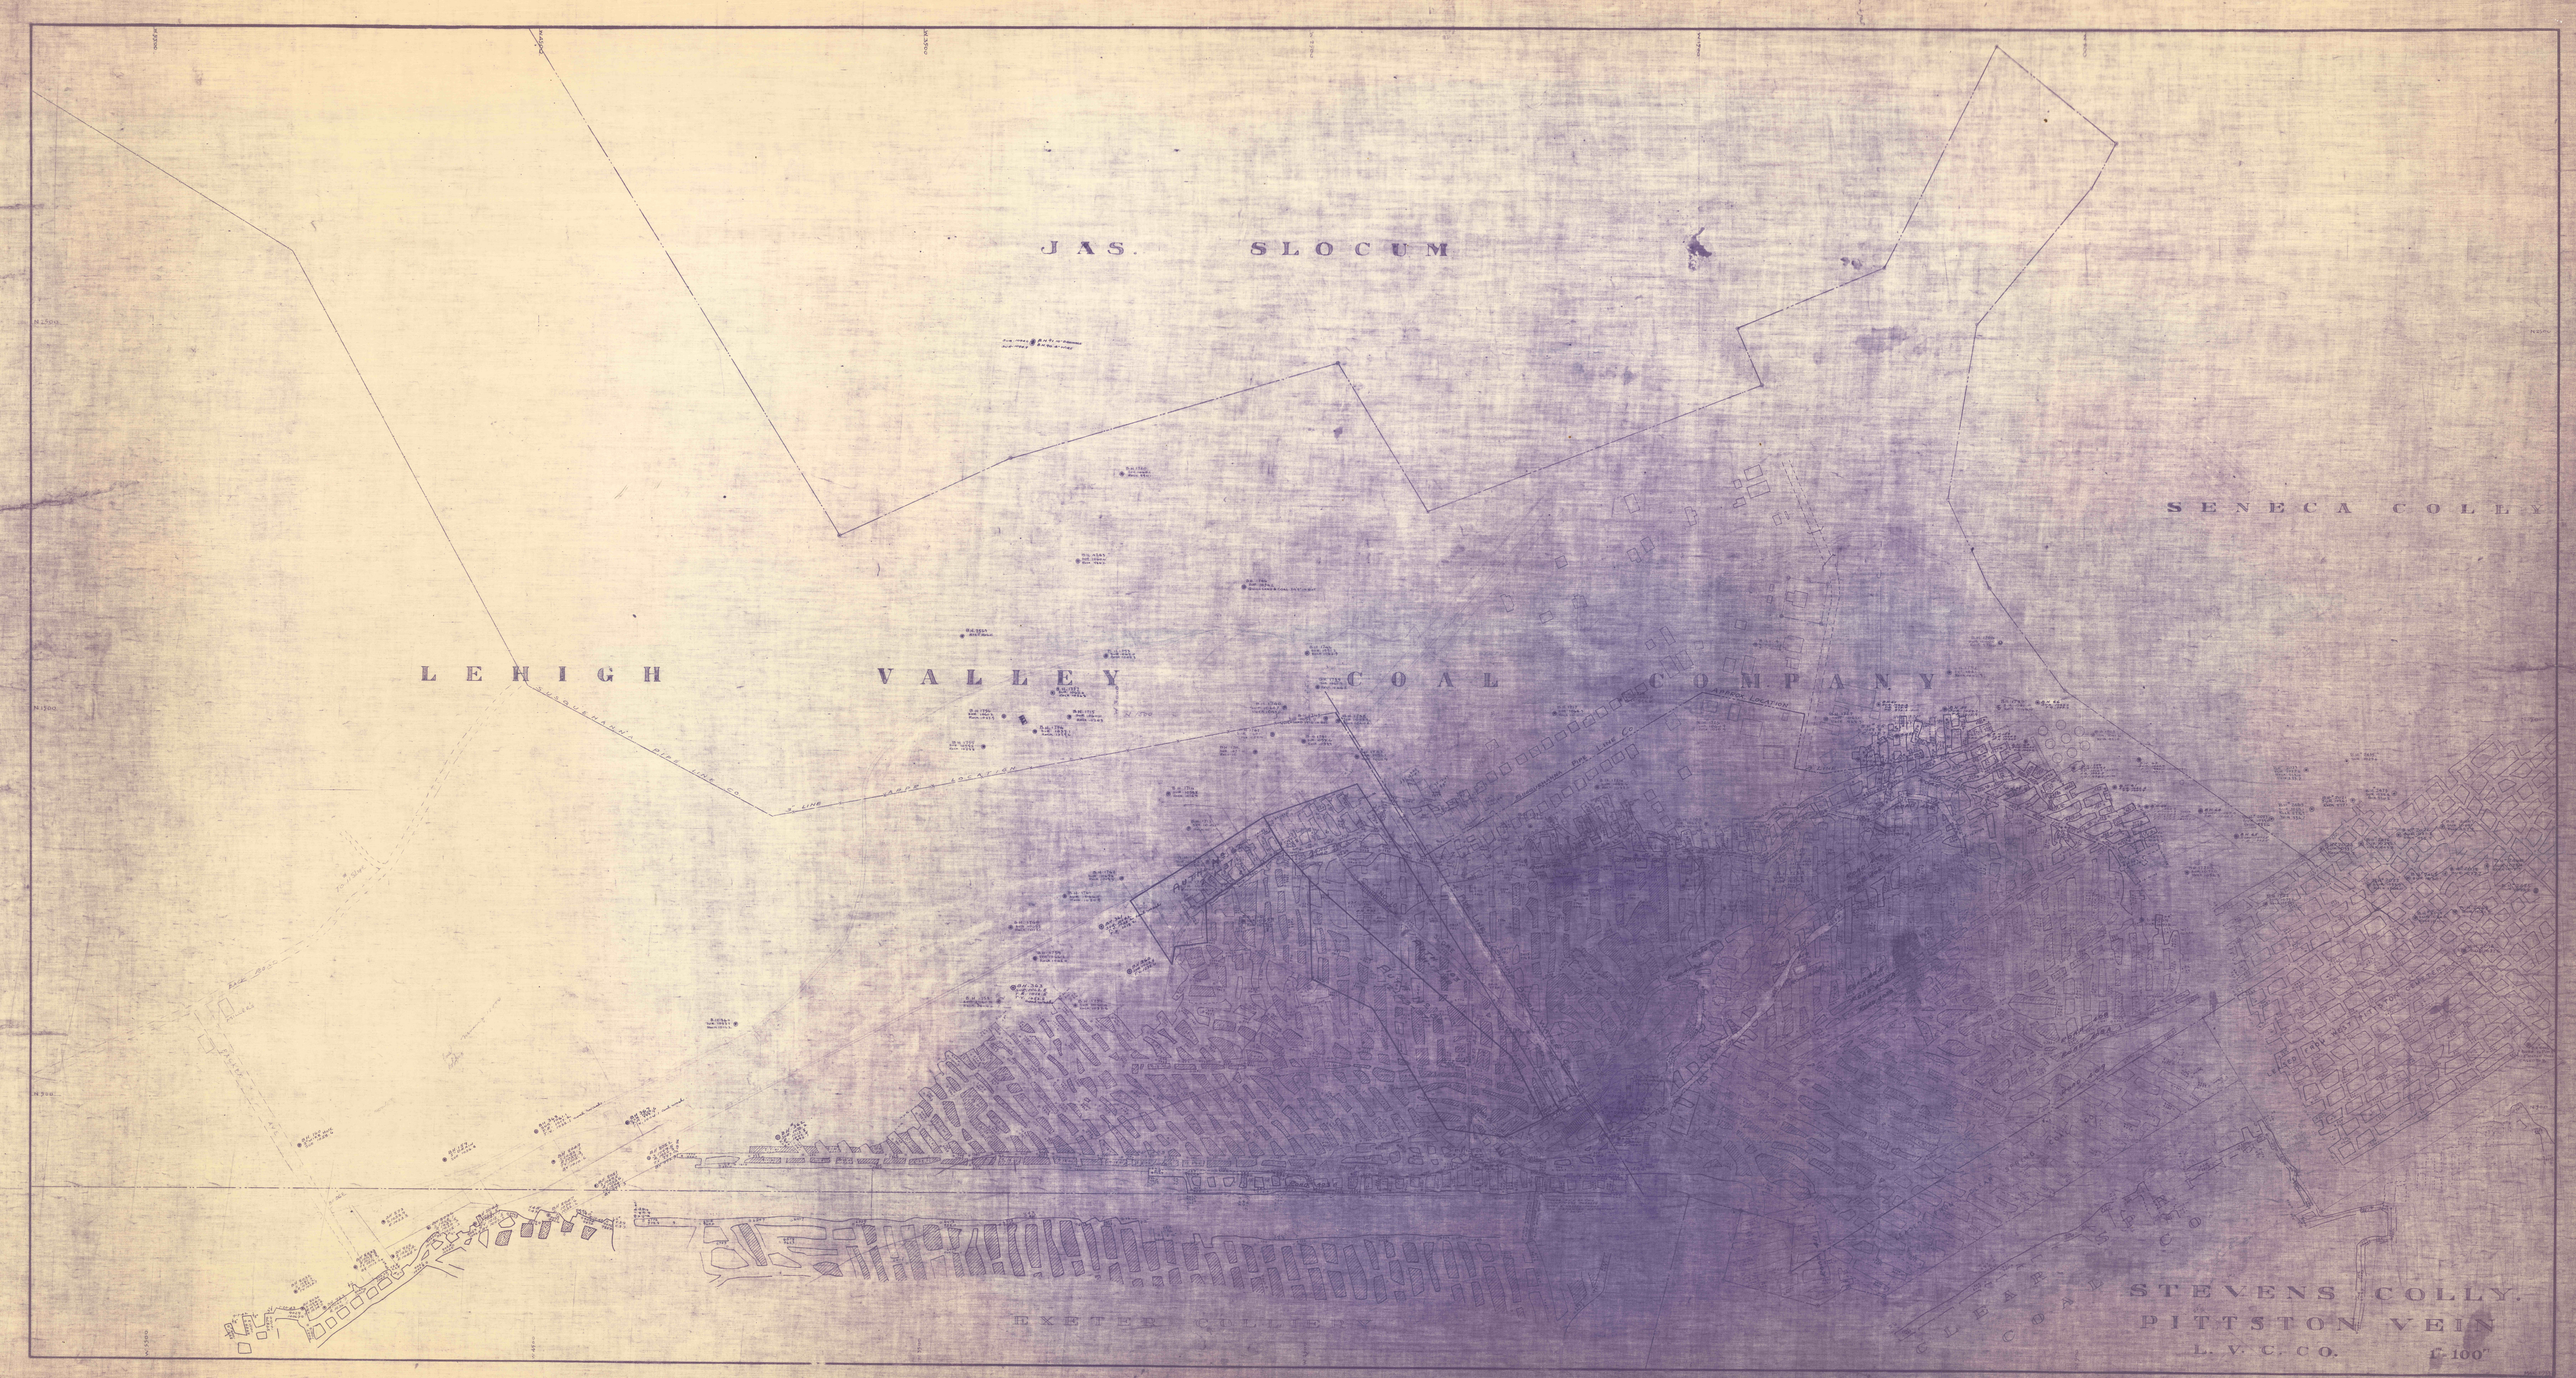
JAS. SLOCUM
SENECA COLLY
LEHIGH VALLEY COAL COMPANY
EXETER COLLY
STEVENS COLLY.
PITTSTON VEIN
L. V. C. CO.
1" = 100'