


S L O C U M , C A R P E N T E R &
O A K F O R D

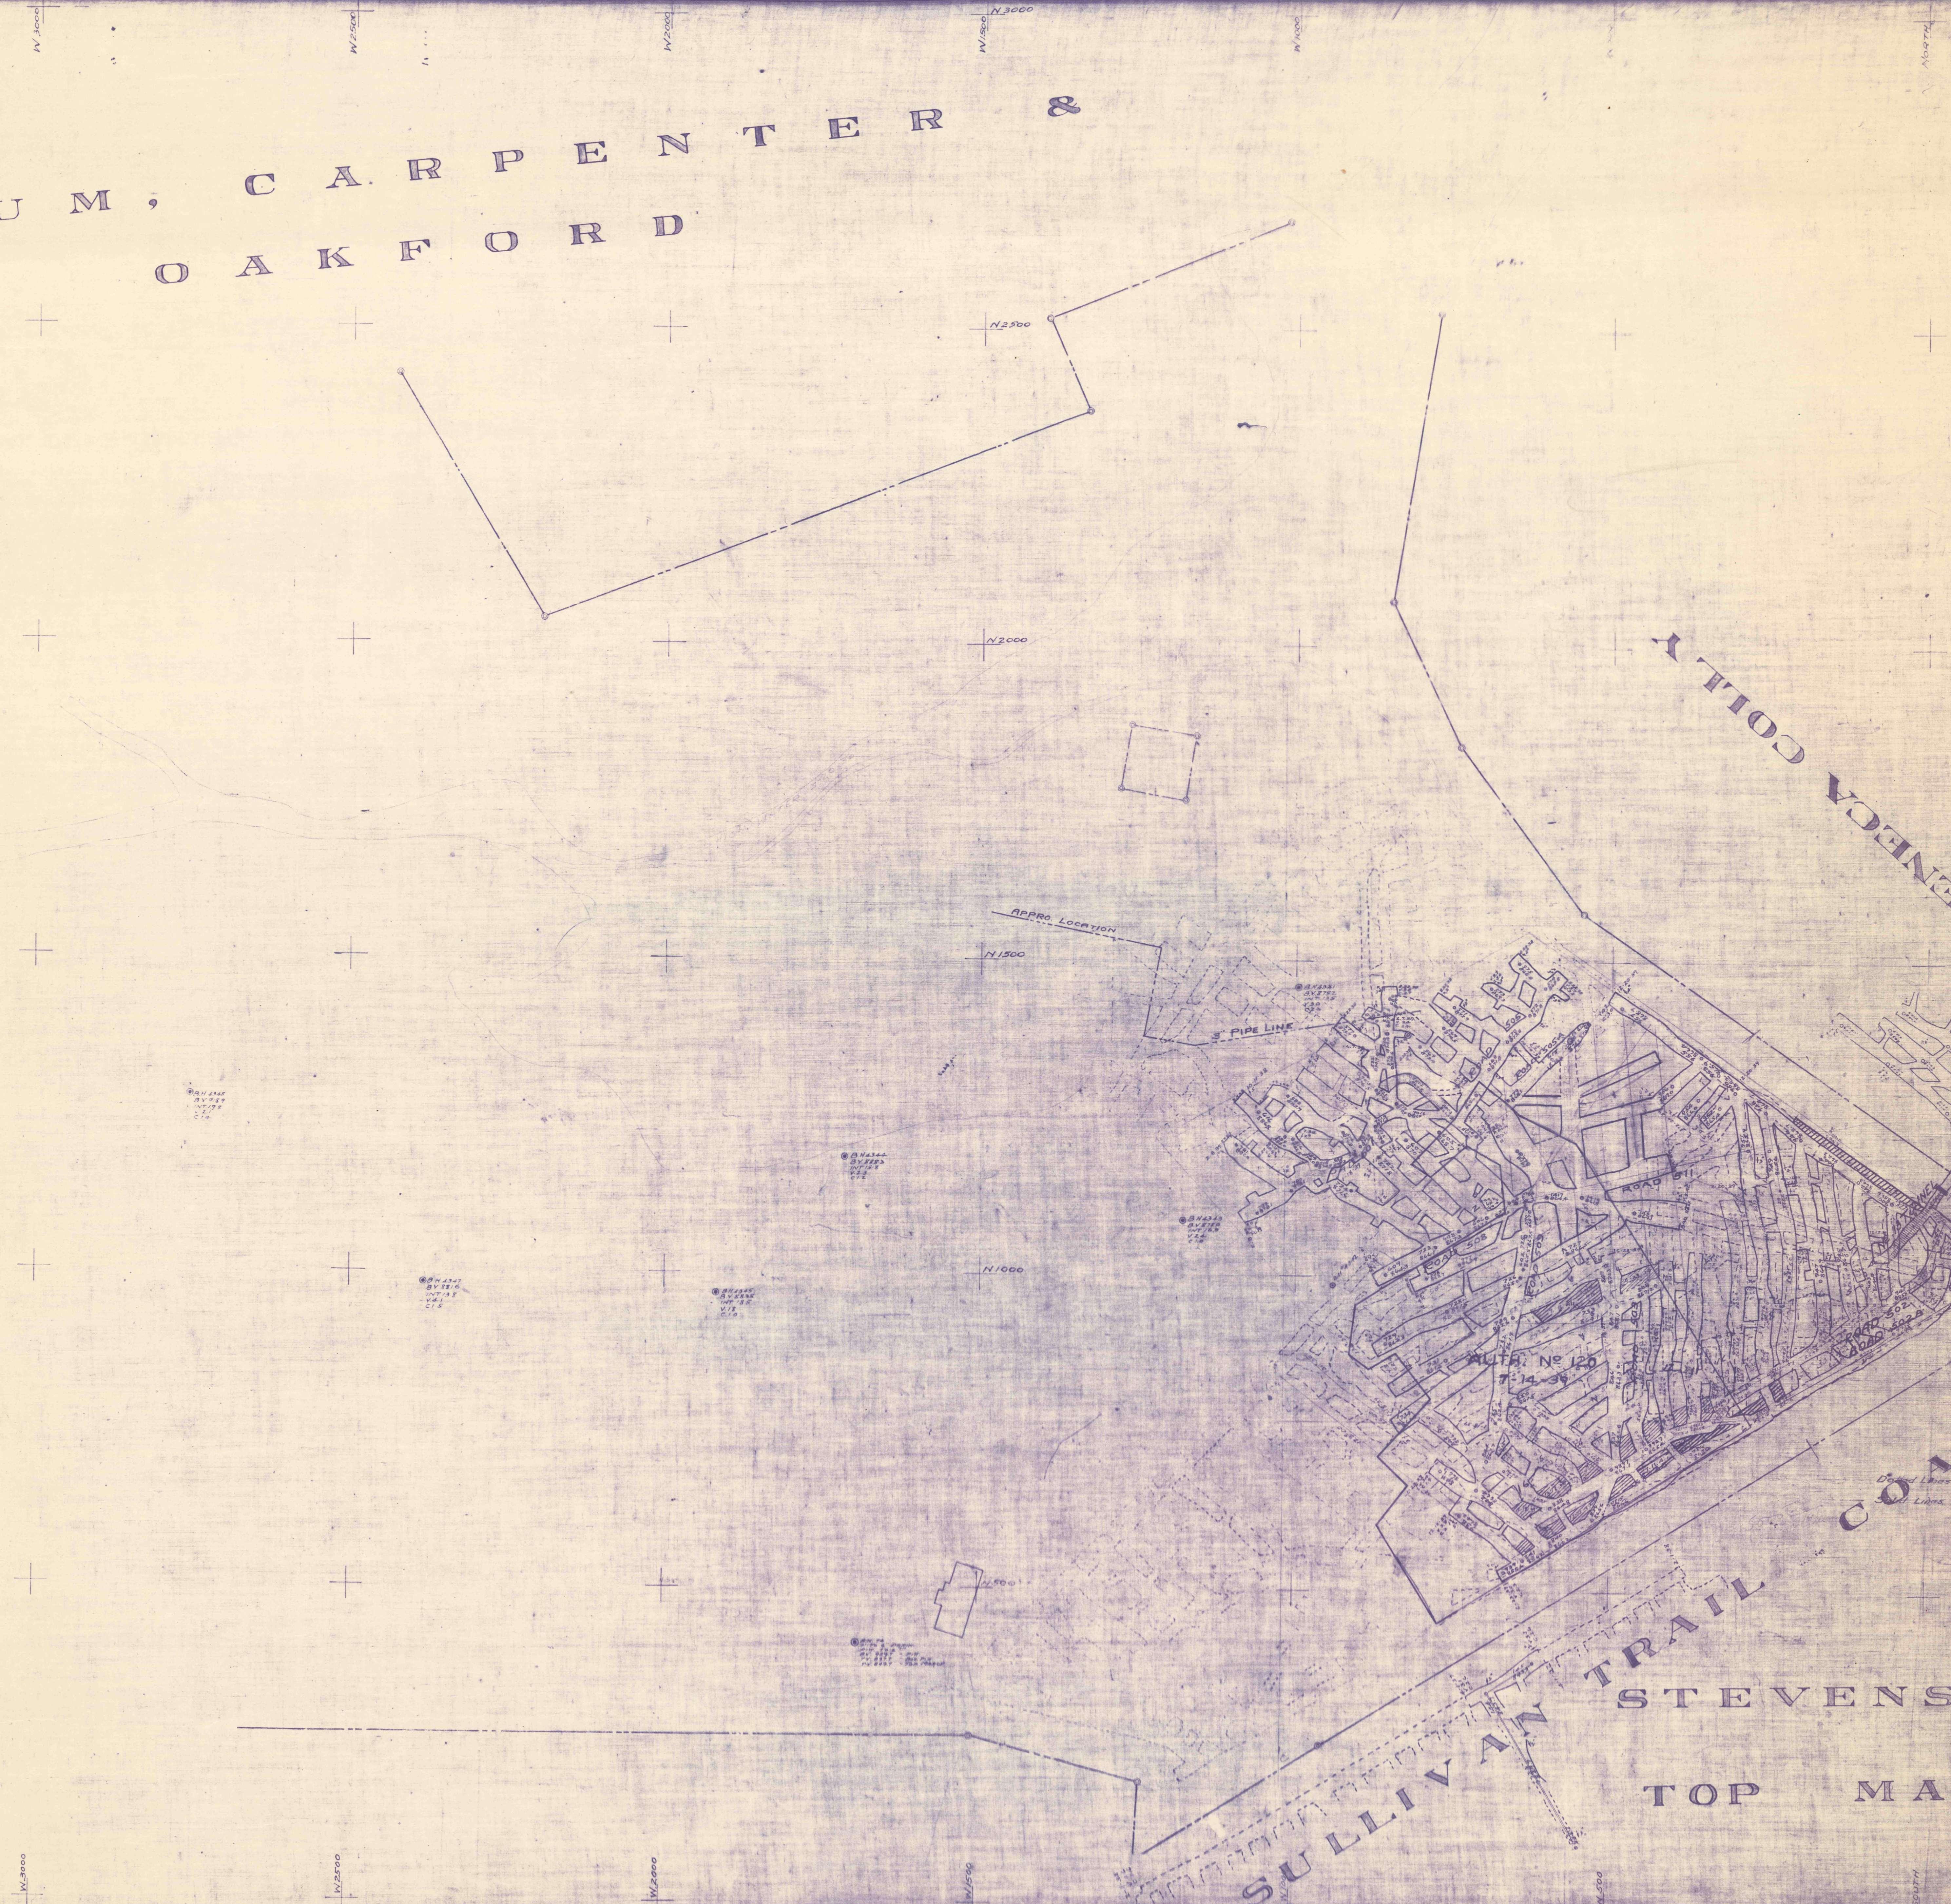

SENECA COLLY

SULLIVAN TRAIL COIL CO
STEVENS COLLIER
TOP MARCY VE