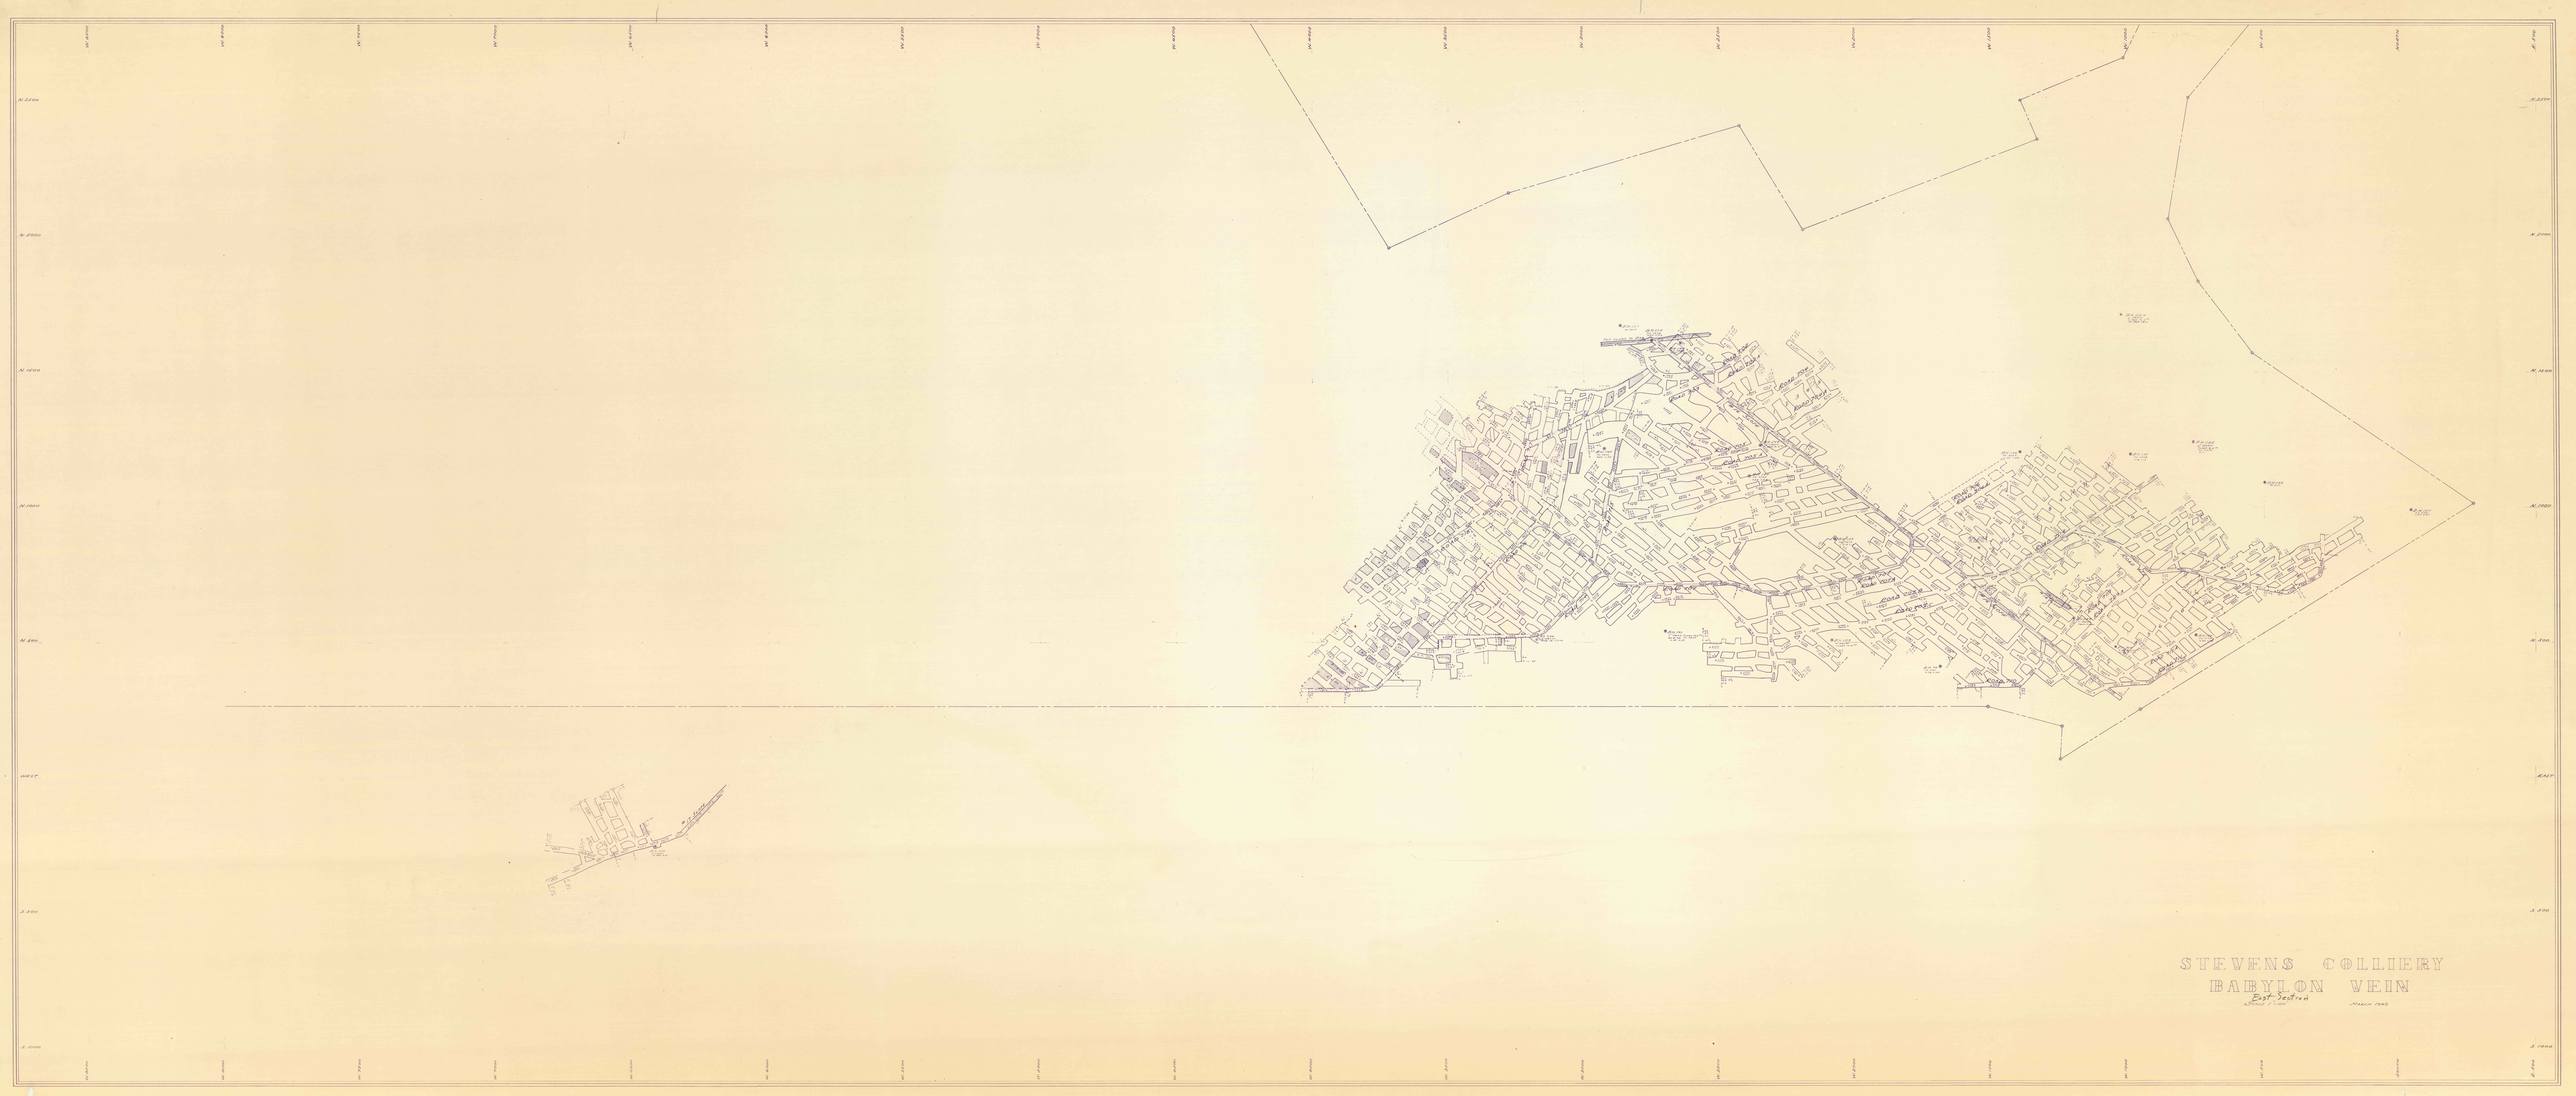
STEVENS COLLIERY
BABYLON VEIN
East Section
March 1945