


Stevens
Babylon
#118 Slopes

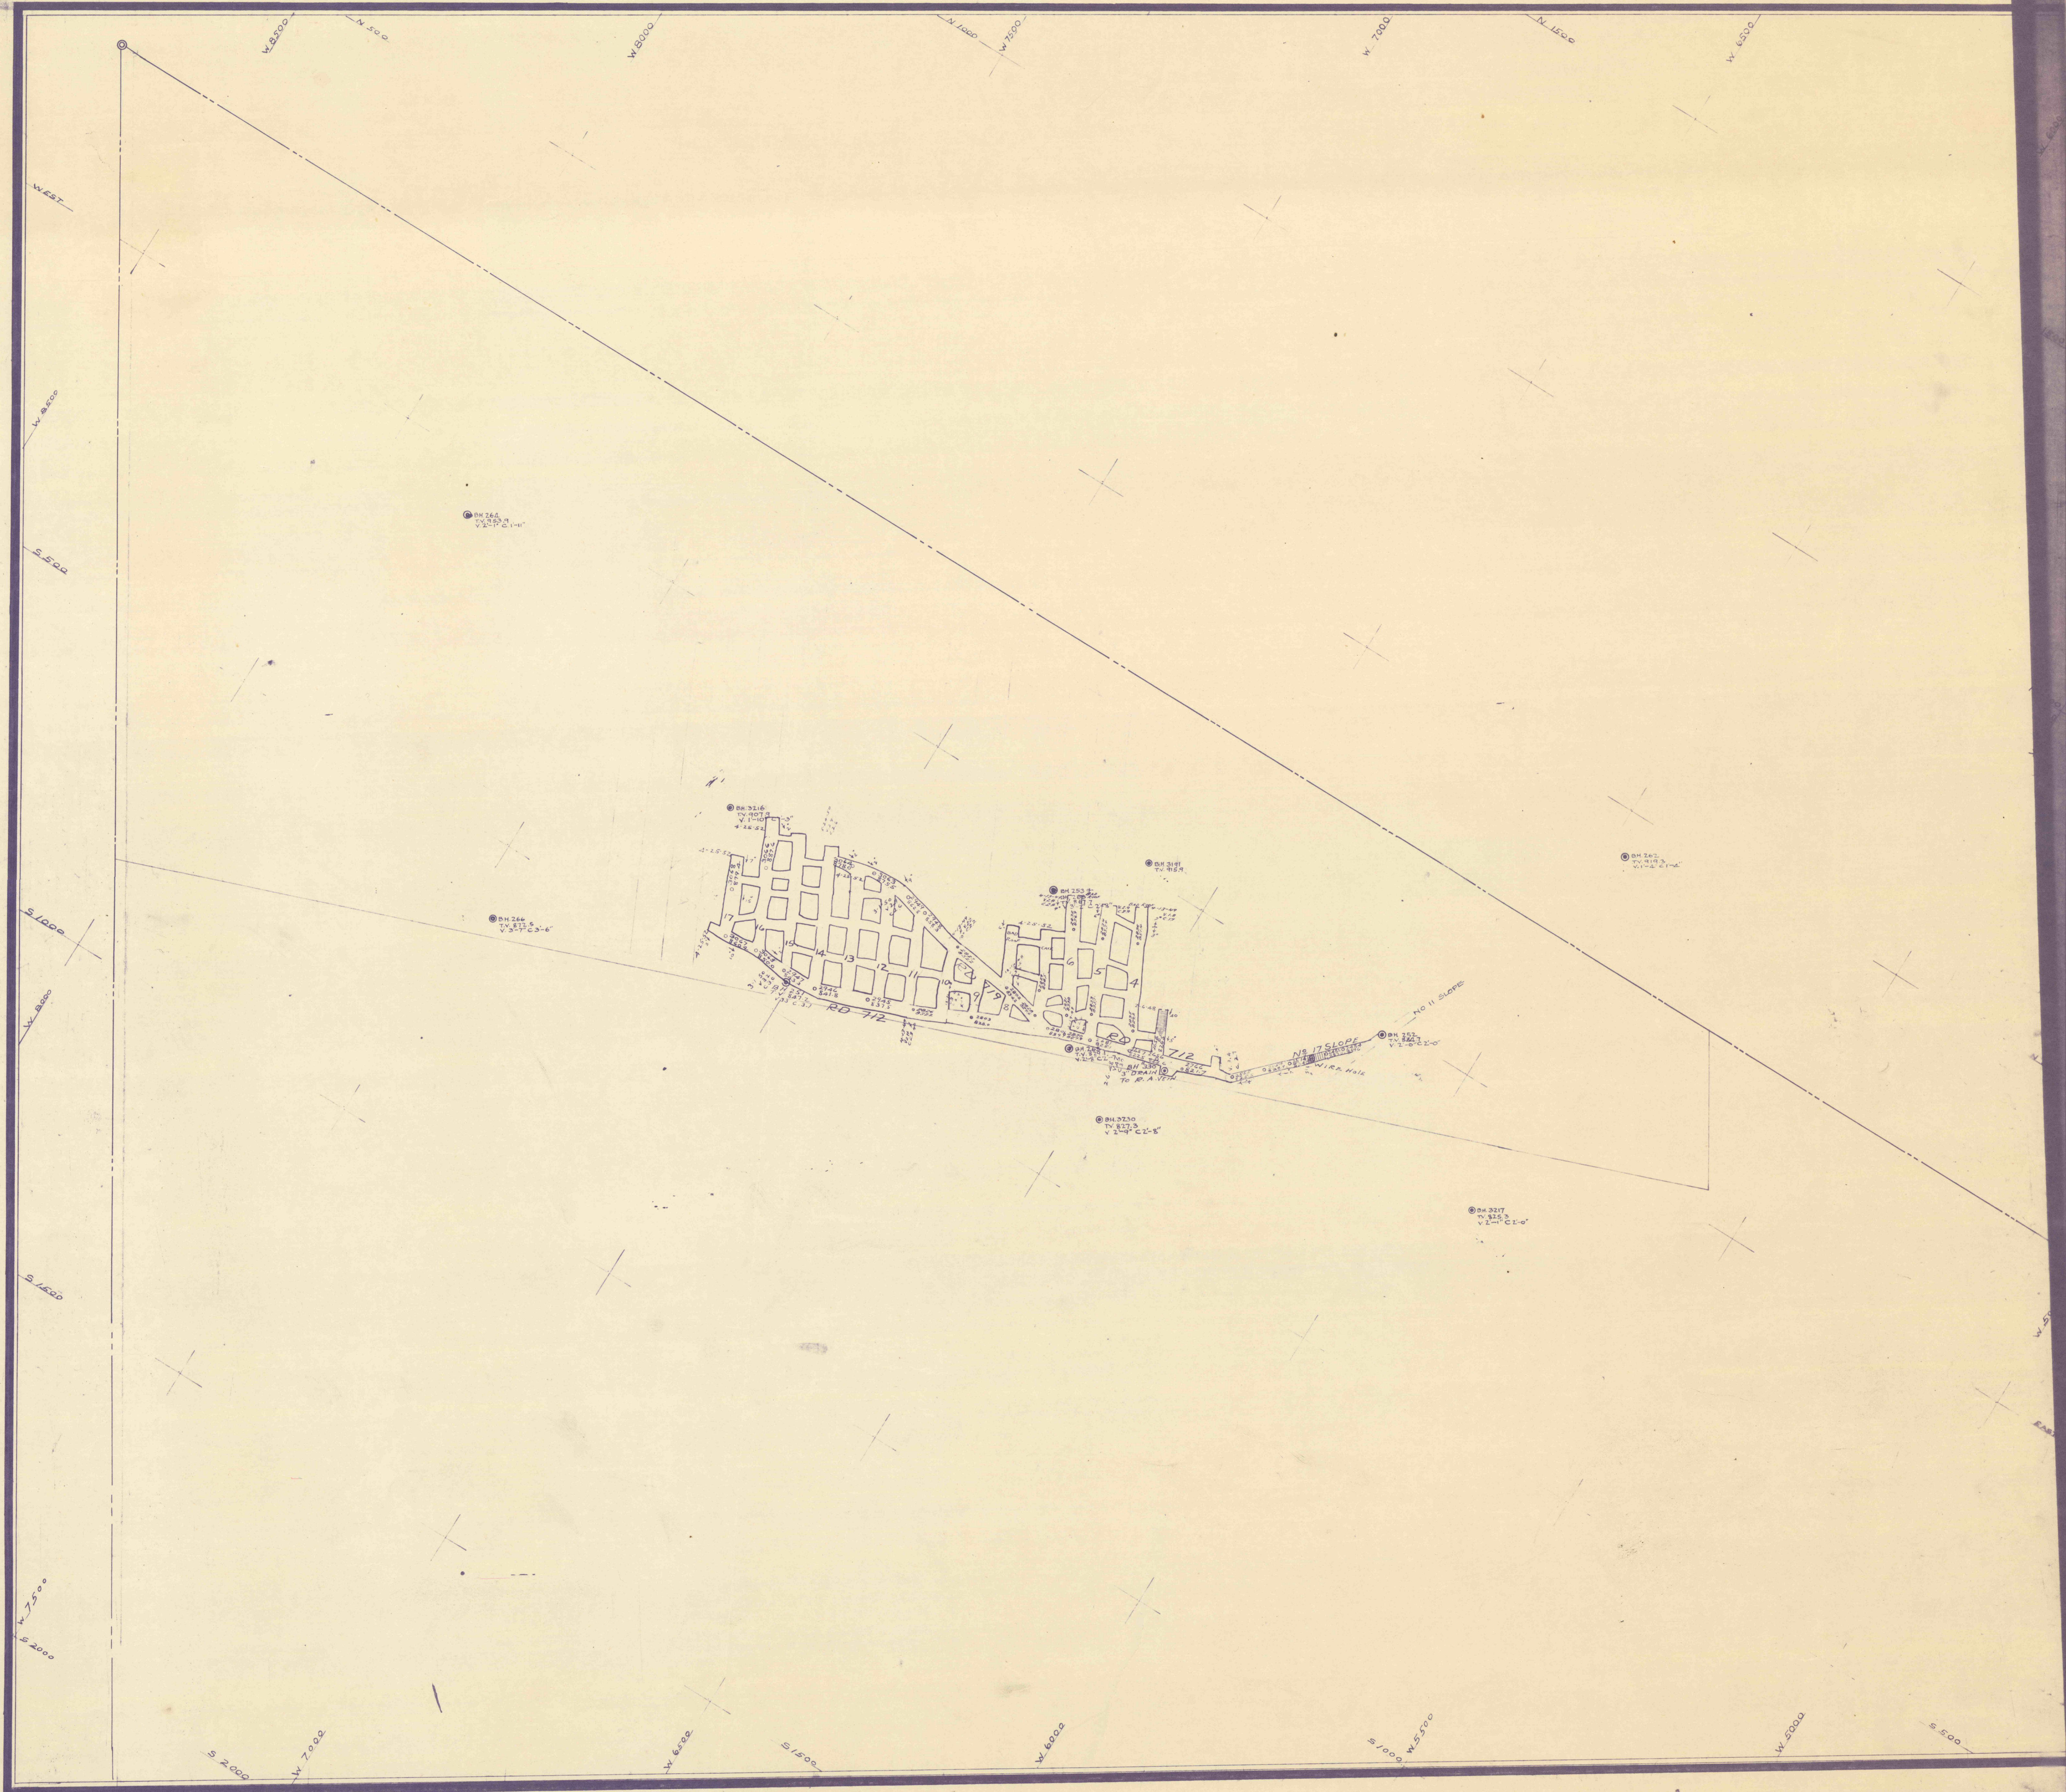

Stevens
Babylon-
#118 47 Slopes

East This print fits on large Babylon Print

Babylon #11 Slopes

Stevens
Babylon
#118 47 Slopes