


STATION 0+00 1+00 2+00 3+00 4+00 5+00 6+00 7+00 8+00 9+00 10+00 11+00 12+07.96 12+50 13+00 13+50 14+00 14+50 15+00 15+50 16+00
 ELEVATION 730 740 750
Roadway 'A' Center Line Profile
 SCALE HORIZONTAL 1"=50' VERTICAL 1"=10'

LEGEND

- EXISTING GRADE
- FINISHED GRADE
- (700) EXISTING GRADE
- (700) FINISHED GRADE
- DITCH TYPE SEE DRAWING NO. D-1

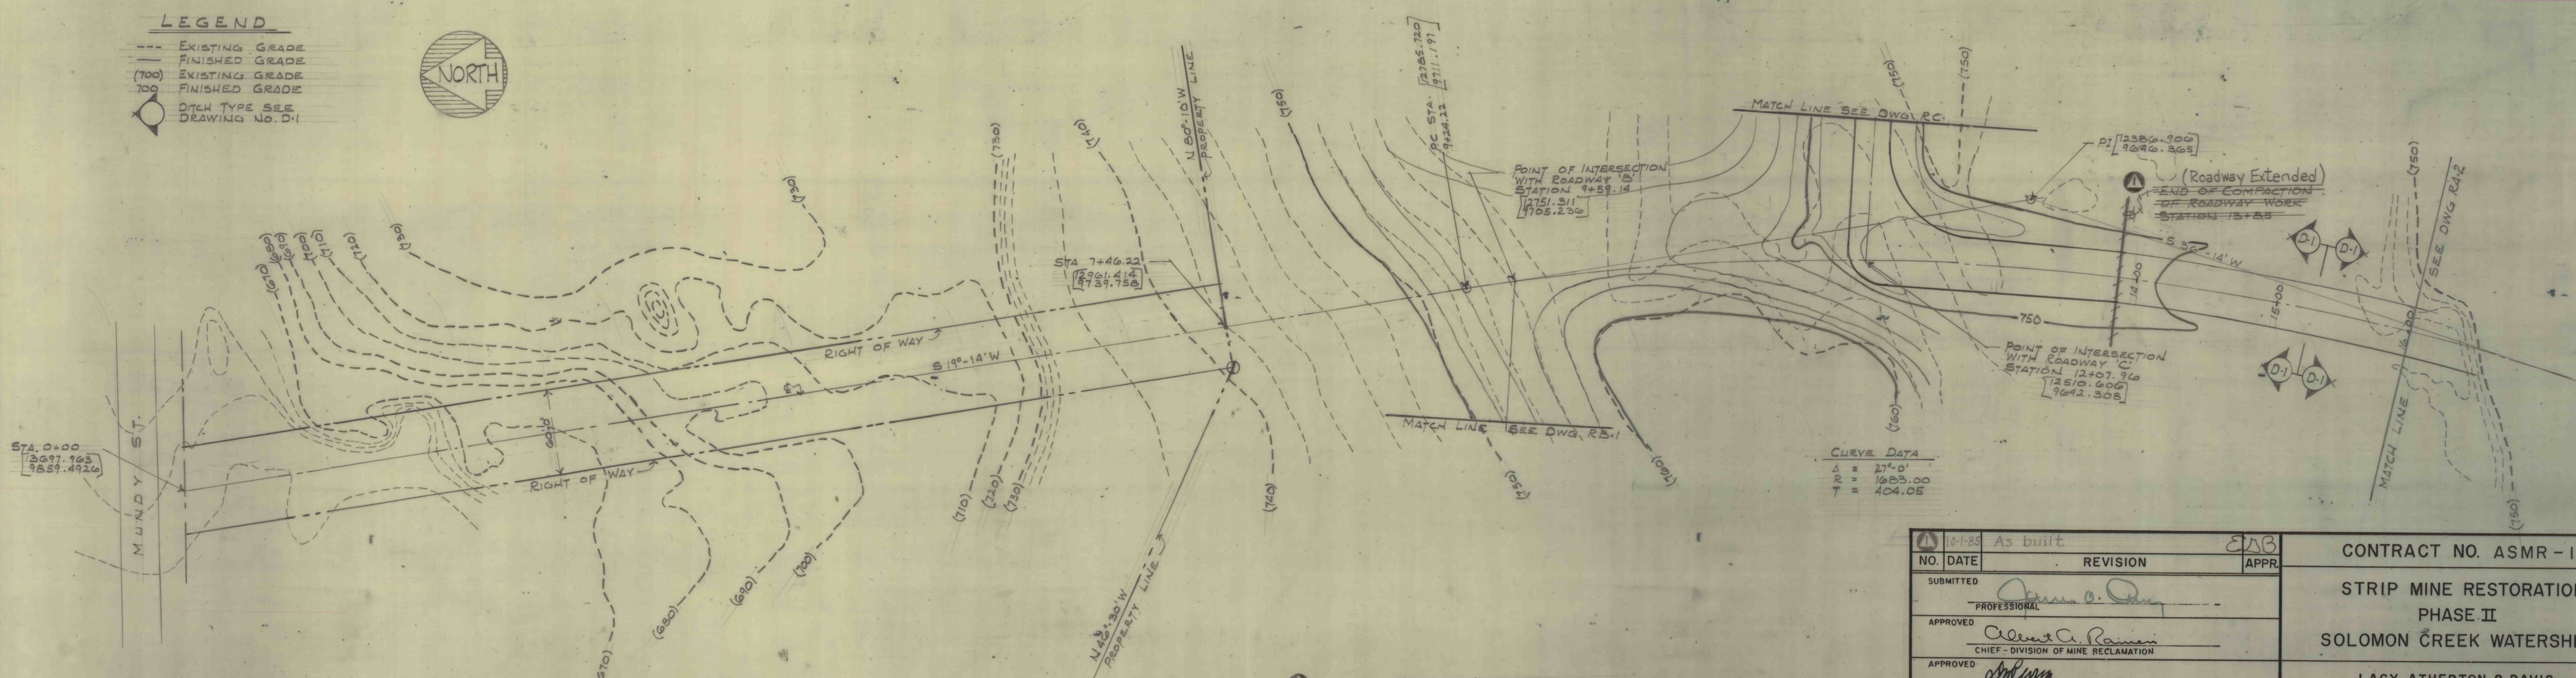

Note: For finish contours, see new Plan Dwg's. No. A1 of 3 thru A3 of 3.

NO. DATE		REVISION	APPR	CONTRACT NO. ASMR-18
SUBMITTED				
APPROVED		PROFESSIONAL		LACY, ATHERTON & DAVIS ARCHITECTS & ENGINEERS WILKES-BARRE HARRISBURG WILLIAMSPORT
APPROVED		CHIEF - DIVISION OF MINE RECLAMATION		
APPROVED		DIRECTOR - BUREAU OF DESIGN		ROADWAY PLAN & PROFILE
(Seal)		(Seal)		
COMMONWEALTH OF PENNSYLVANIA DEPARTMENT OF ENVIRONMENTAL RESOURCES OFFICE OF RESOURCES MANAGEMENT				DRAWN BY DATE 4-28-80
CHECKED BY				SCALE RA-1