

LEGEND OF UTILITIES

- Water pipe line Pennsylvania Gas & Water Company
39 Public Square, Wilkes-Barre, Pa.-18711. Tel.(717)824-8711
- - - Gas Pipe line Same as above
- Telephone line Bell of Pennsylvania.
39 Public Square, Wilkes-Barre, Pa.-18701. Tel.(717)824-3513
- - - Sewer line Redevelopment Authority of Luzerne County
104 West Main Street, Plymouth, Pa.-18651. Tel.(717)779-9505




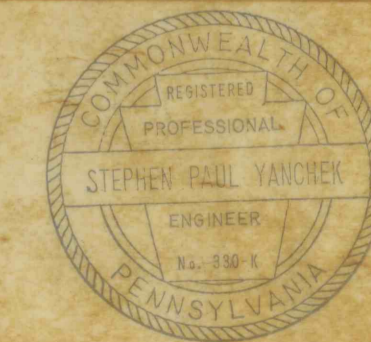
LEGEND -

- exploratory boreholes already drilled.
- ⊙ injection holes to be drilled.

**PLYMOUTH BORO FLUSHING PROJECT
ASP-16
SITE PLAN**



LOCATION MAP
NOT TO SCALE

| | | |
|---|---|-------------------|
| 1-19 79 | ⊙ Relocated or Additional ⊙ Deleted Borehole | <i>SP</i> |
| NO. DATE | REVISION | APPR. |
| SUBMITTED | | |
| <i>Stephen P. Zarnoch, P.E.</i> DISTRICT ENGINEER - ANTHRACITE REGION | | |
| APPROVED | | |
| <i>F. E. Kyle, Jr.</i> DIRECTOR - STATE RESOURCES MANAGEMENT | | |
|   | | |
| COMMONWEALTH OF PENNSYLVANIA DEPARTMENT OF ENVIRONMENTAL RESOURCES OFFICE OF RESOURCES MANAGEMENT | | |
| PROJECT NO. ASP-16 | | |
| FILLING MINE VOIDS | | |
| SHAWNEE AVENUE AREA, PLYMOUTH BORO, LUZERNE COUNTY, PENNA. ABANDONED NOTTINGHAM COLL'Y SURFACE | | |
| DRAWN BY | DATE | DRAWING NO. |
| CHECKED BY | SCALE | |
| 1" = 100' | | ASP 16-1.1 |