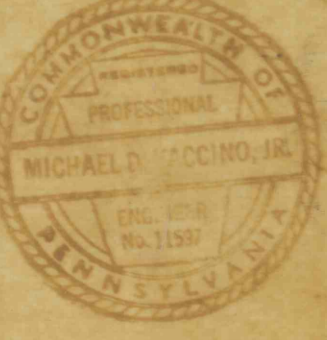
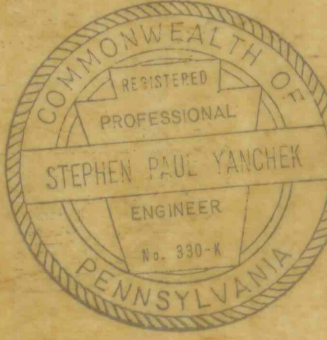


**LEGEND -**

- exploratory boreholes already drilled.
- injection holes to be drilled.

1-19 79	Relocated or Additional	
	Deleted Borehole	
NO. DATE	REVISION	BY
Stephen P. Zanechak, P.E. <i>(Signature)</i> S. E. Kyle, Jr. <i>(Signature)</i>		
 		
COMMONWEALTH OF PENNSYLVANIA DEPARTMENT OF ENVIRONMENTAL RESOURCES OFFICE OF RESOURCES MANAGEMENT		
<b>PROJECT NO. A.SP. 16</b>		
<b>FILLING MINE VOIDS</b>		
SHAWNEE AVENUE AREA, PLYMOUTH BORO, LUZERNE COUNTY, PENNA.		
ABANDONED NOTTINGHAM COLLIERIES FIVE FOOT VEIN		
CHECKED BY	DATE	SCALE
		1" = 100'
		ASP 16-1.3