Clark Vein

NATIONAL MIDDLE SECTION
CLARK VEIN
SLIDE-11-1
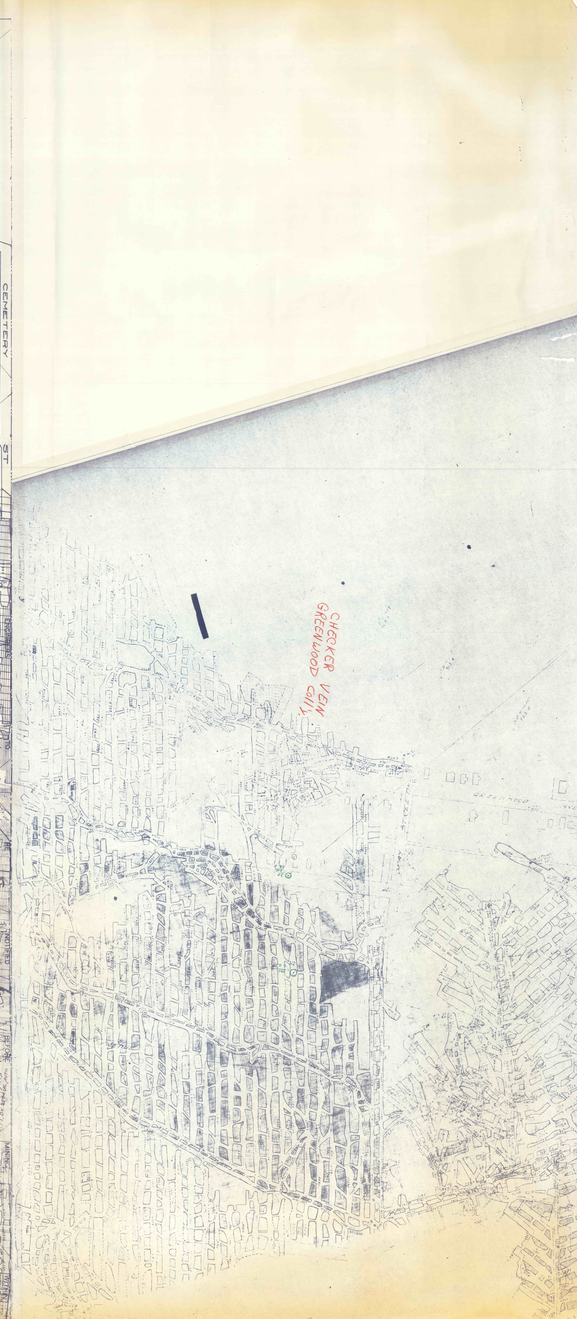
-NATIONAL MIDDLE SECTION-
CLARK VEIN
SLIDE - 11-2