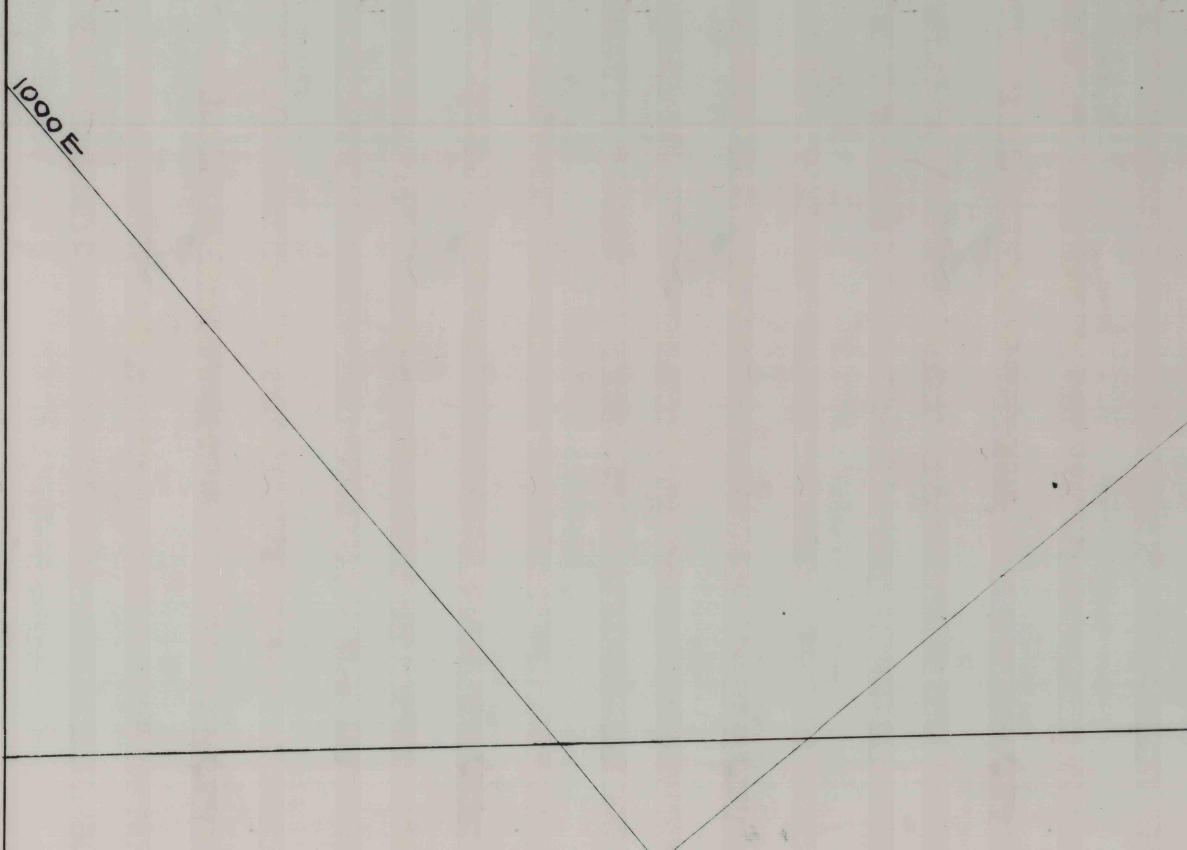
1000E

NATION

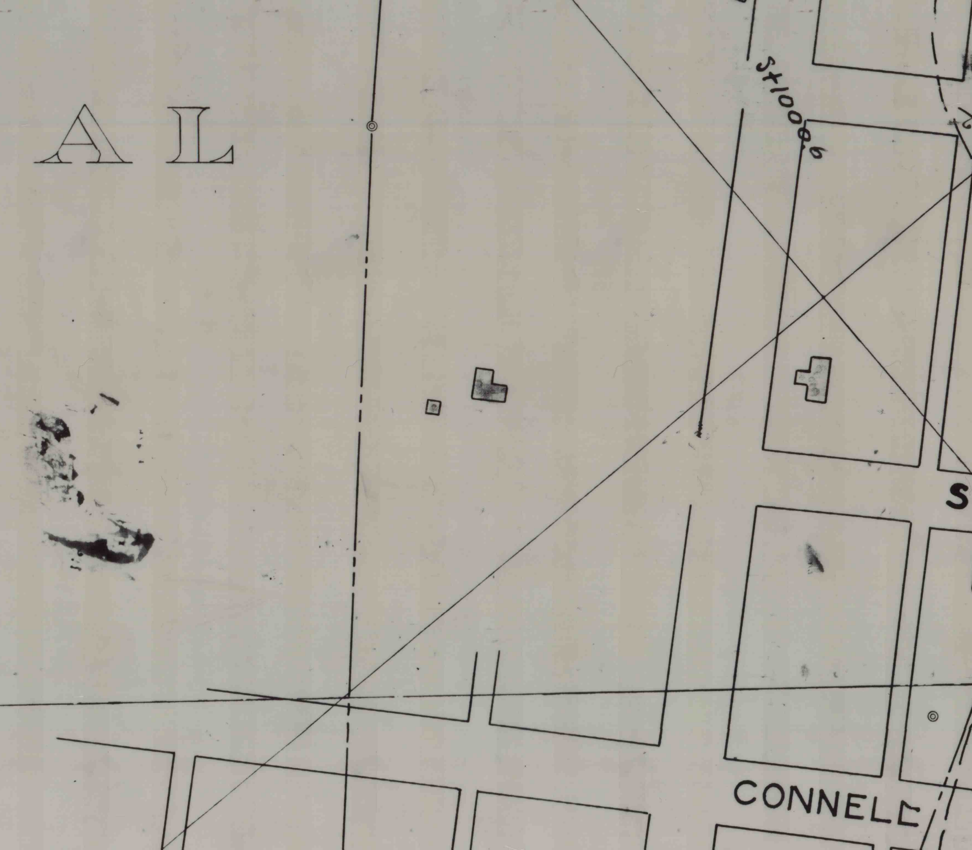
A L
5+100.6
S
CONNELL

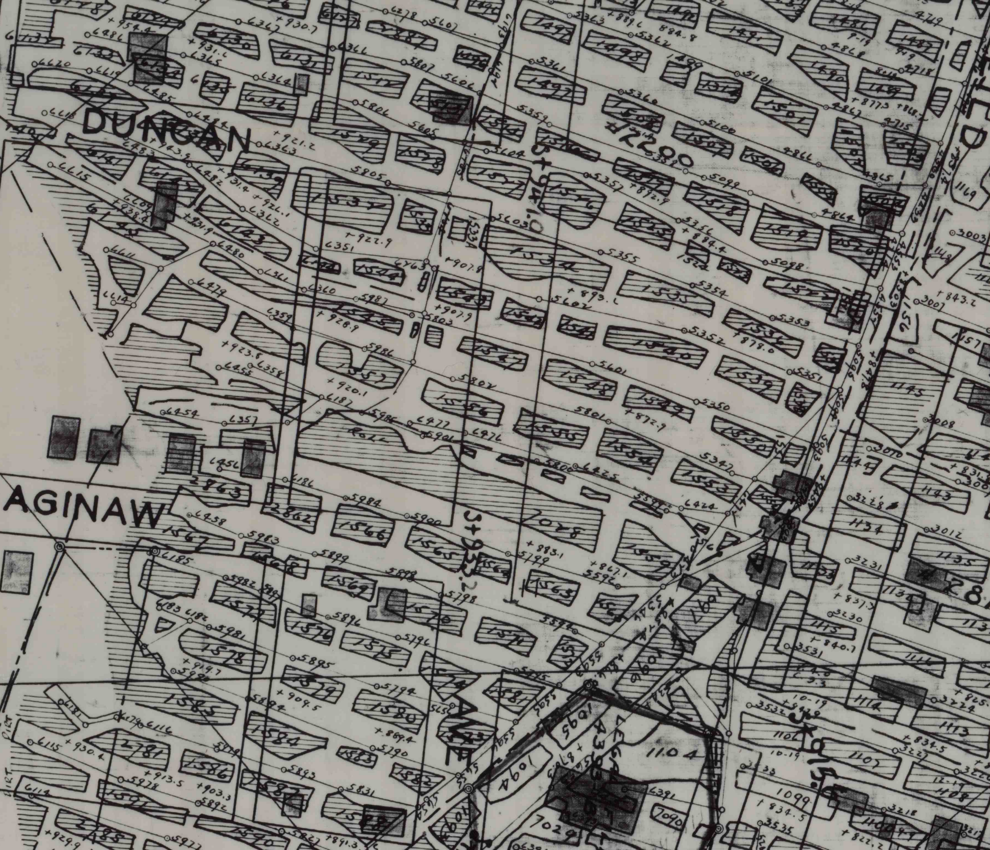
DUNCAN
AGINAW
AVE
D
5+942.0
5+932.2
5+915.6
+6200
1534
1537
1566
2862
2863
1567
1585
1586
1094
1095
1104
7029
7090
1145
1143
1169
1157

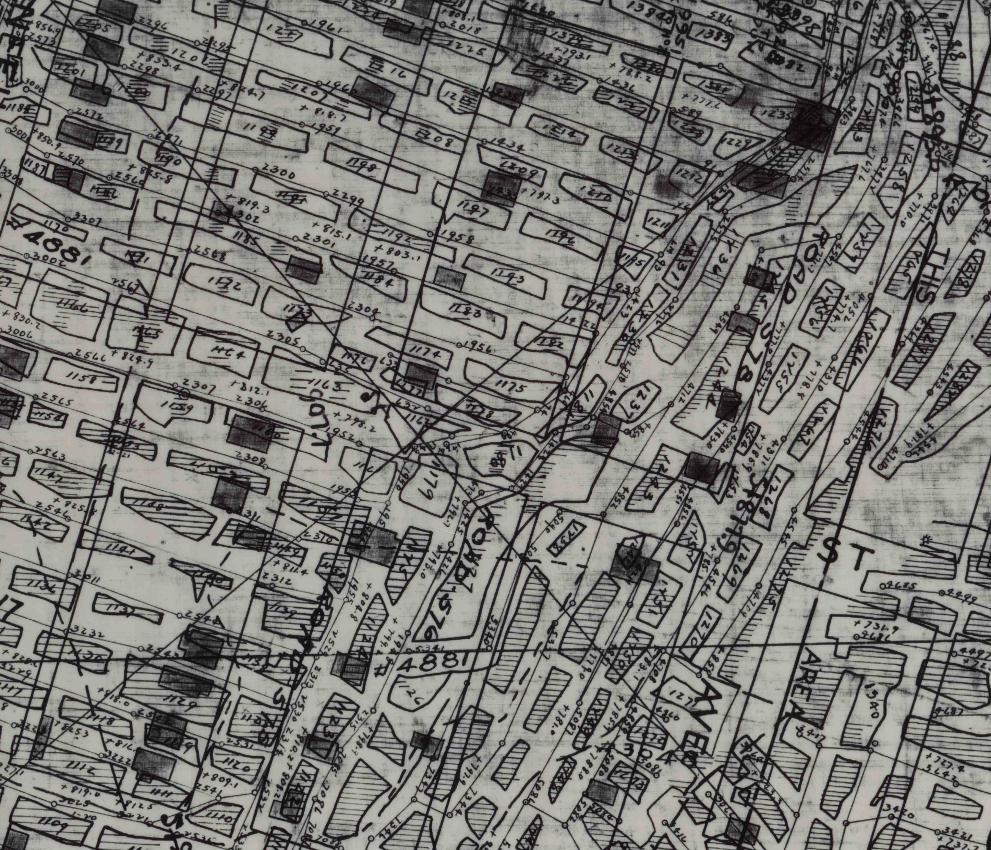
4881
ROAD 579
4881
ST
AREA
ROAD
1175
1174
1183
1184
1192
1193
1196
1197
1198
1209
1210
1212
1213
1214
1216
1225
1229
1235
1160
1159
1158
1164
1165
1166
1172
1148
1141
1140
1136
1137
1129
1118
1112
1109
1110
1120
1123
1240
1243
1249
1253
1255
1257
1262
1264
1270
1271
1540
3048
1388
1398
1383
1382

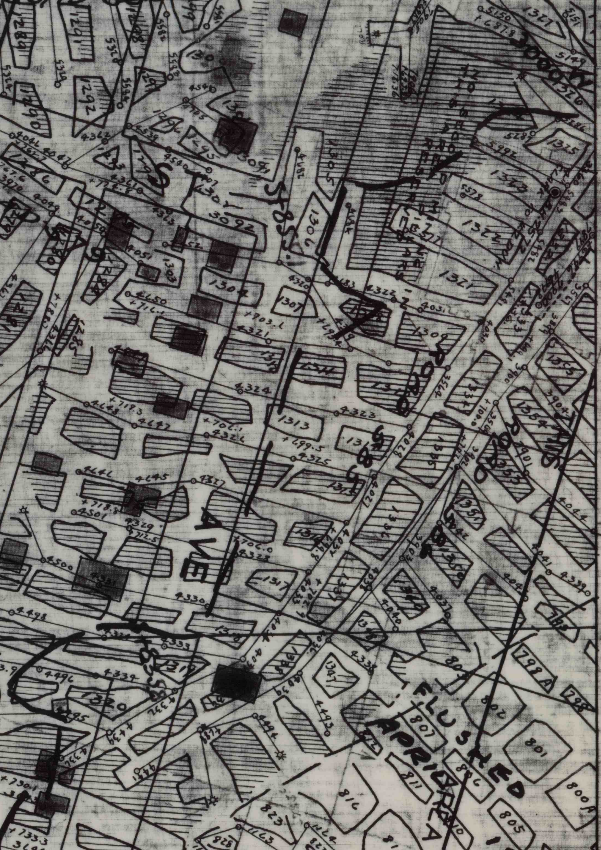

ST
AVE
FLUSHED
APRIL AREA
1313
1322
1321
1325
1320
801
805
807
811