


158B-5

CLARK VEIN  
SLIDE 10-1

CLARK VEIN  
SLIDE 10-1

LACKAWANNA STATION SECTION  


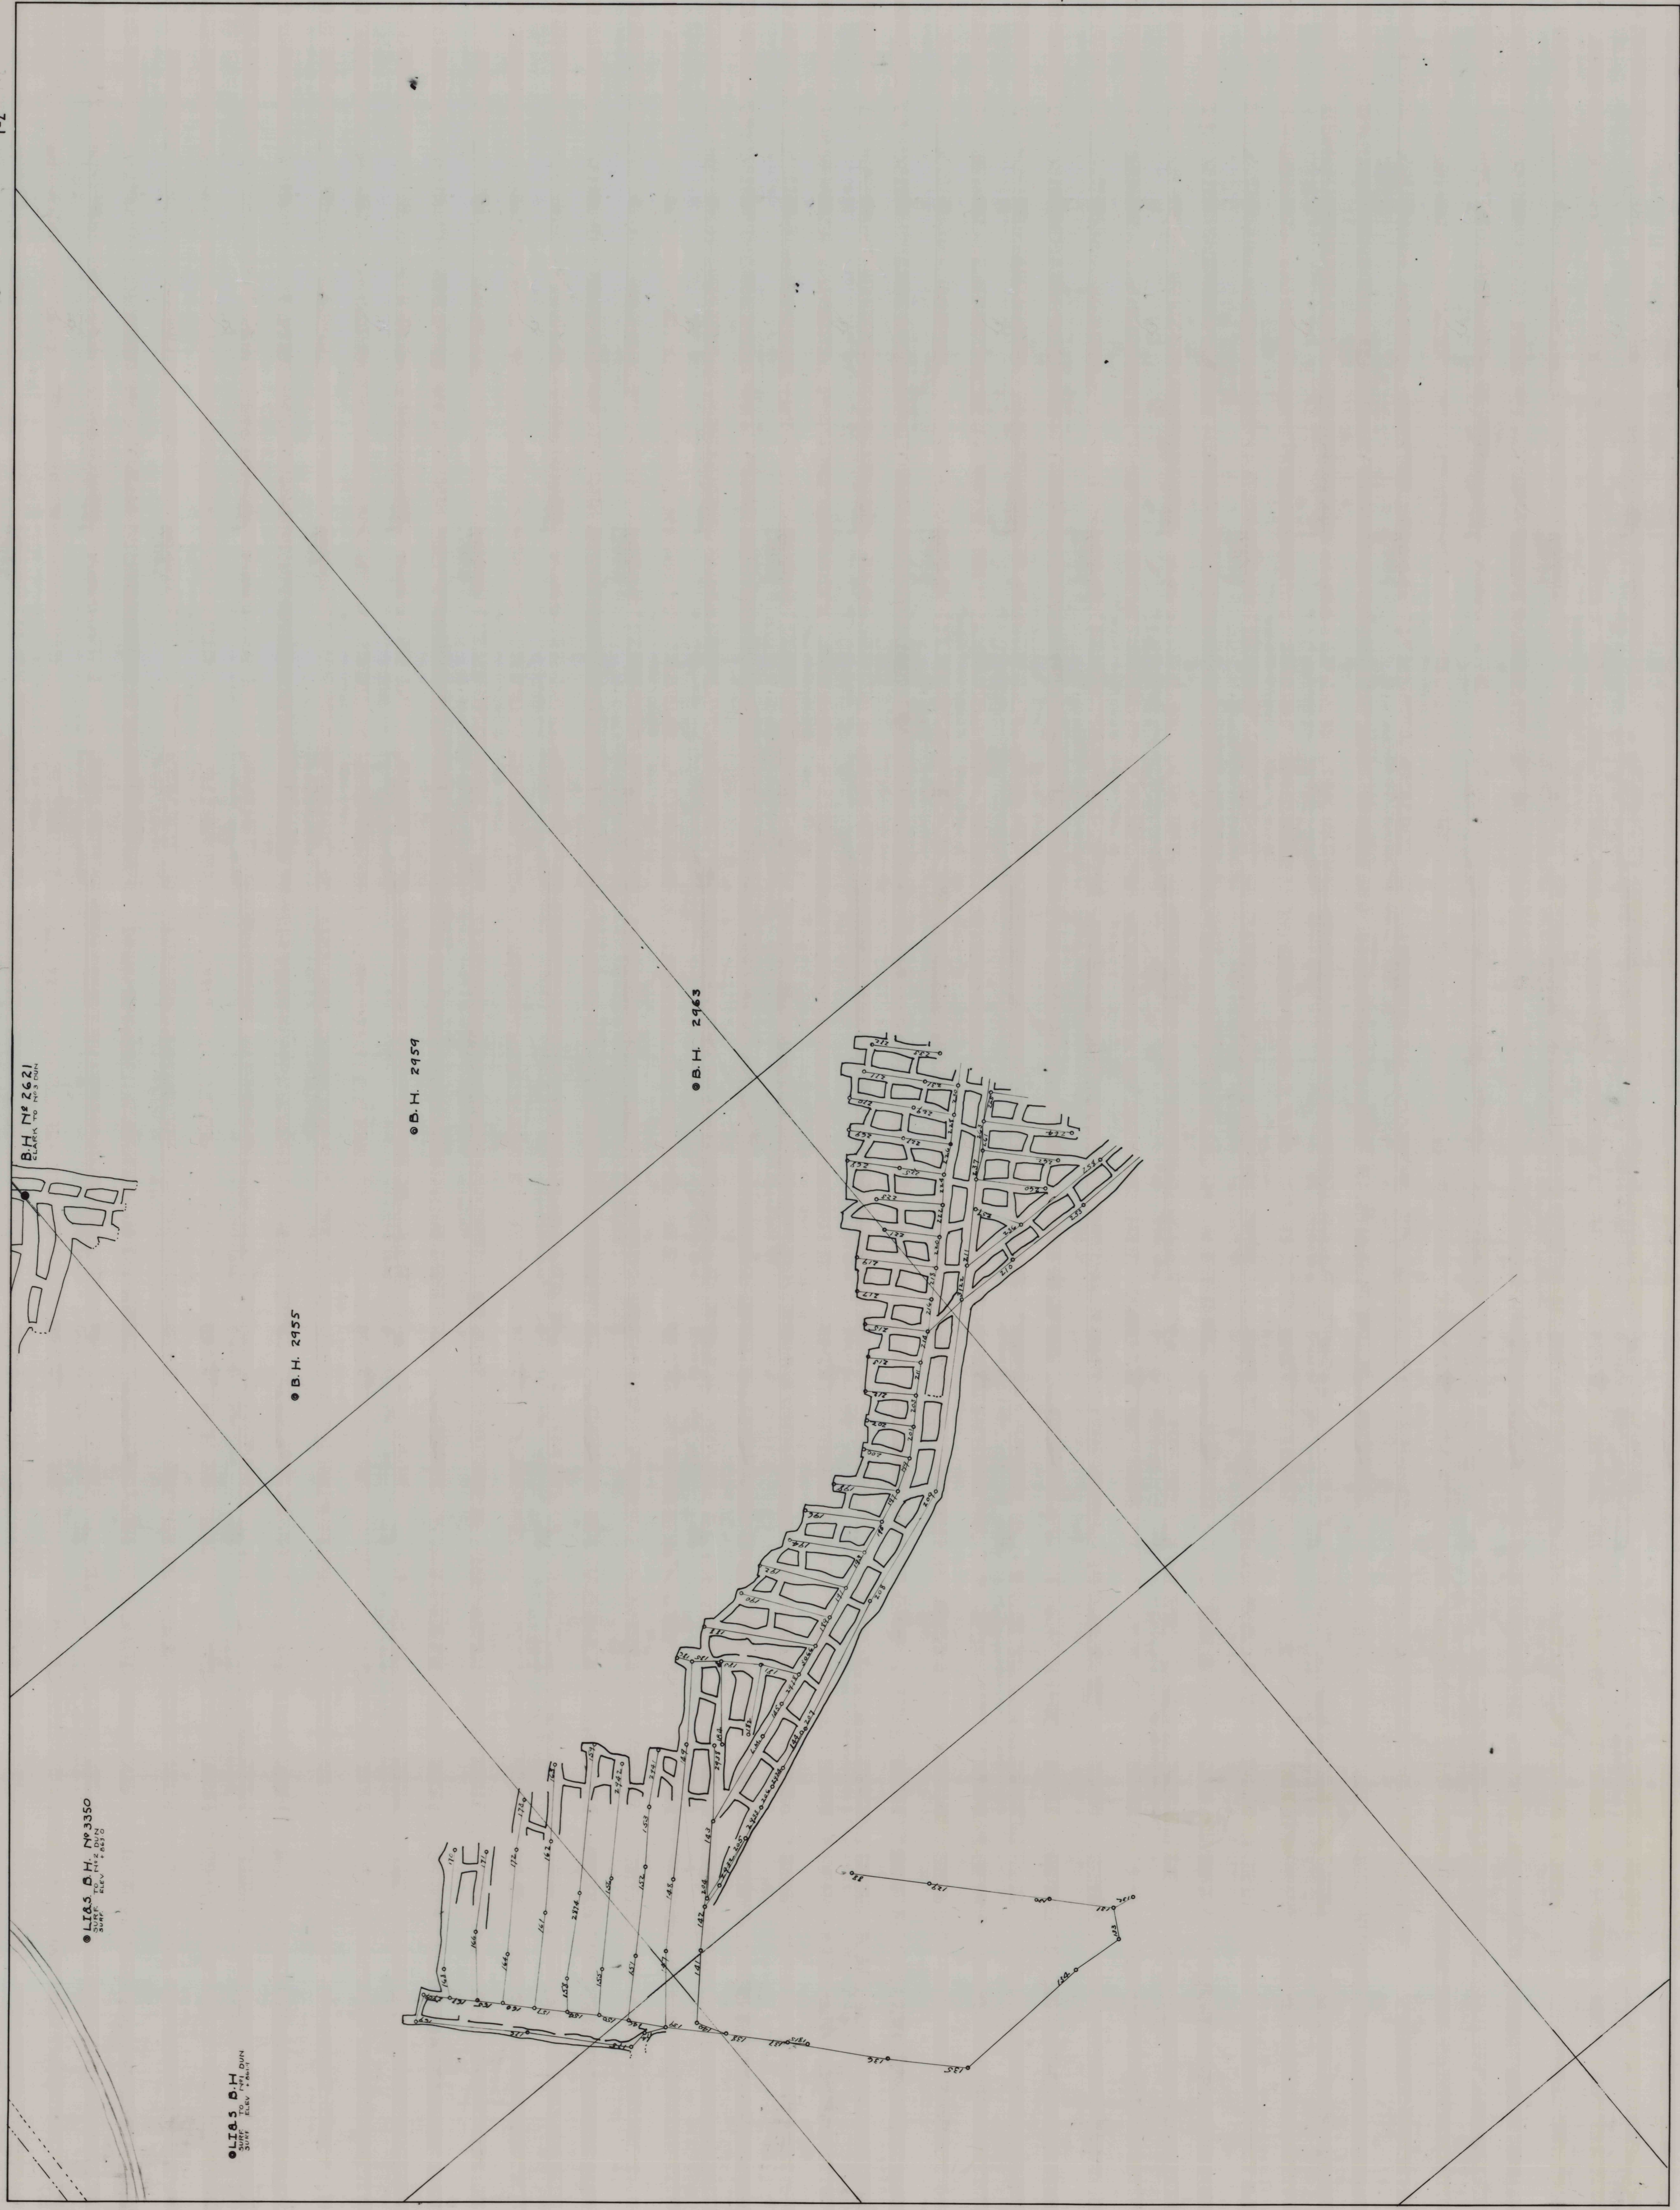



158B-5