WANAMIE COLLIERY
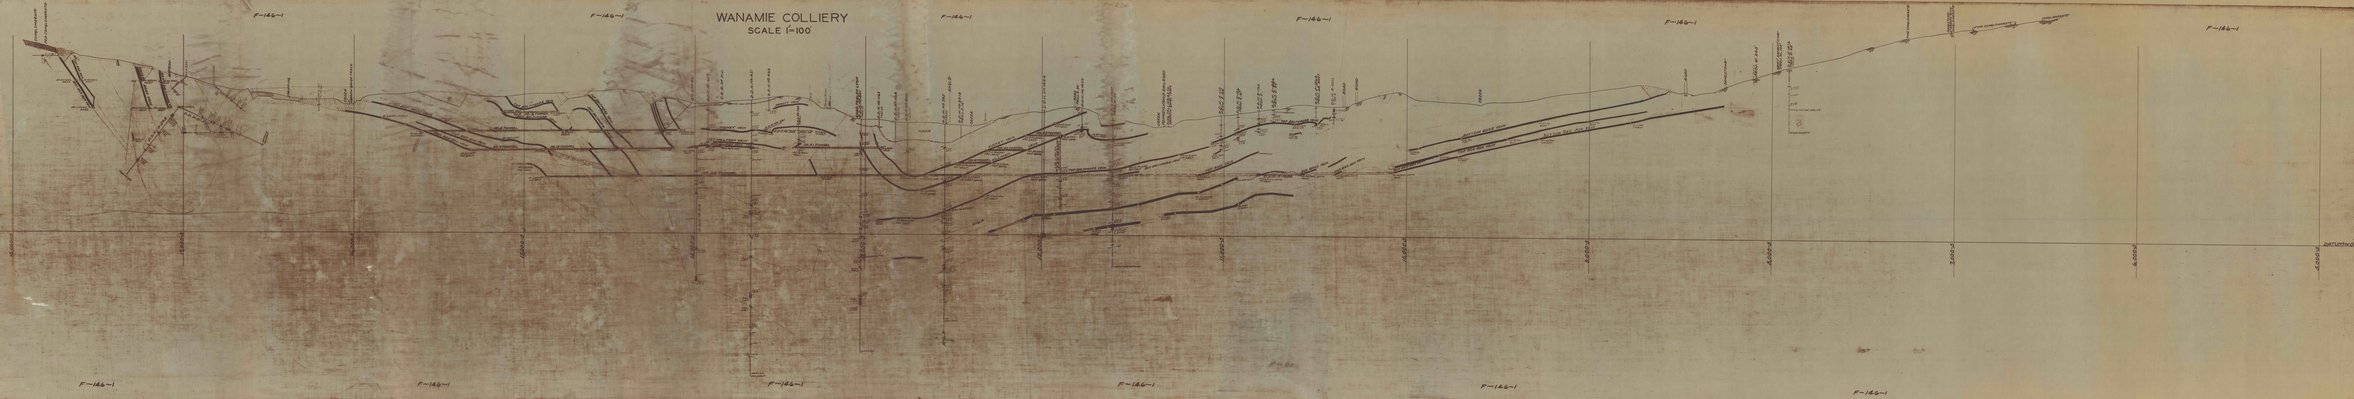
SCALE 1"=100'