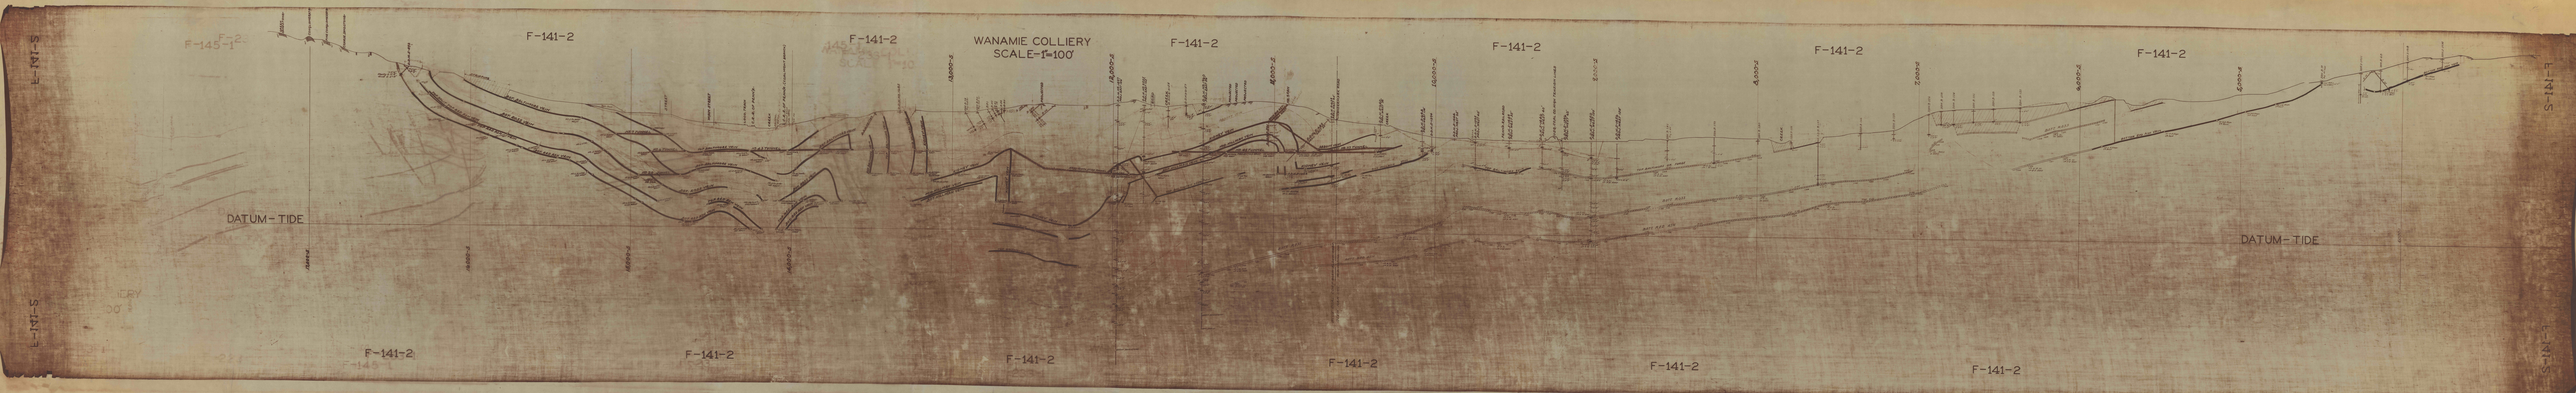
WANAMIE COLLIERY
SCALE-1"=100'
F-141-2
F-145-1
DATUM-TIDE
DATUM-TIDE
L-141-S
S-141-S