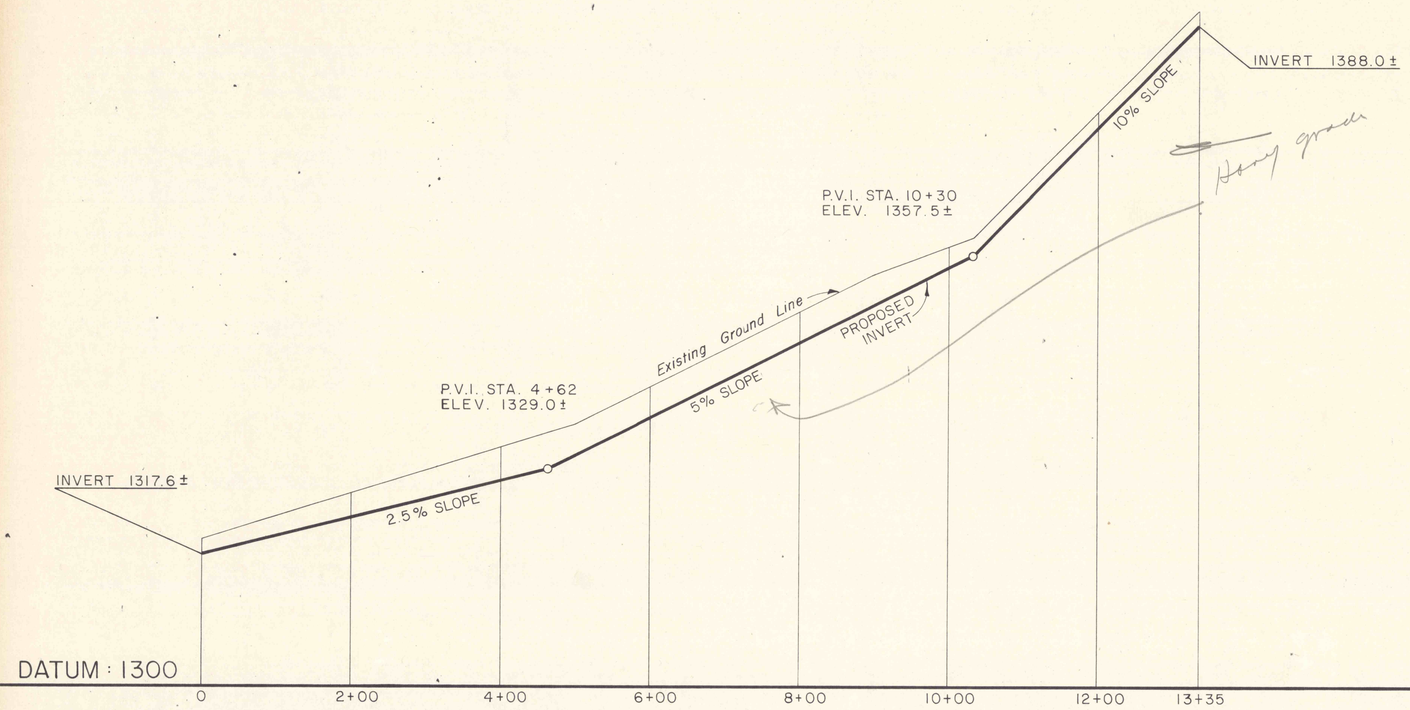

NORTHEAST DIVERSION DITCH OF WEST FLUME

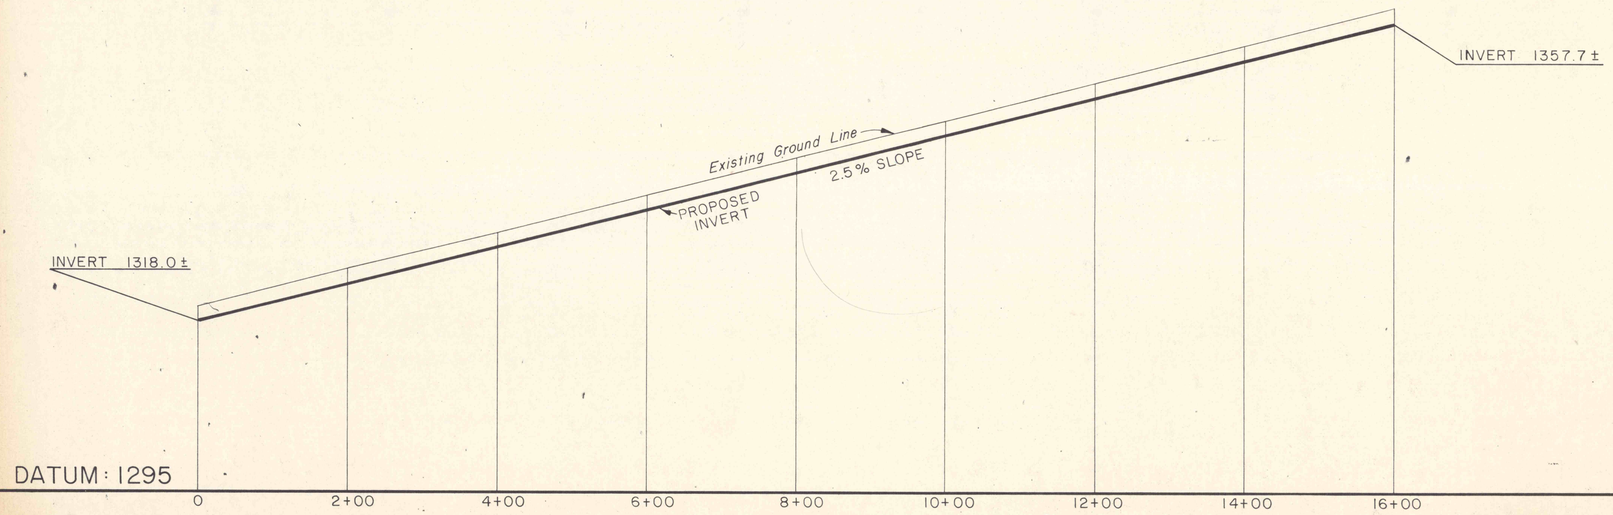

NORTHWEST DIVERSION DITCH OF WEST FLUME

NO	DATE	REVISION	APPR.

SUBMITTED

PROFESSIONAL

APPROVED

CHIEF - DIVISION OF MINE RECLAMATION

APPROVED

DIRECTOR - BUREAU OF DESIGN

COMMONWEALTH OF PENNSYLVANIA
DEPARTMENT OF ENVIRONMENTAL RESOURCES
OFFICE OF RESOURCES MANAGEMENT

PROJECT NO. SL 113-5-1

MINE DRAINAGE POLLUTION ABATEMENT
COAL RUN
SHAMOKIN CREEK WATERSHED
NORTHUMBERLAND COUNTY, PA.

ERDMAN, ANTHONY, ASSOCIATES
Consulting Engineers
Camp Hill, Pa. Rochester, N.Y.

PROFILES

DRAWN BY	DATE	DRAWING NO.
GMS		8 of 26
CHECKED BY	SCALE 1" = 10' VERT. 1" = 100' HOR.	

BRUNING 44-142 25788