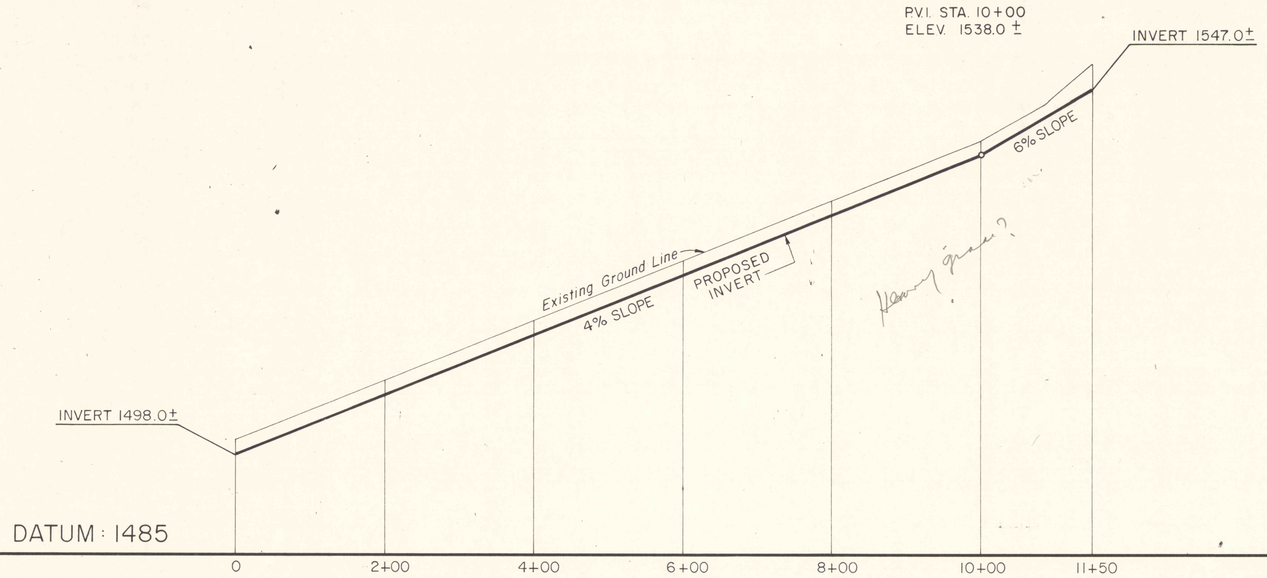

NORTHWEST DIVERSION DITCH OF EAST FLUME

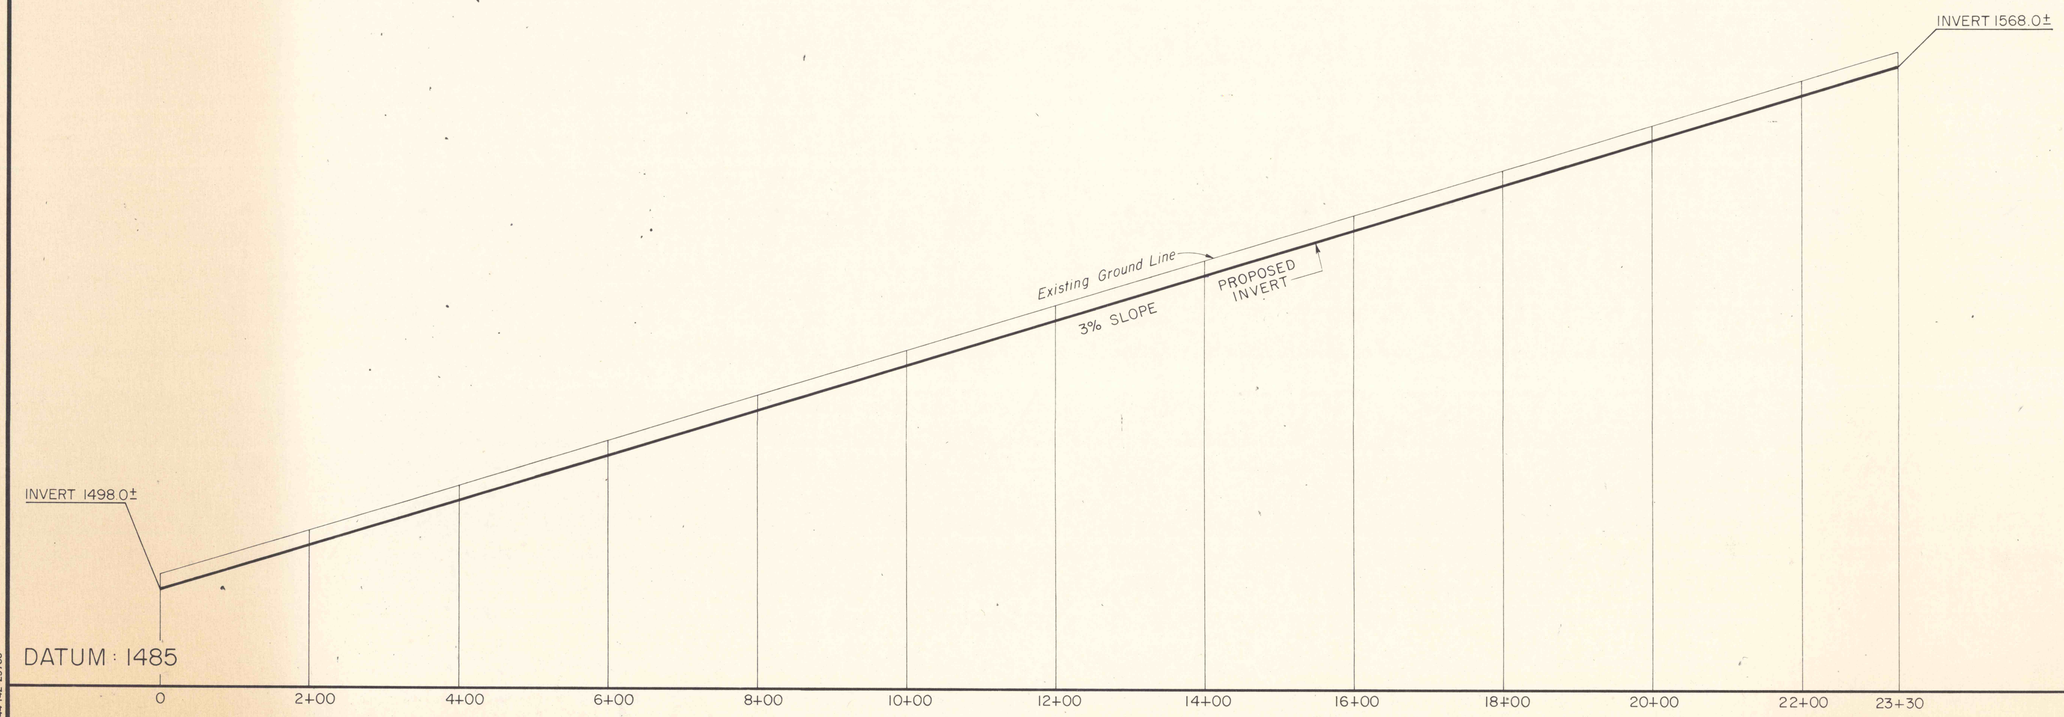

NORTHEAST DIVERSION DITCH OF EAST FLUME

NO	DATE	REVISION	APPR.

SUBMITTED

PROFESSIONAL

APPROVED

CHIEF - DIVISION OF MINE RECLAMATION

APPROVED

DIRECTOR - BUREAU OF DESIGN

COMMONWEALTH OF PENNSYLVANIA
DEPARTMENT OF ENVIRONMENTAL RESOURCES
OFFICE OF RESOURCES MANAGEMENT

PROJECT NO. SL 113-5-1

MINE DRAINAGE POLLUTION ABATEMENT
COAL RUN
SHAMOKIN CREEK WATERSHED
NORTHUMBERLAND COUNTY, PA.

ERDMAN, ANTHONY, ASSOCIATES
Consulting Engineers
Camp Hill, Pa. Rochester, N.Y.

PROFILES

DRAWN BY	DATE	DRAWING NO.
GMS	SCALE 1"=10' VERT. 1"= 100' HOR.	15 of 26
CHECKED BY		

BRUNING 44-142 25788