




STA. '9+95

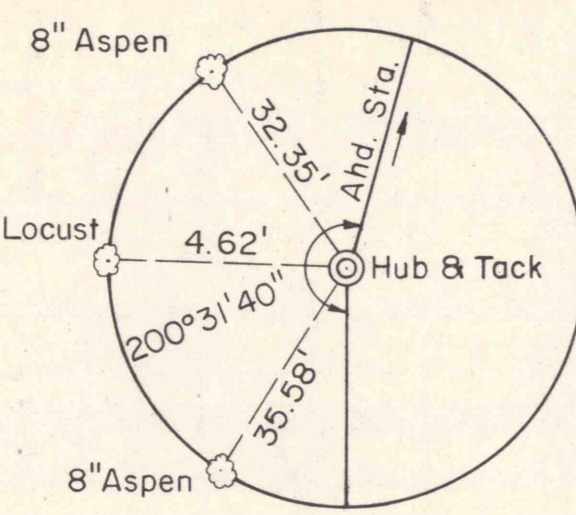


STA. 12+13

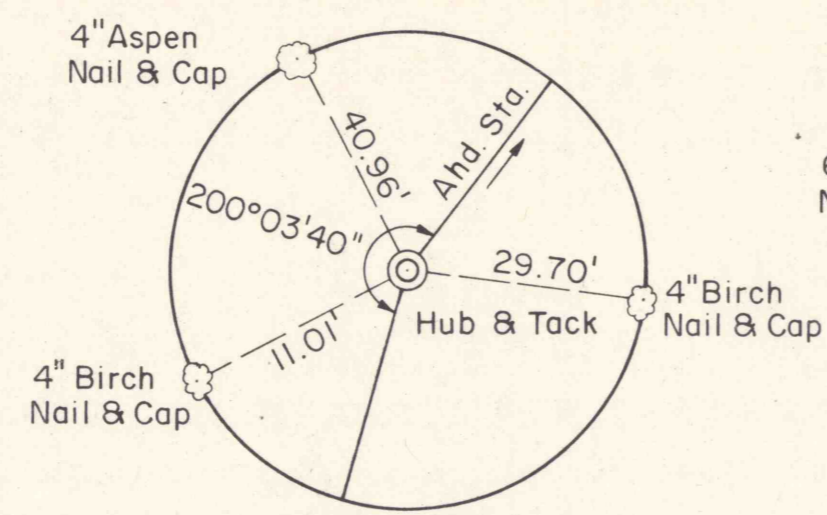


STA. 13+20

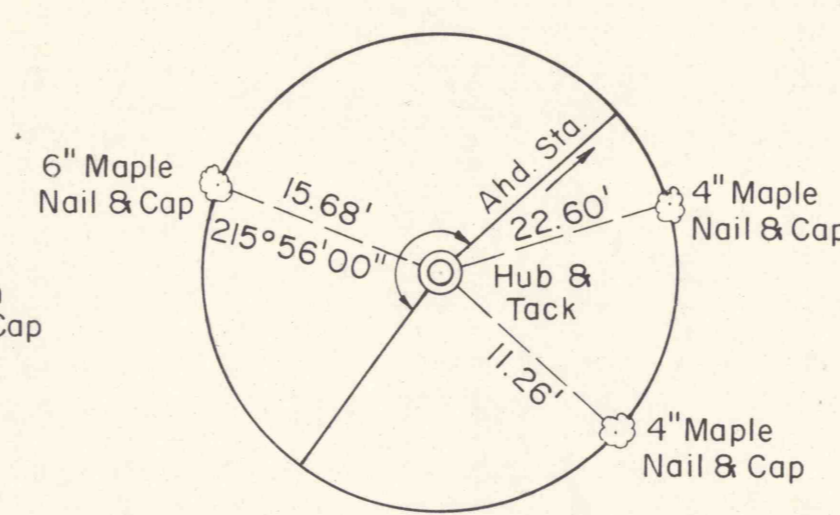


STA. 14+65

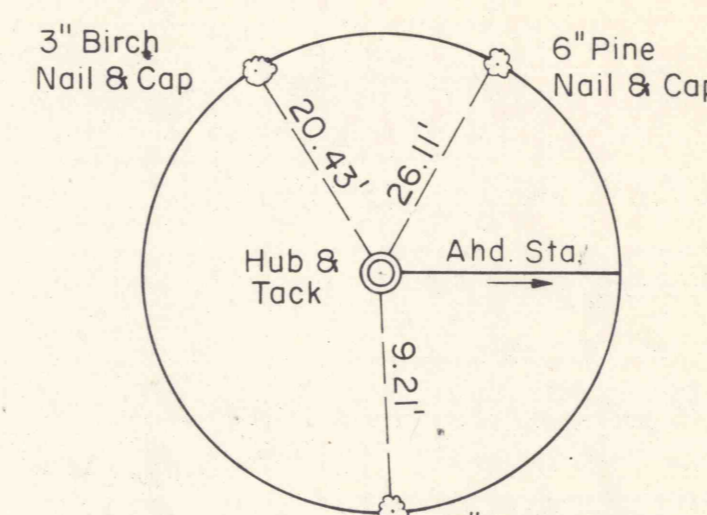


STA. 57+80

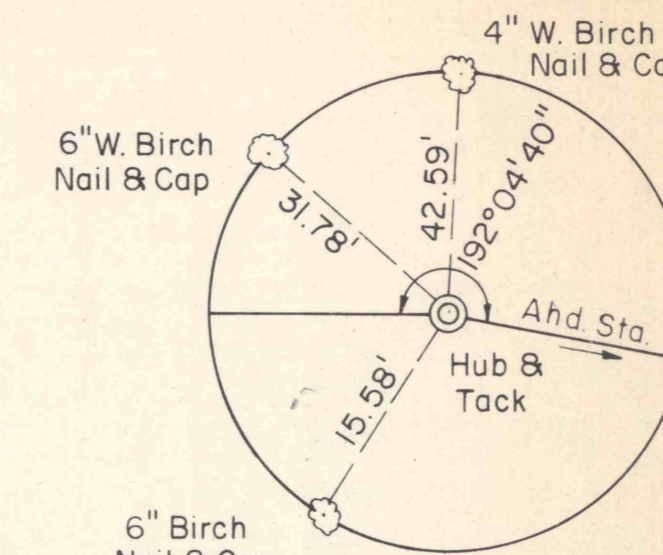


STA. 61+60

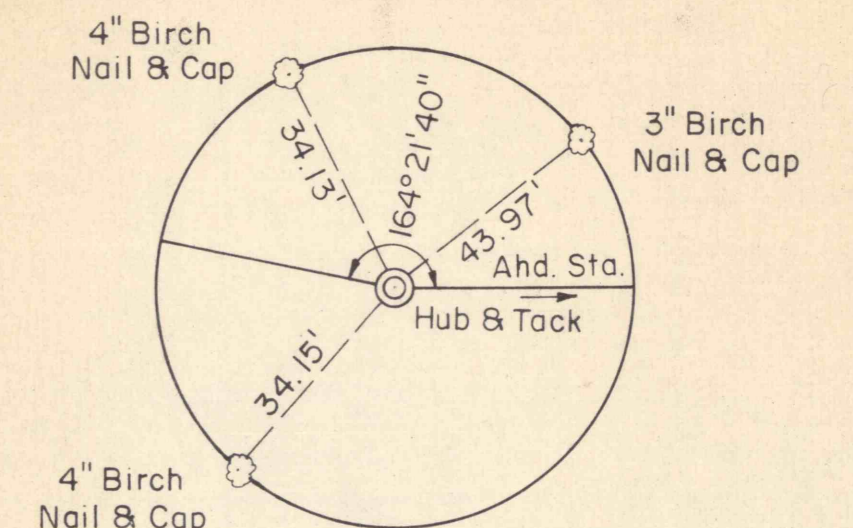


STA. 63+18

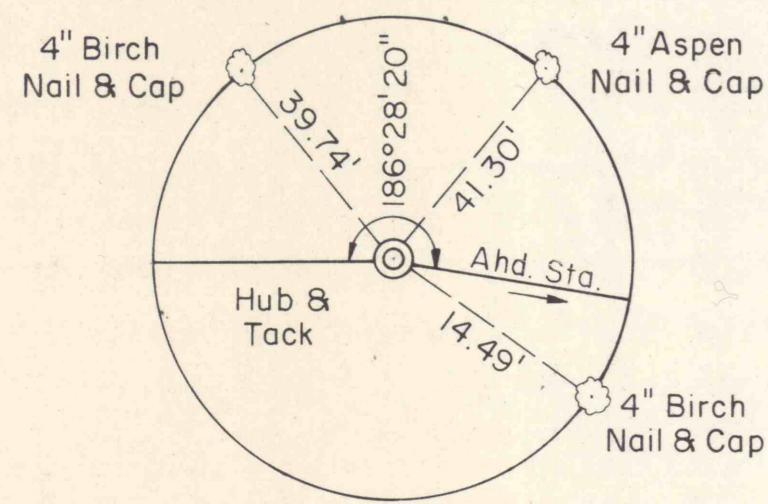


STA. 66+63

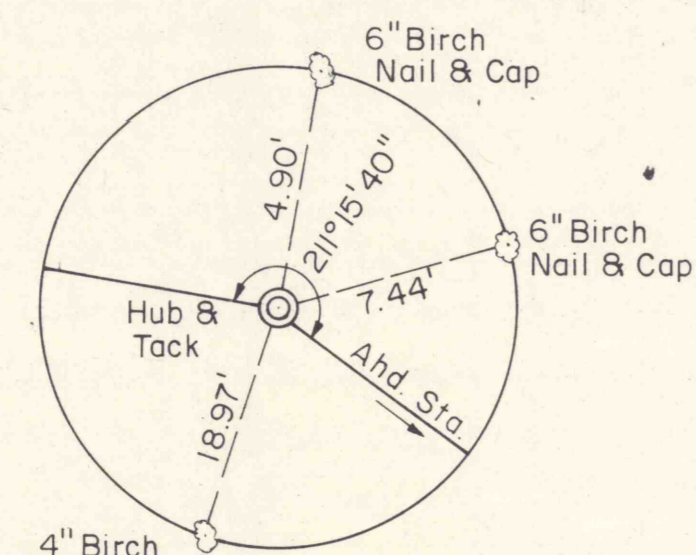


STA. 71+80

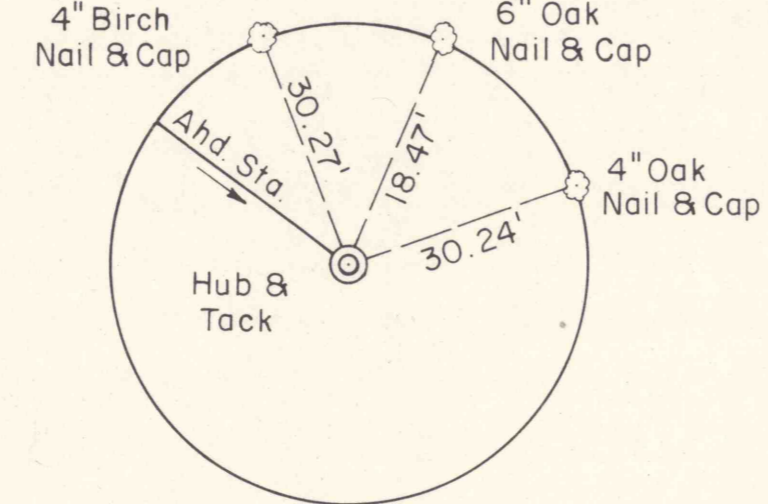


STA. 72+69

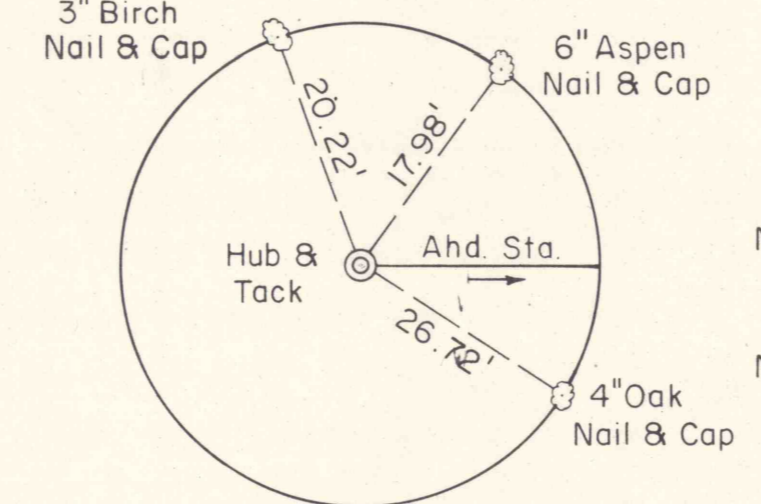


STA. 132+55

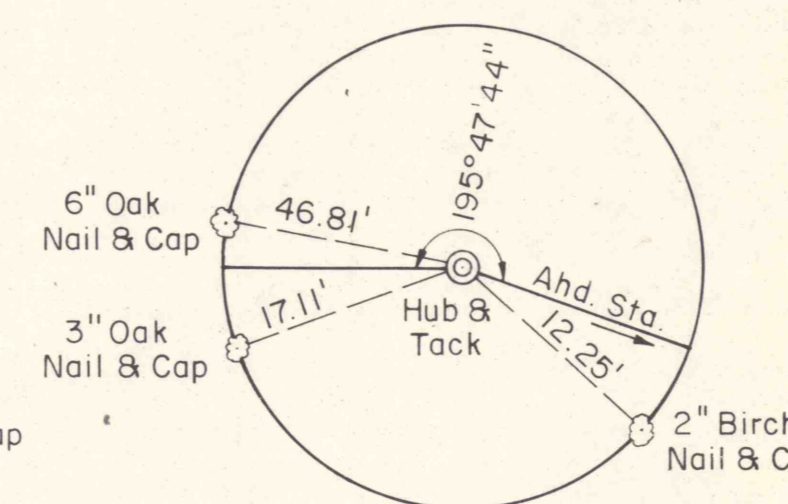


STA. 137+00

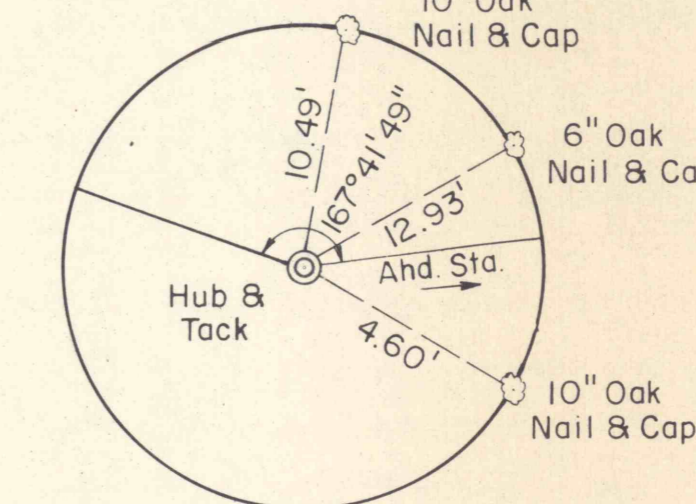


STA. 142+48

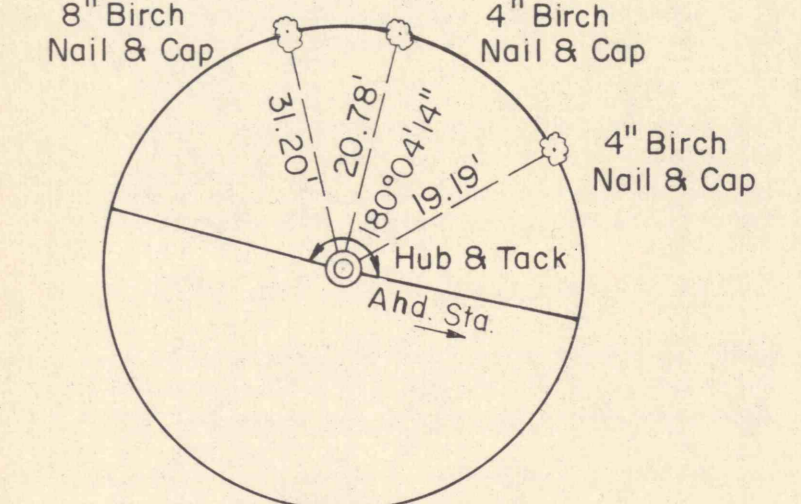


STA. 147+48

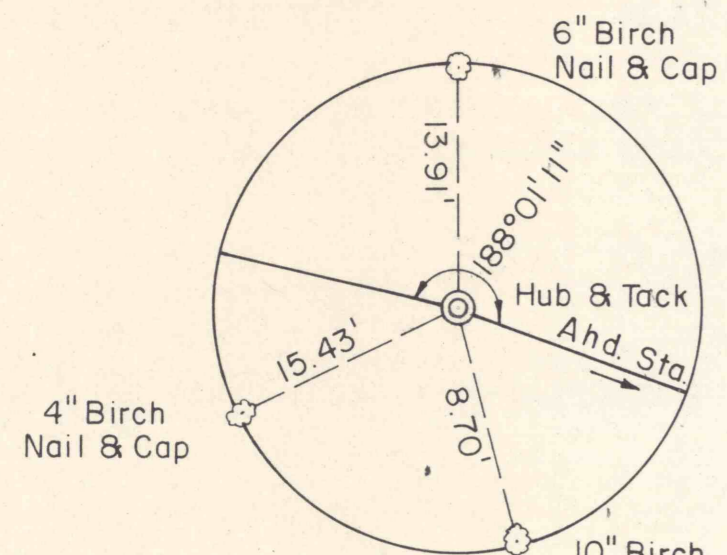


STA. 149+82

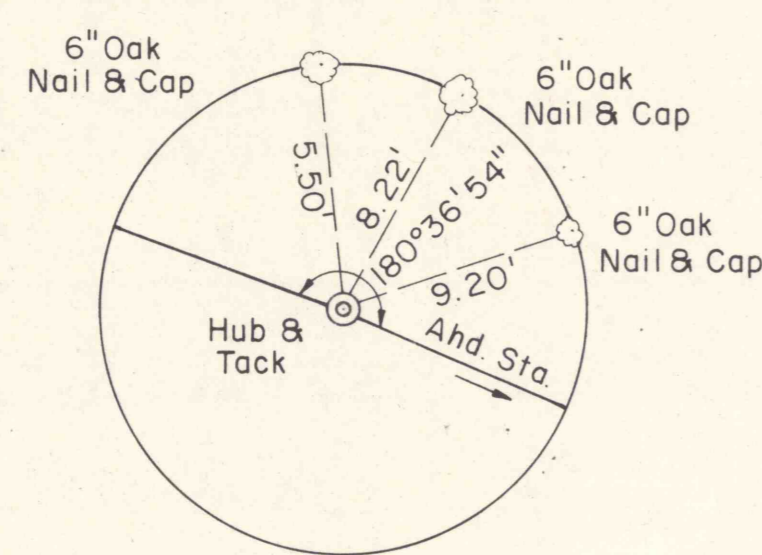


STA. 158+22

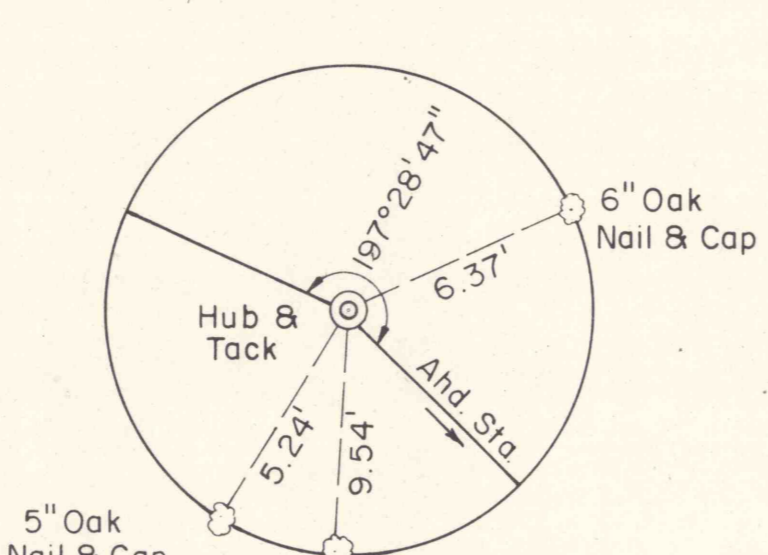


STA. 164+50

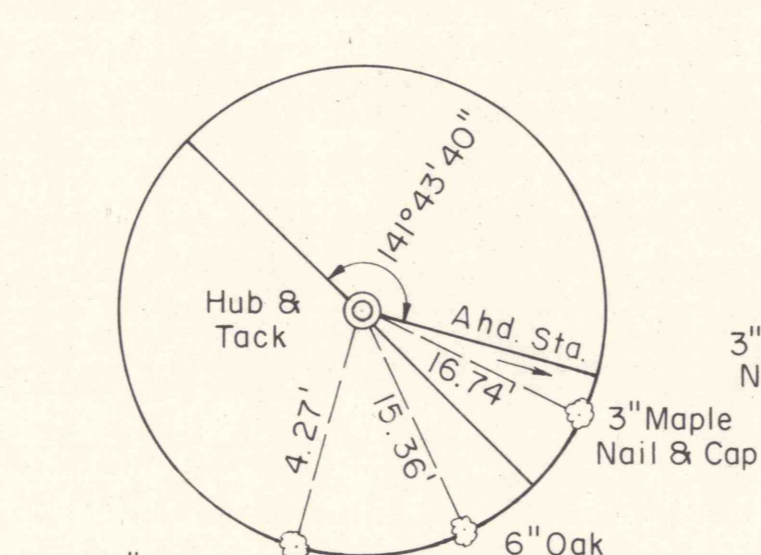


STA. 167+32

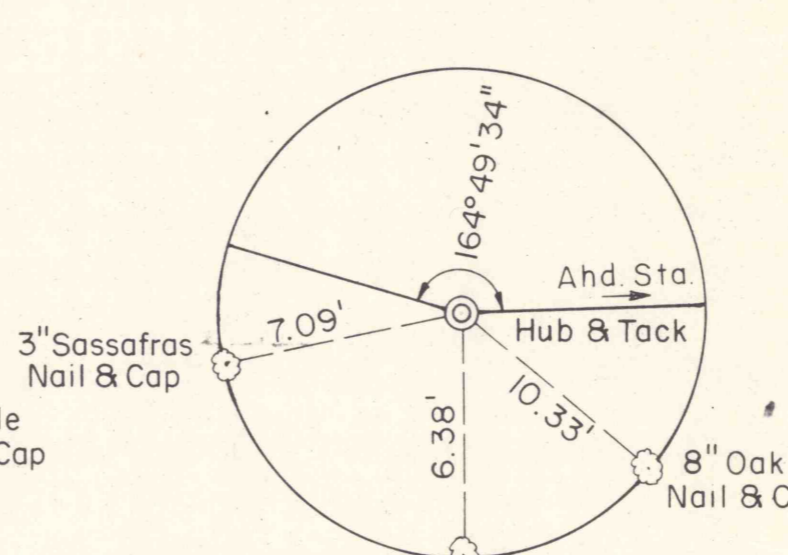


STA. 170+84

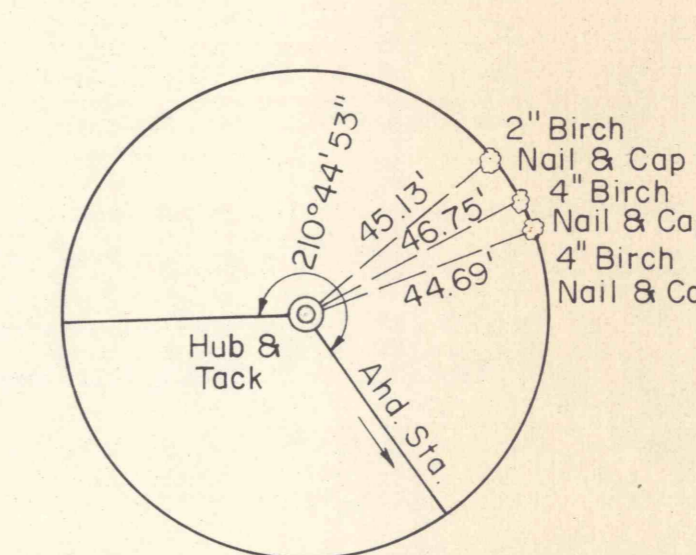


STA. 175+36

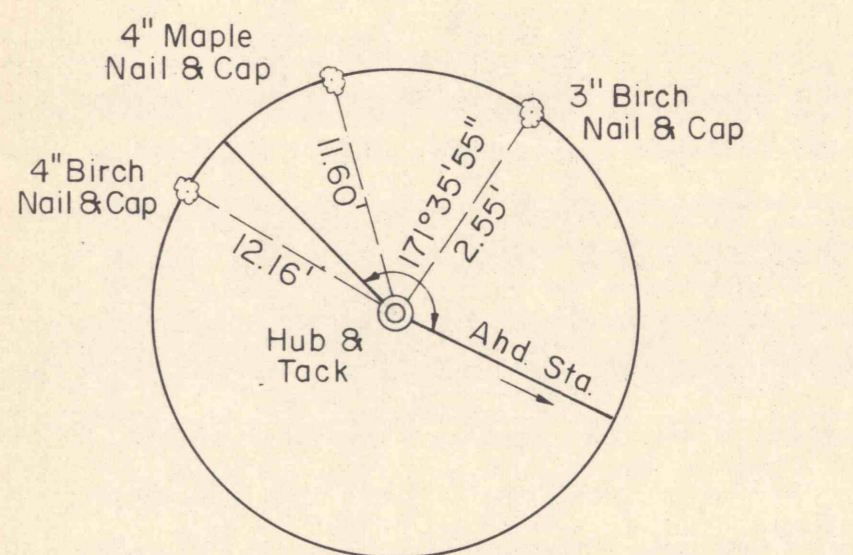


STA. E-3+18

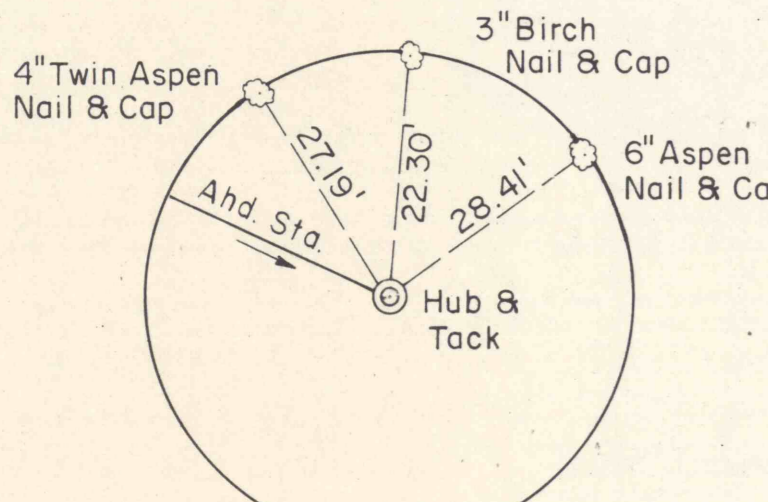


STA. E-7+00

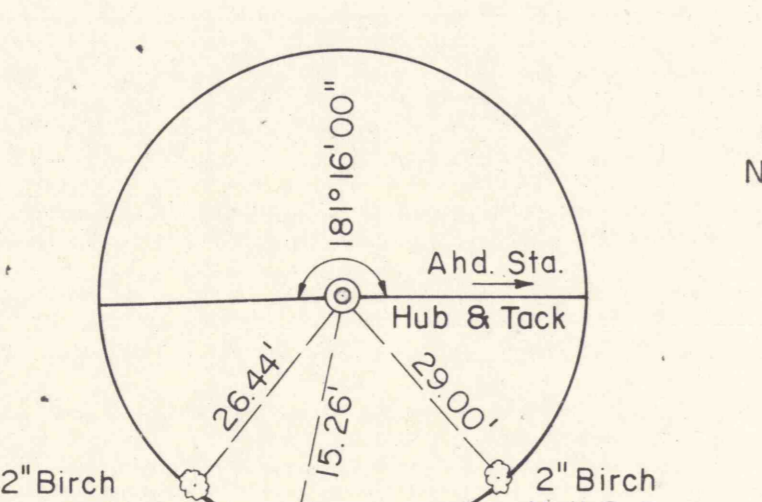


STA. 182+61

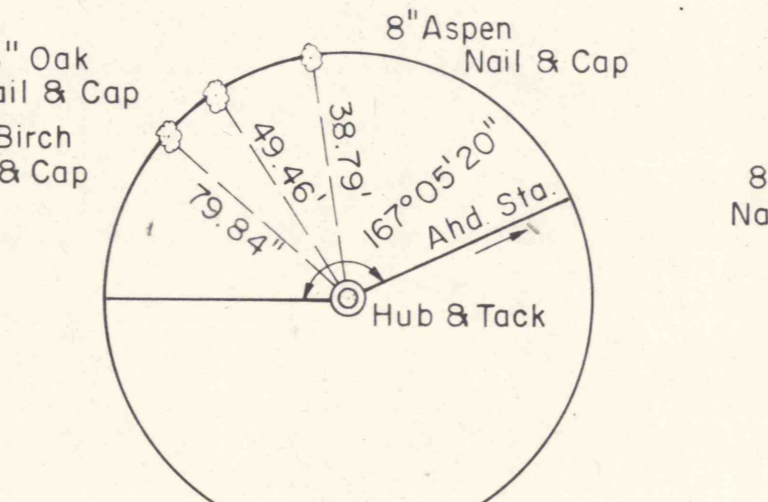


STA. 190+68

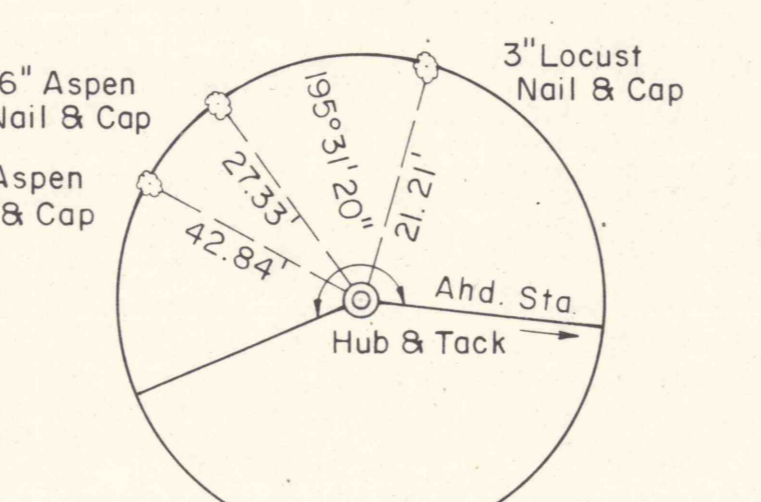


STA. 198+17

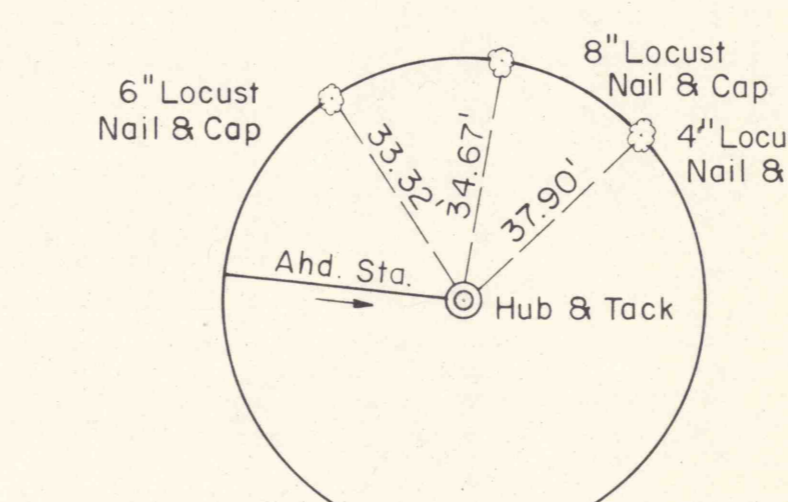


STA. 202+29

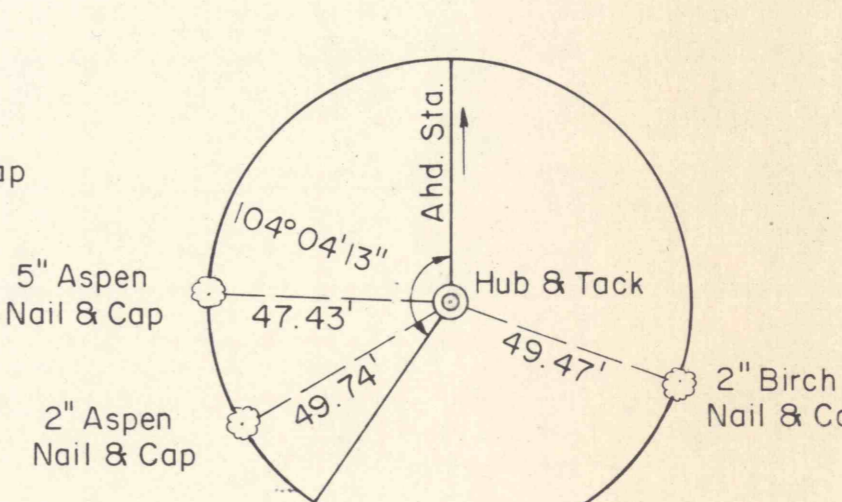


STA. C-4+34.00

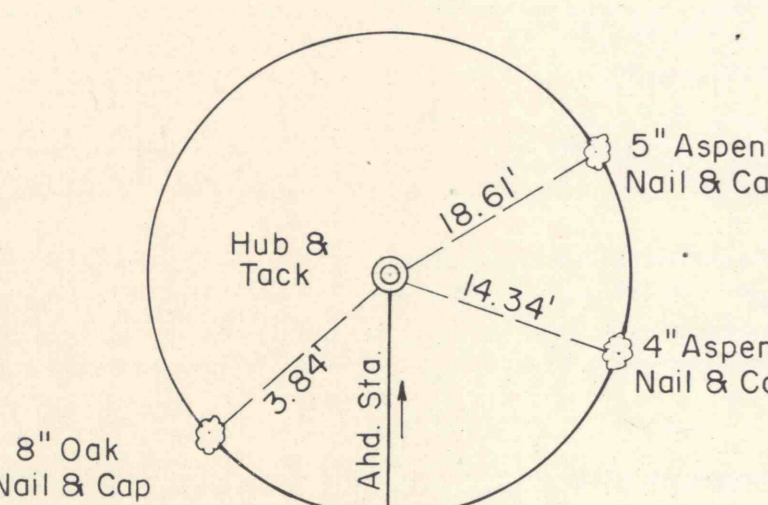


STA. C-8+31.00

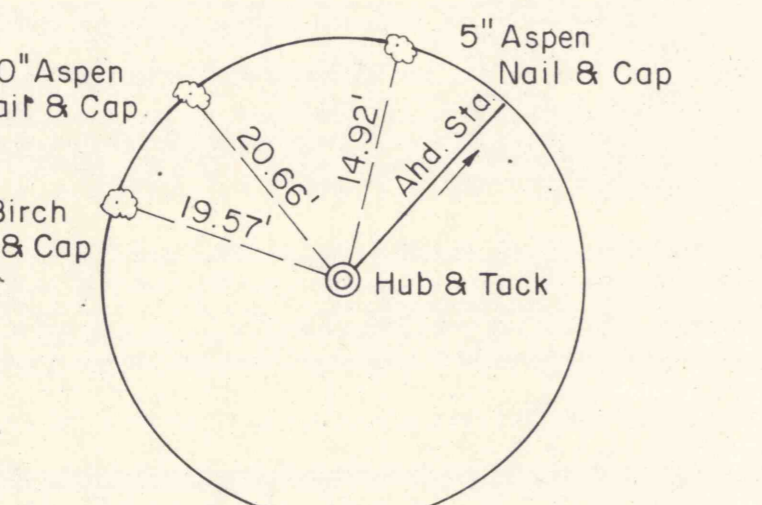


STA. D-0+00.00

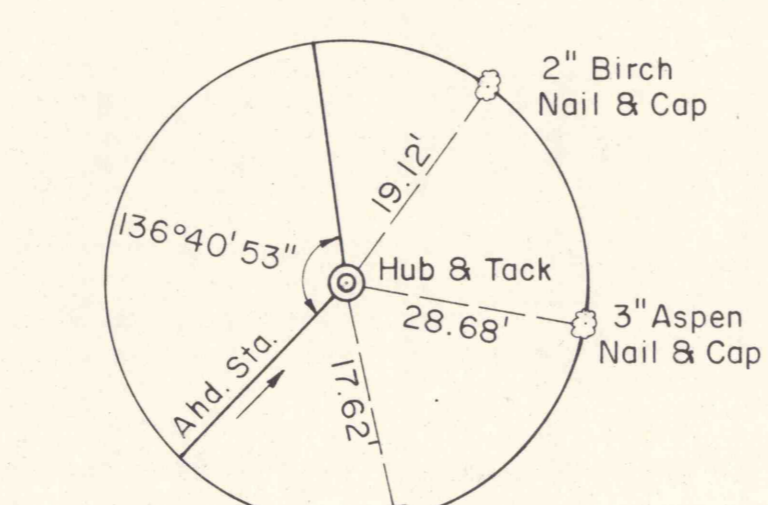


STA. D-6+52.58

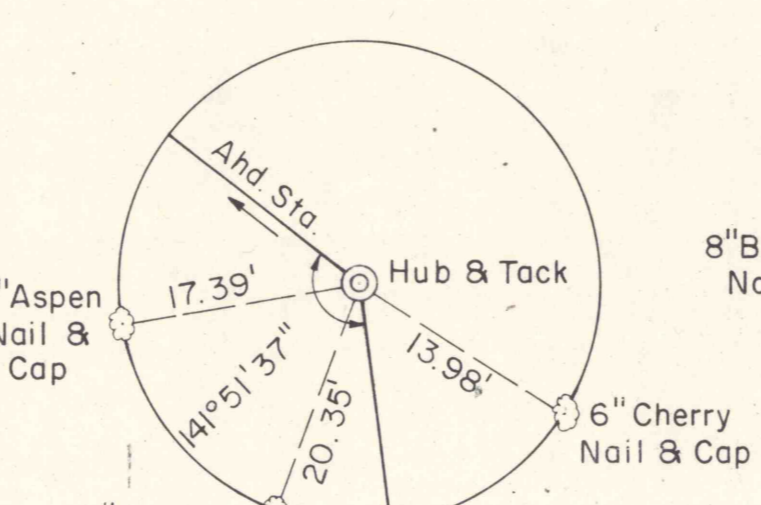

STA. D-8+83.18

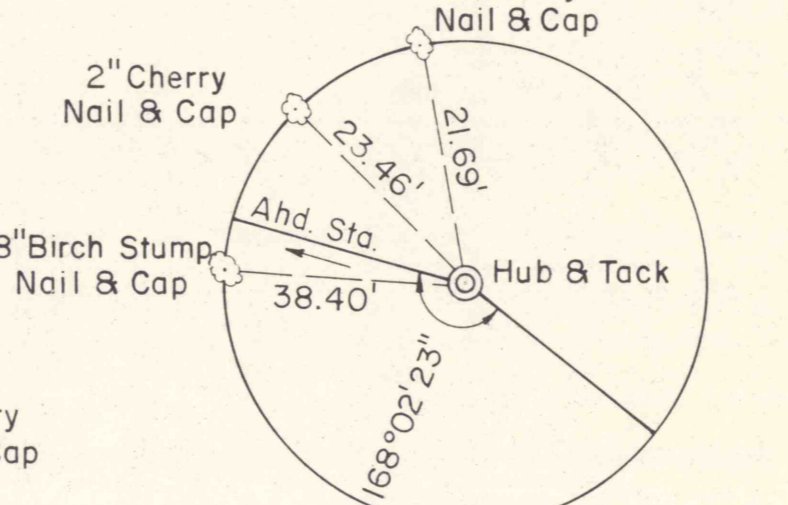

STA. D-12+66.51

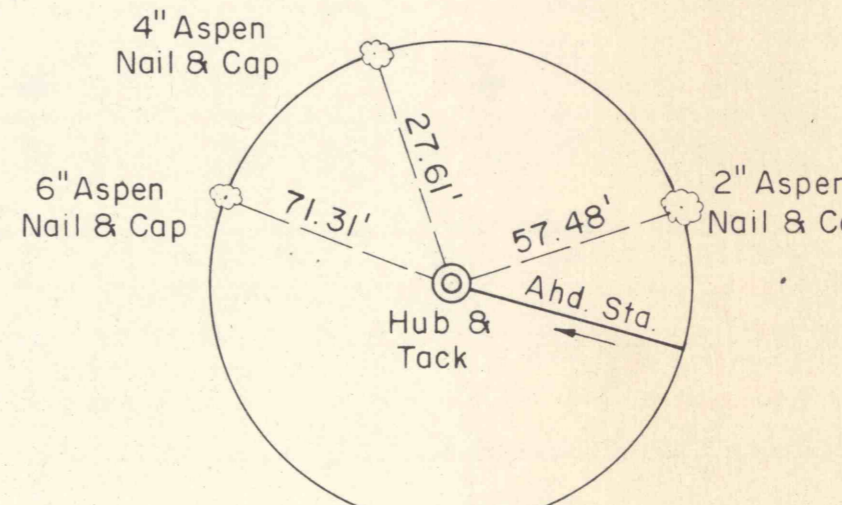

STA. D-17+51.22

NO	DATE	REVISION	APPR

SUBMITTED	
PROFESSIONAL	
APPROVED	
CHIEF - DIVISION OF MINE RECLAMATION	
APPROVED	
DIRECTOR - BUREAU OF DESIGN	

COMMONWEALTH OF PENNSYLVANIA
DEPARTMENT OF ENVIRONMENTAL RESOURCES
OFFICE OF RESOURCES MANAGEMENT

PROJECT NO. SL 113-5-1

MINE DRAINAGE POLLUTION ABATEMENT
COAL RUN
SHAMOKIN CREEK WATERSHED
NORTHUMBERLAND COUNTY, PA.

ERDMAN, ANTHONY, ASSOCIATES
Consulting Engineers
Camp Hill, Pa. Rochester, N.Y.

REFERENCE TIES

DRAWN BY	DATE	DRAWING NO.
GMS		
CHECKED BY	SCALE	26 of 26
	NO SCALE	