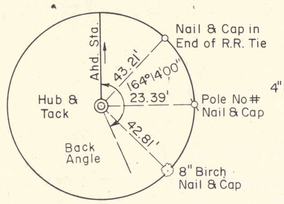

STA. 9+95

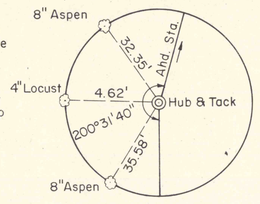

STA. 12+13

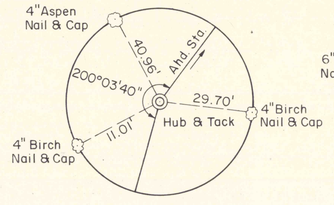

STA. 13+20

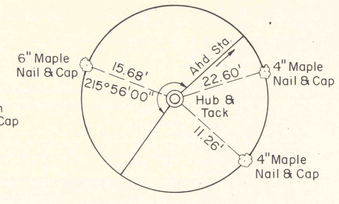

STA. 14+65

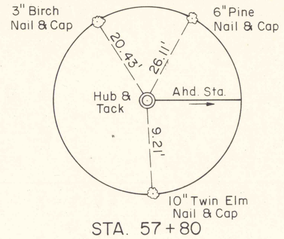

STA. 57+80

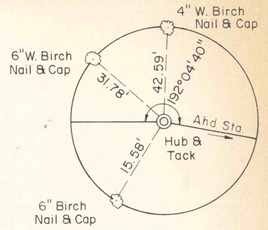

STA. 61+60

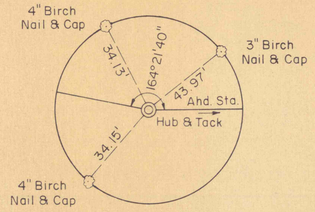

STA. 63+18

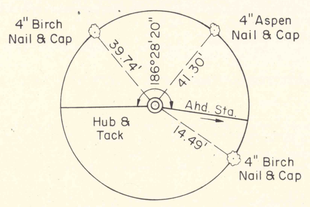

STA. 66+63

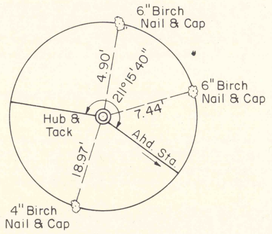

STA. 71+80

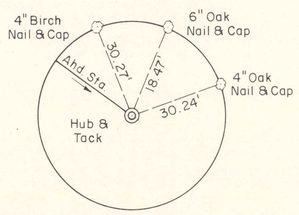

STA. 72+69

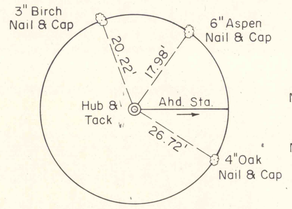

STA. 132+55

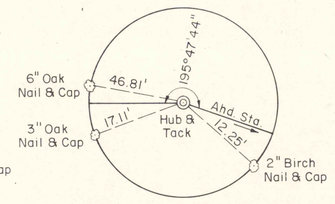

STA. 137+00

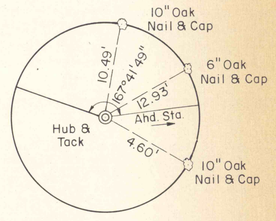

STA. 142+48

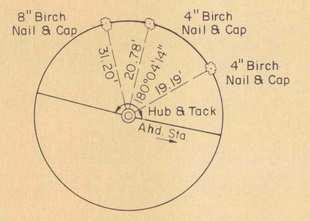

STA. 147+48

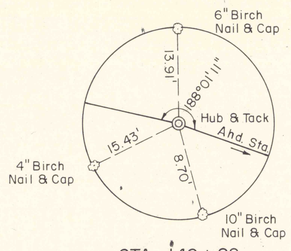

STA. 149+82

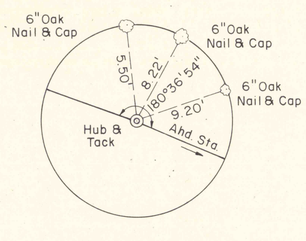

STA. 158+22

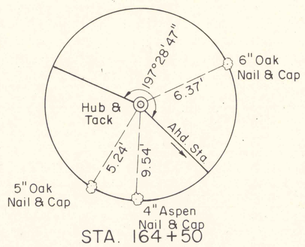

STA. 164+50

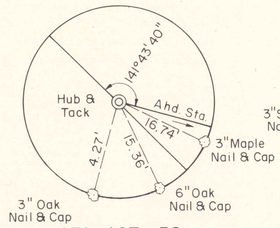

STA. 167+32
STA. E-0+00

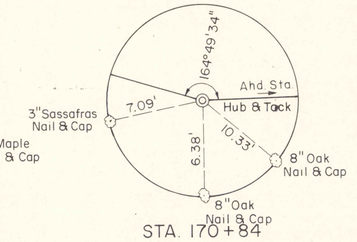

STA. 170+84

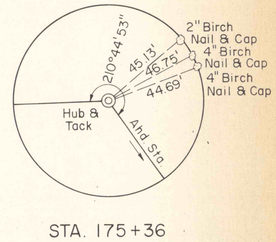

STA. 175+36

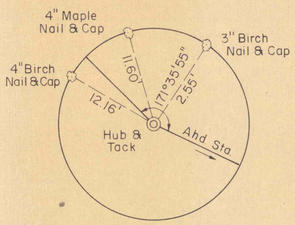

STA. E-3+18

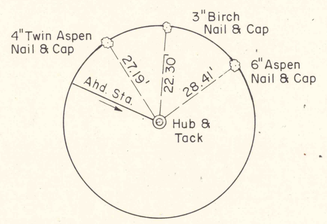

STA. E-7+00

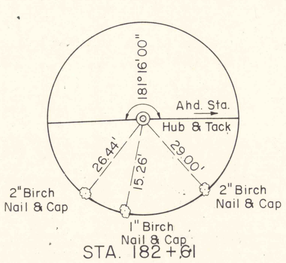

STA. 182+81

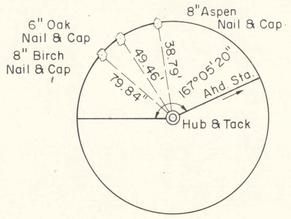

STA. 190+68

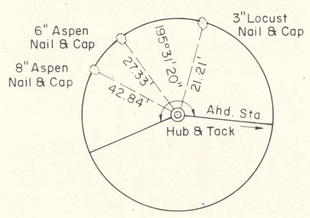

STA. 198+17

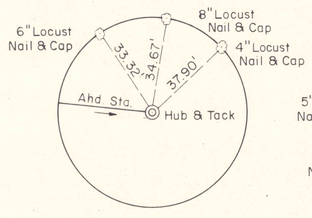

STA. 202+29

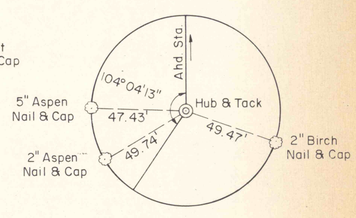

STA. C-4+34.00

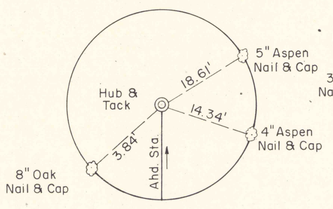

STA. C-8+31.00

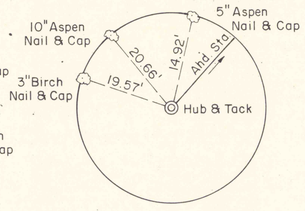

STA. D-0+00.00

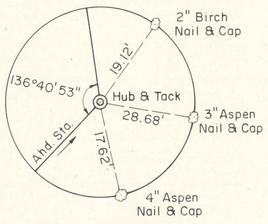

STA. D-6+52.58

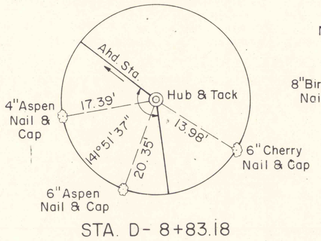

STA. D-8+83.18

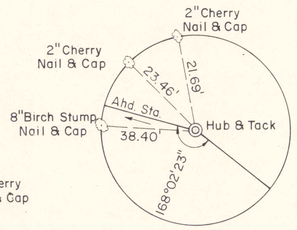

STA. D-12+66.51

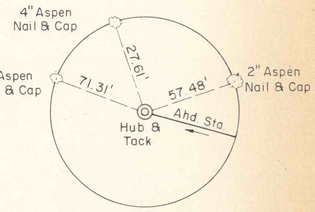

STA. D-17+51.22

NO	DATE	REVISION	APPR

SUBMITTED

PROFESSIONAL

APPROVED

CHIEF - DIVISION OF MINE RECLAMATION

APPROVED

DIRECTOR - BUREAU OF DESIGN

COMMONWEALTH OF PENNSYLVANIA
DEPARTMENT OF ENVIRONMENTAL RESOURCES
OFFICE OF RESOURCES MANAGEMENT

PROJECT NO. SL 113-5-1

MINE DRAINAGE POLLUTION ABATEMENT
COAL RUN
SHAMOKIN CREEK WATERSHED
NORTHUMBERLAND COUNTY, PA.

ERDMAN, ANTHONY, ASSOCIATES
Consulting Engineers
Camp Hill, Pa. Rochester, N.Y.

REFERENCE TIES

DRAWN BY	DATE	DRAWING NO.
GMS		26 of 26
CHECKED BY	SCALE	
	NO SCALE	

BRUNING 44-142 25788