


-840-1650  
 -794-1680  
 -765-1682  
 -736-1680  
 -694-1670  
 -670-1664  
 -658-1670  
 -634-1680  
 -620-1683  
 -606-1680  
 -584-1672  
 -572-1680  
 -567-1682  
 -562-1682  
 -558-1680  
 -550-1676  
 -545-1676  
 -540-1680  
 -524-1690  
 -502-1698.7  
 -488-1690  
 -478-1686  
 -470-1686  
 -452-1689.9  
 -434-1680  
 -362-1620  
 -344-1624  
 -332-1624  
 -320-1630  
 -280-1650  
 -270-1650  
 -220-1620  
 -198-1620

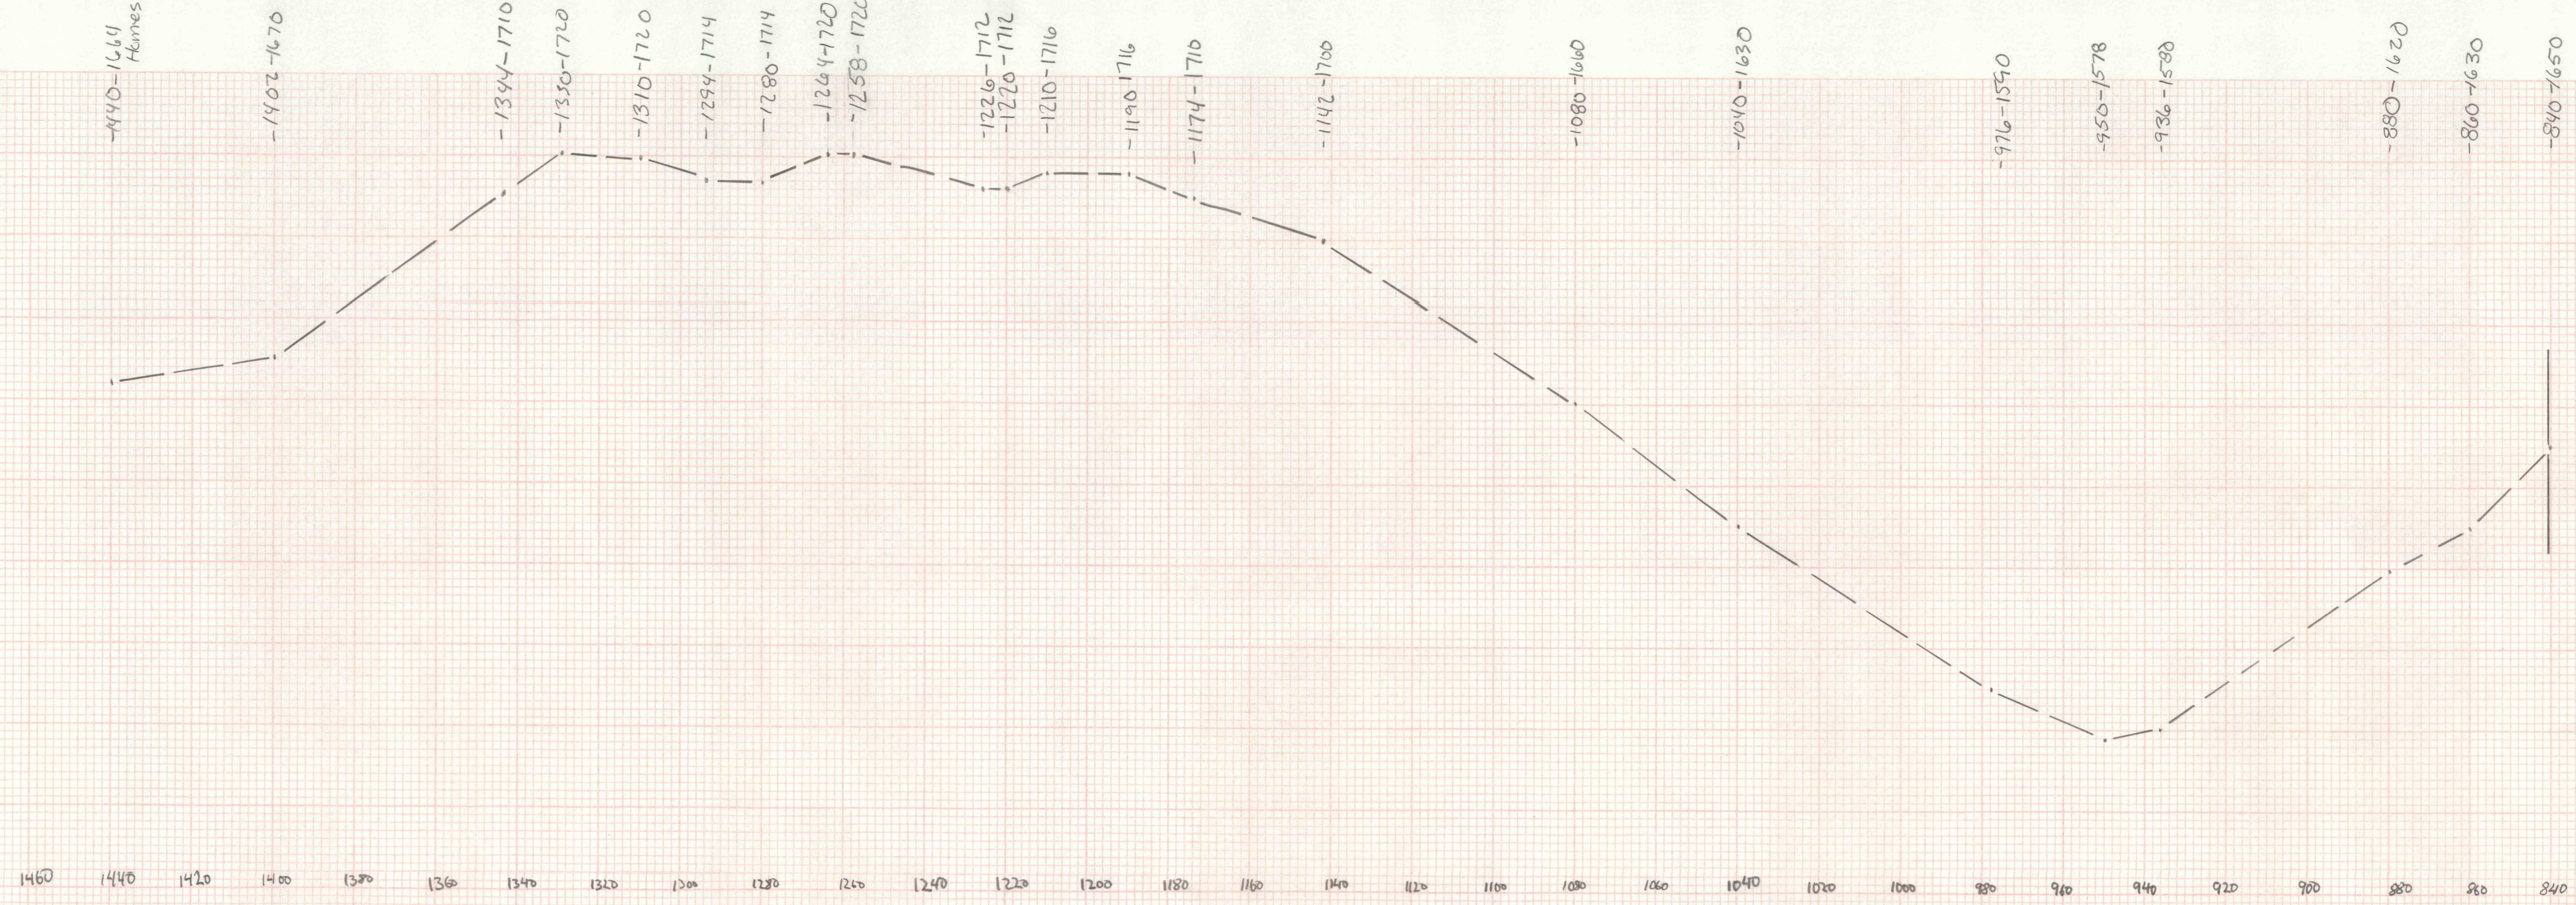

 -1402-1670  
 -1344-1710  
 -1330-1720  
 -1310-1720  
 -1294-1714  
 -1280-1714  
 -1264-1720  
 -1258-1720  
 -1226-1712  
 -1220-1712  
 -1210-1716  
 -1190-1716  
 -1174-1710  
 -1142-1700  
 -1080-1660  
 -1040-1630  
 -976-1590  
 -950-1578  
 -936-1580  
 -880-1620  
 -860-1630  
 -840-1650

OSM 40C321371011  
 CRANBERRY RIDGE  
 STA: 26+30  
 SCALE: 1" = 20'

PRELIMINARY:		FINAL:	
PLOT	DATE	PLOT	DATE
15	7-7-88		
CHEK	DATE	CHEK	DATE

SHEET \_\_\_ OF \_\_\_