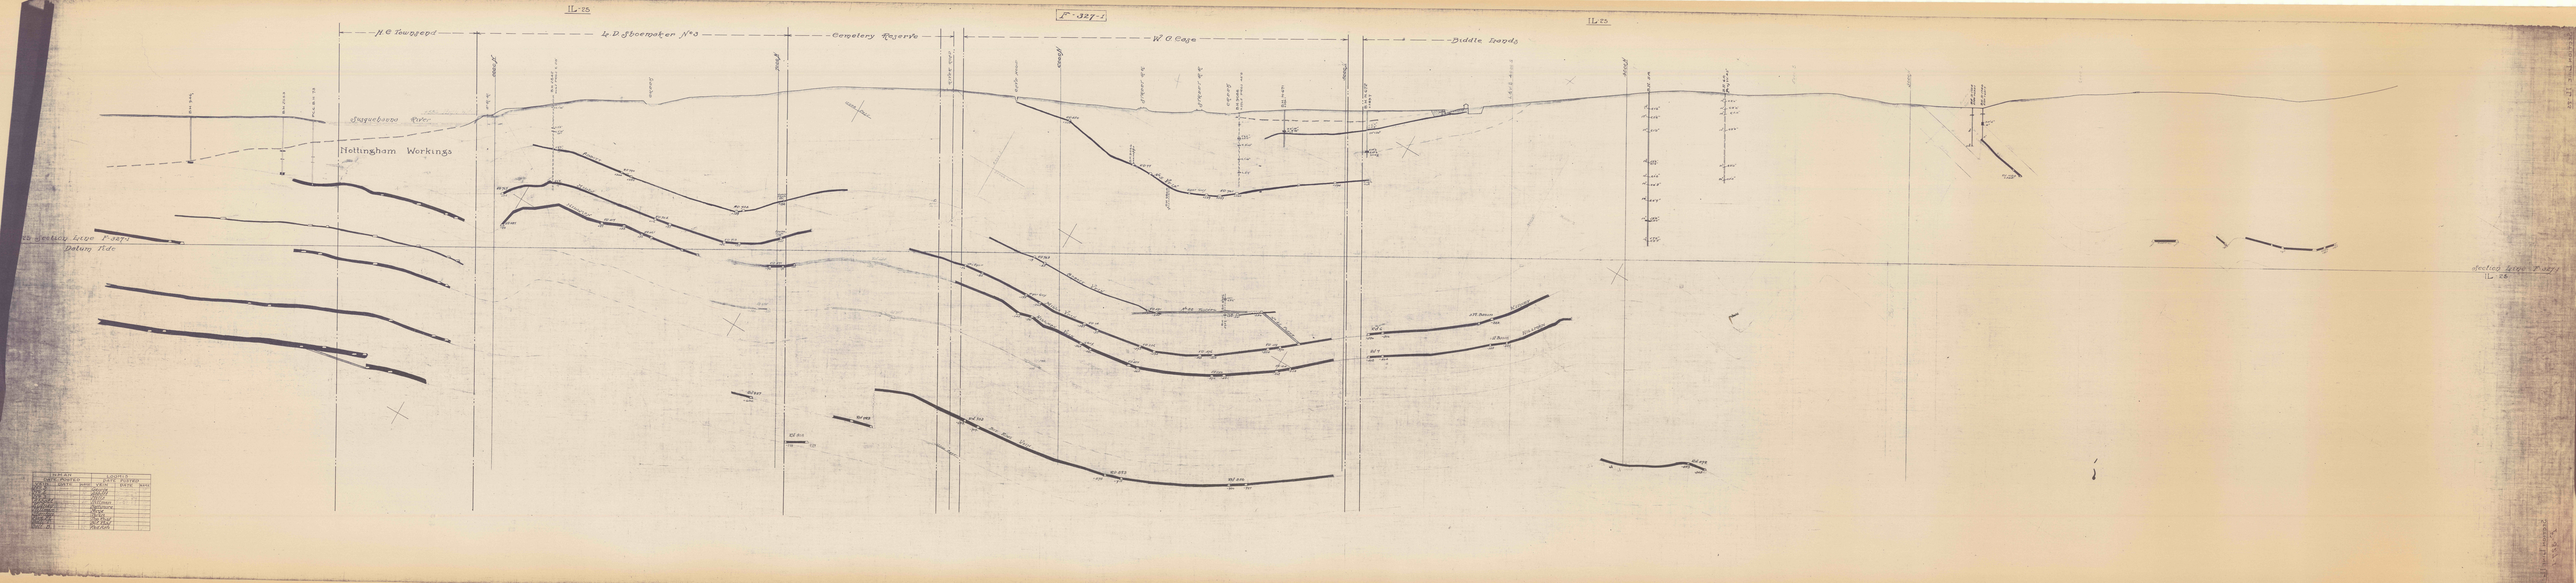
IL 25
F-327-1
IL 25
H. C. Townsend
L. D. Shoemaker No. 3
Cemetery Reserve
W. O. Cage
Biddle Lands
Nottingham Workings
to section large F-327-1
section large F-327-1
IL 25