


ROBERT HILTZSIMER TRACT

WILLIAM SHANNON TRACT

GEORGE BICKHAM TRACT

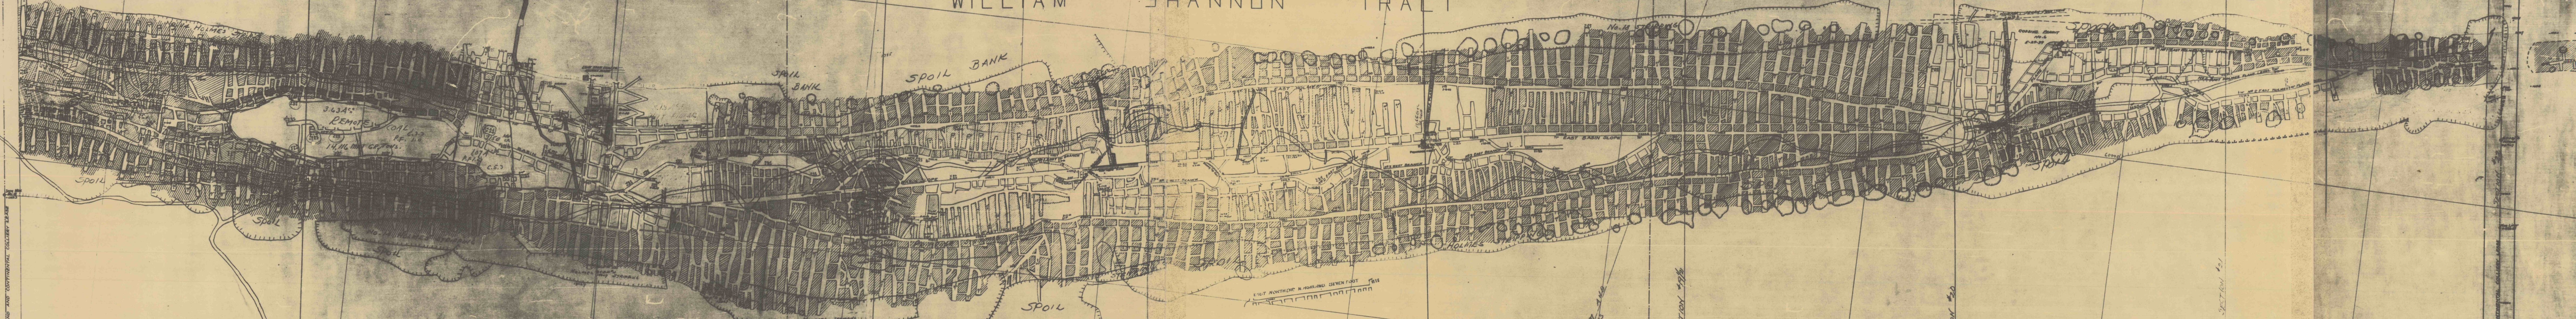

CONTINENTAL COLLIERY
Holmes Bed

Scale 1 inch = 100 feet

Pottsville, Pa.
Oct 1, 1917

James Archbald,
Geologist

GIRARD ESTATE MAP NO. 1886.