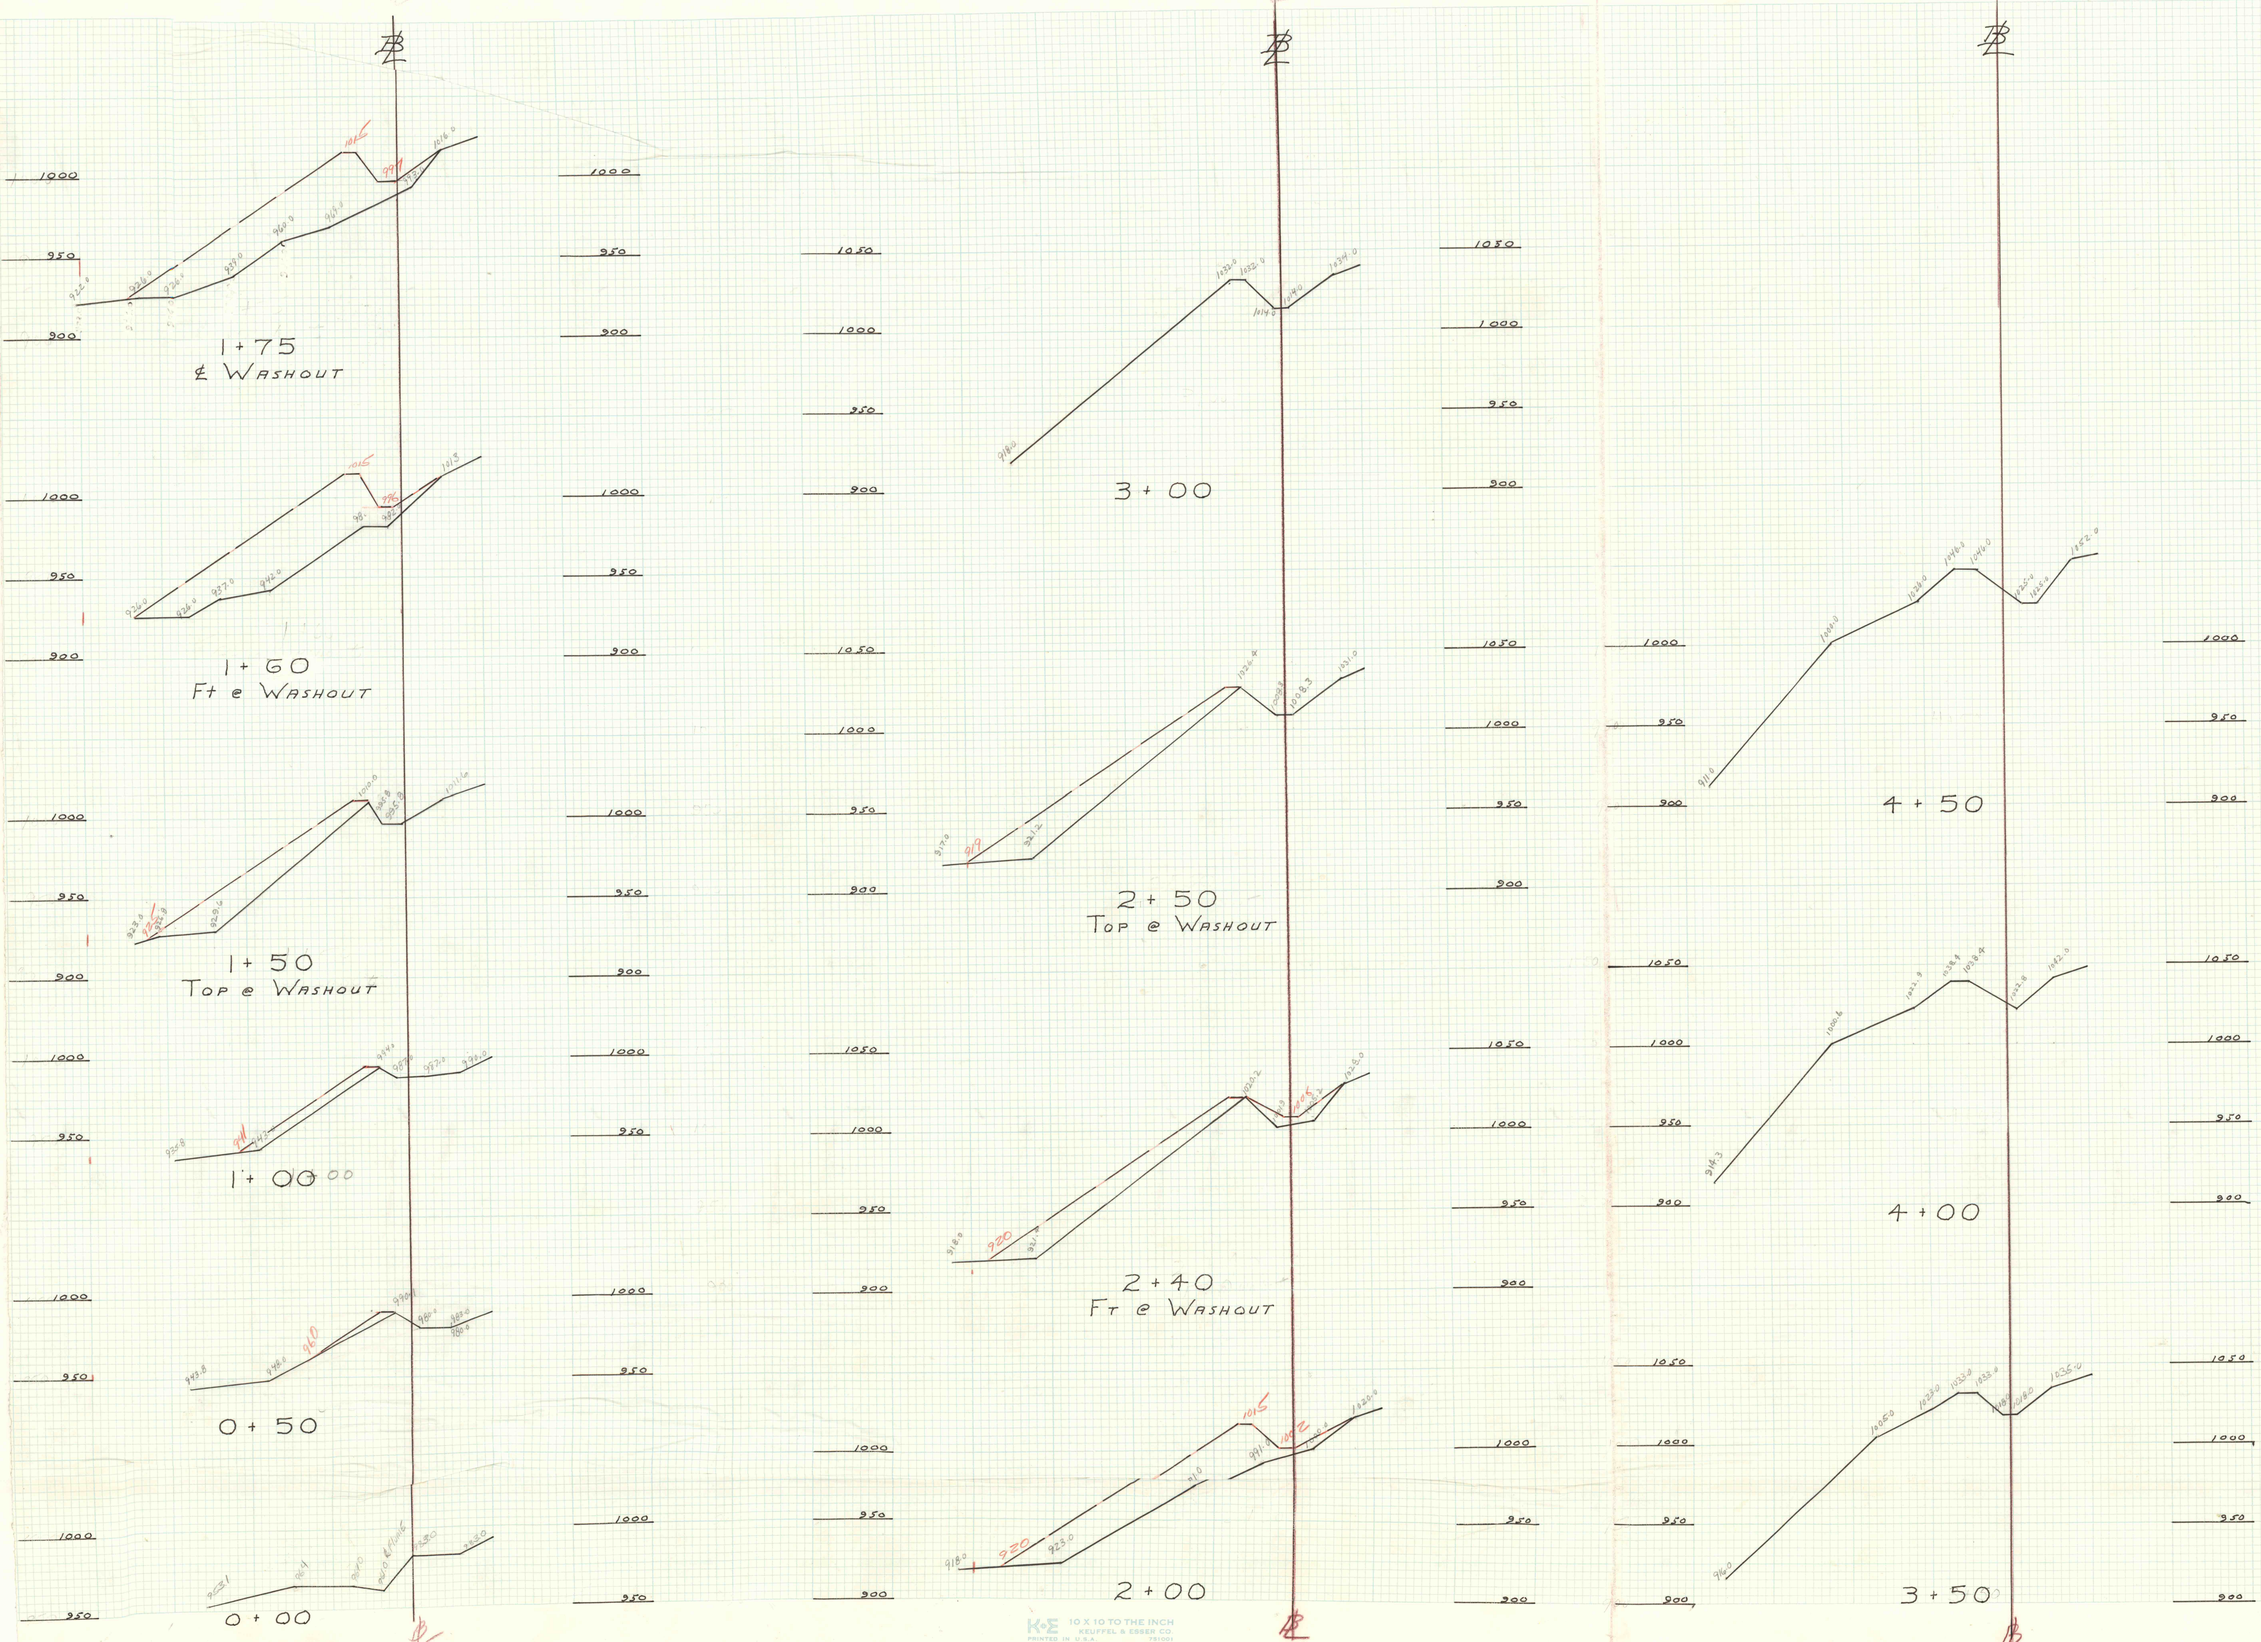
1+75
℄ Washout
1+60
Ft e Washout
1+50
Top e Washout
1+00
0+50
0+00
3+00
2+50
Top e Washout
2+40
Ft e Washout
2+00
4+50
4+00
3+50
WADHAMS CREEK FLUME
PLYMOUTH TWP.
PENNSYLVANIA
SCALE 1" = 50'
FEB. 13, 1976