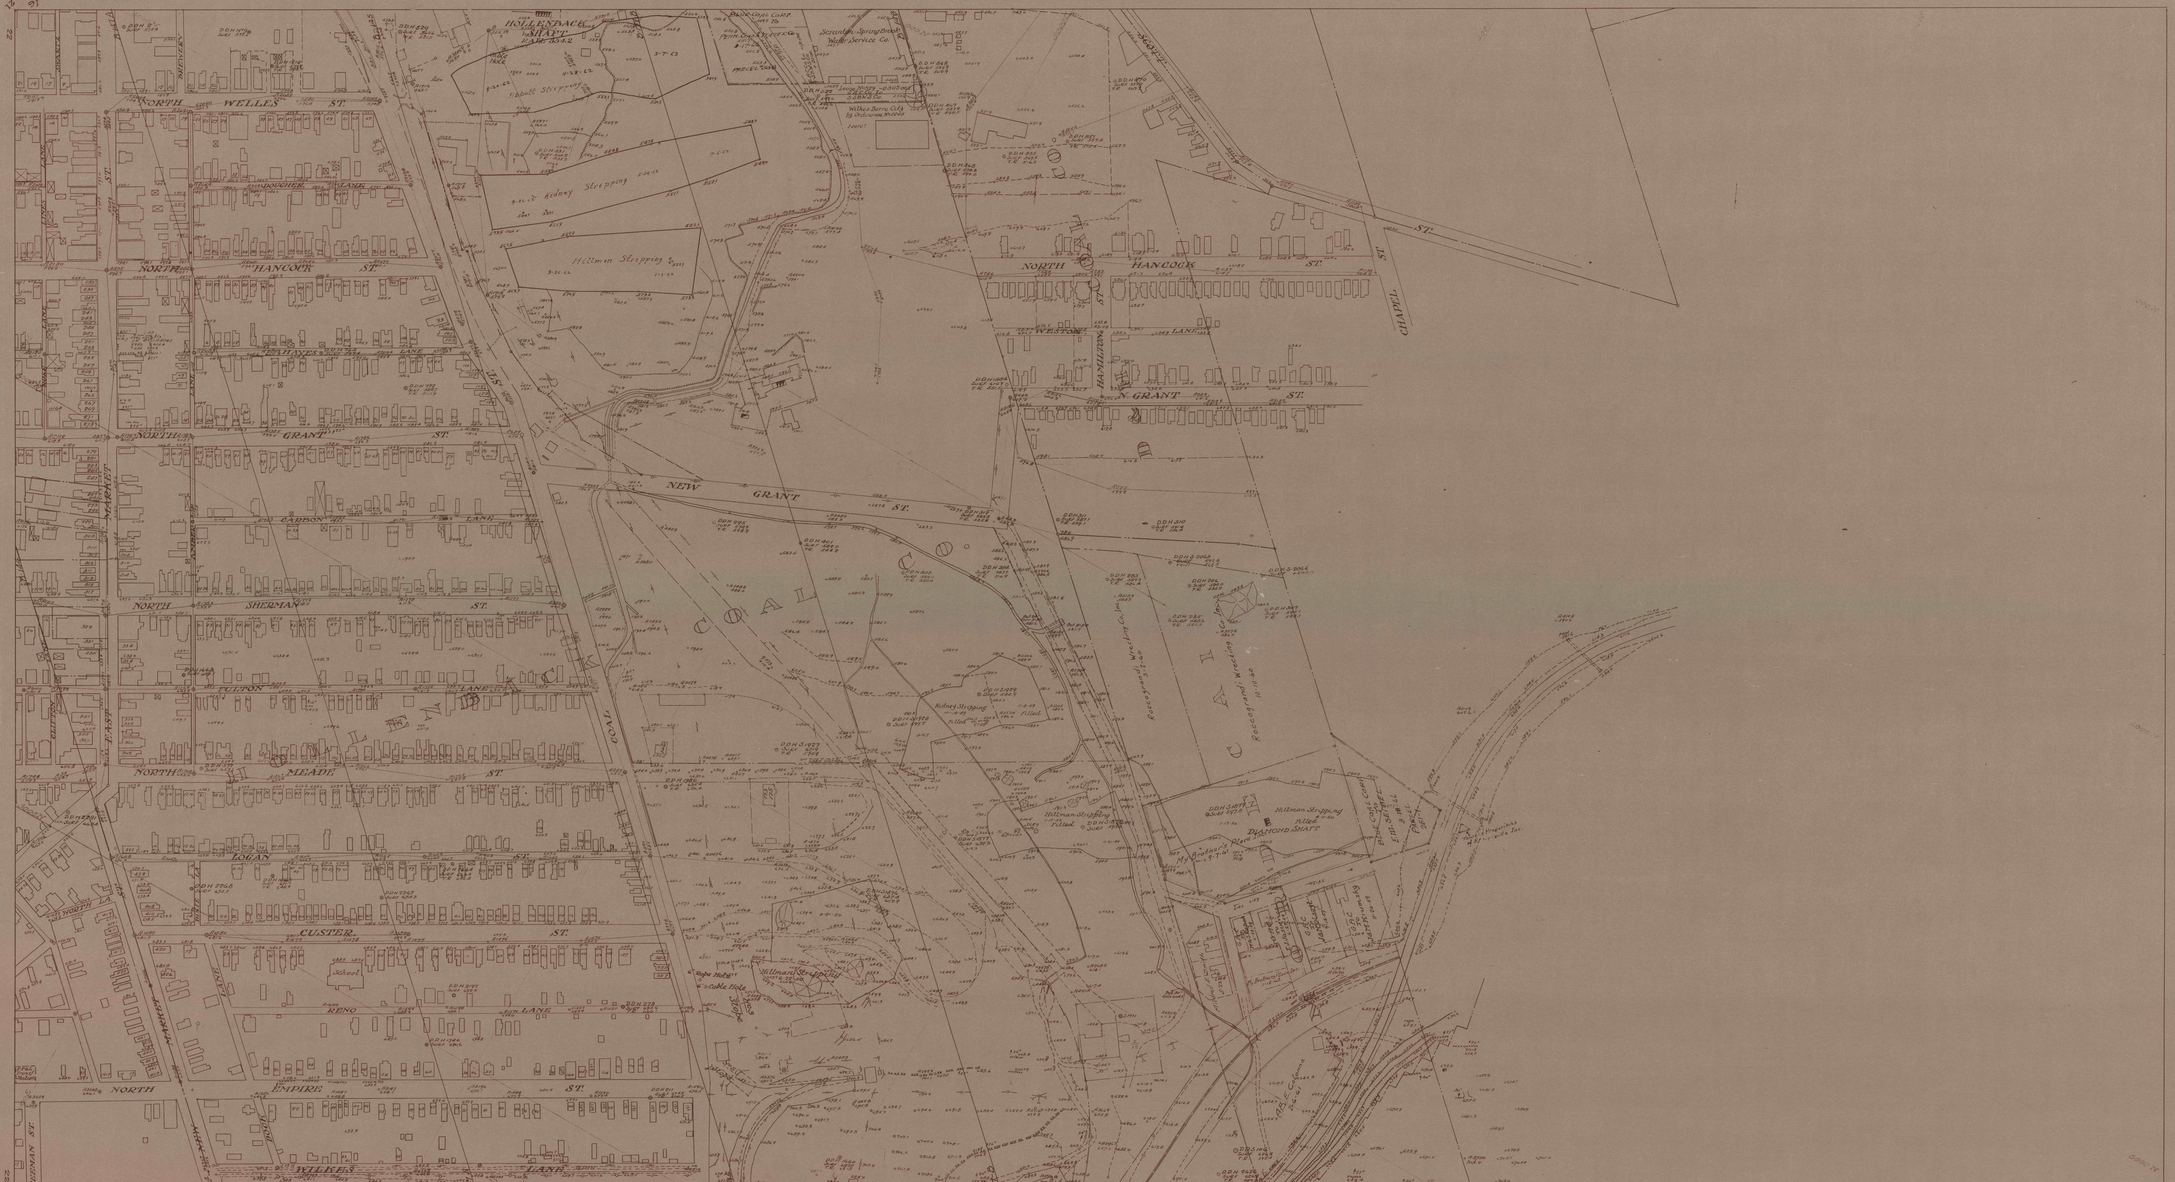
NORTH WELLES ST.
NORTH HANCOCK ST.
NORTH GRANT ST.
NORTH SHERMAN ST.
NORTH MEADE ST.
LOGAN ST.
CUSTER ST.
RENO LANE
NORTH EMPIRE ST.
WILKES LANE
MACFARLANE ST.
FREEMAN ST.
HOLLENBACK SHAFT
Kidney Stripping
Hillman Stripping
NEW GRANT ST.
COAL CO.
N. GRANT ST.
CHAPEL ST.
DIAMOND SHAFT