


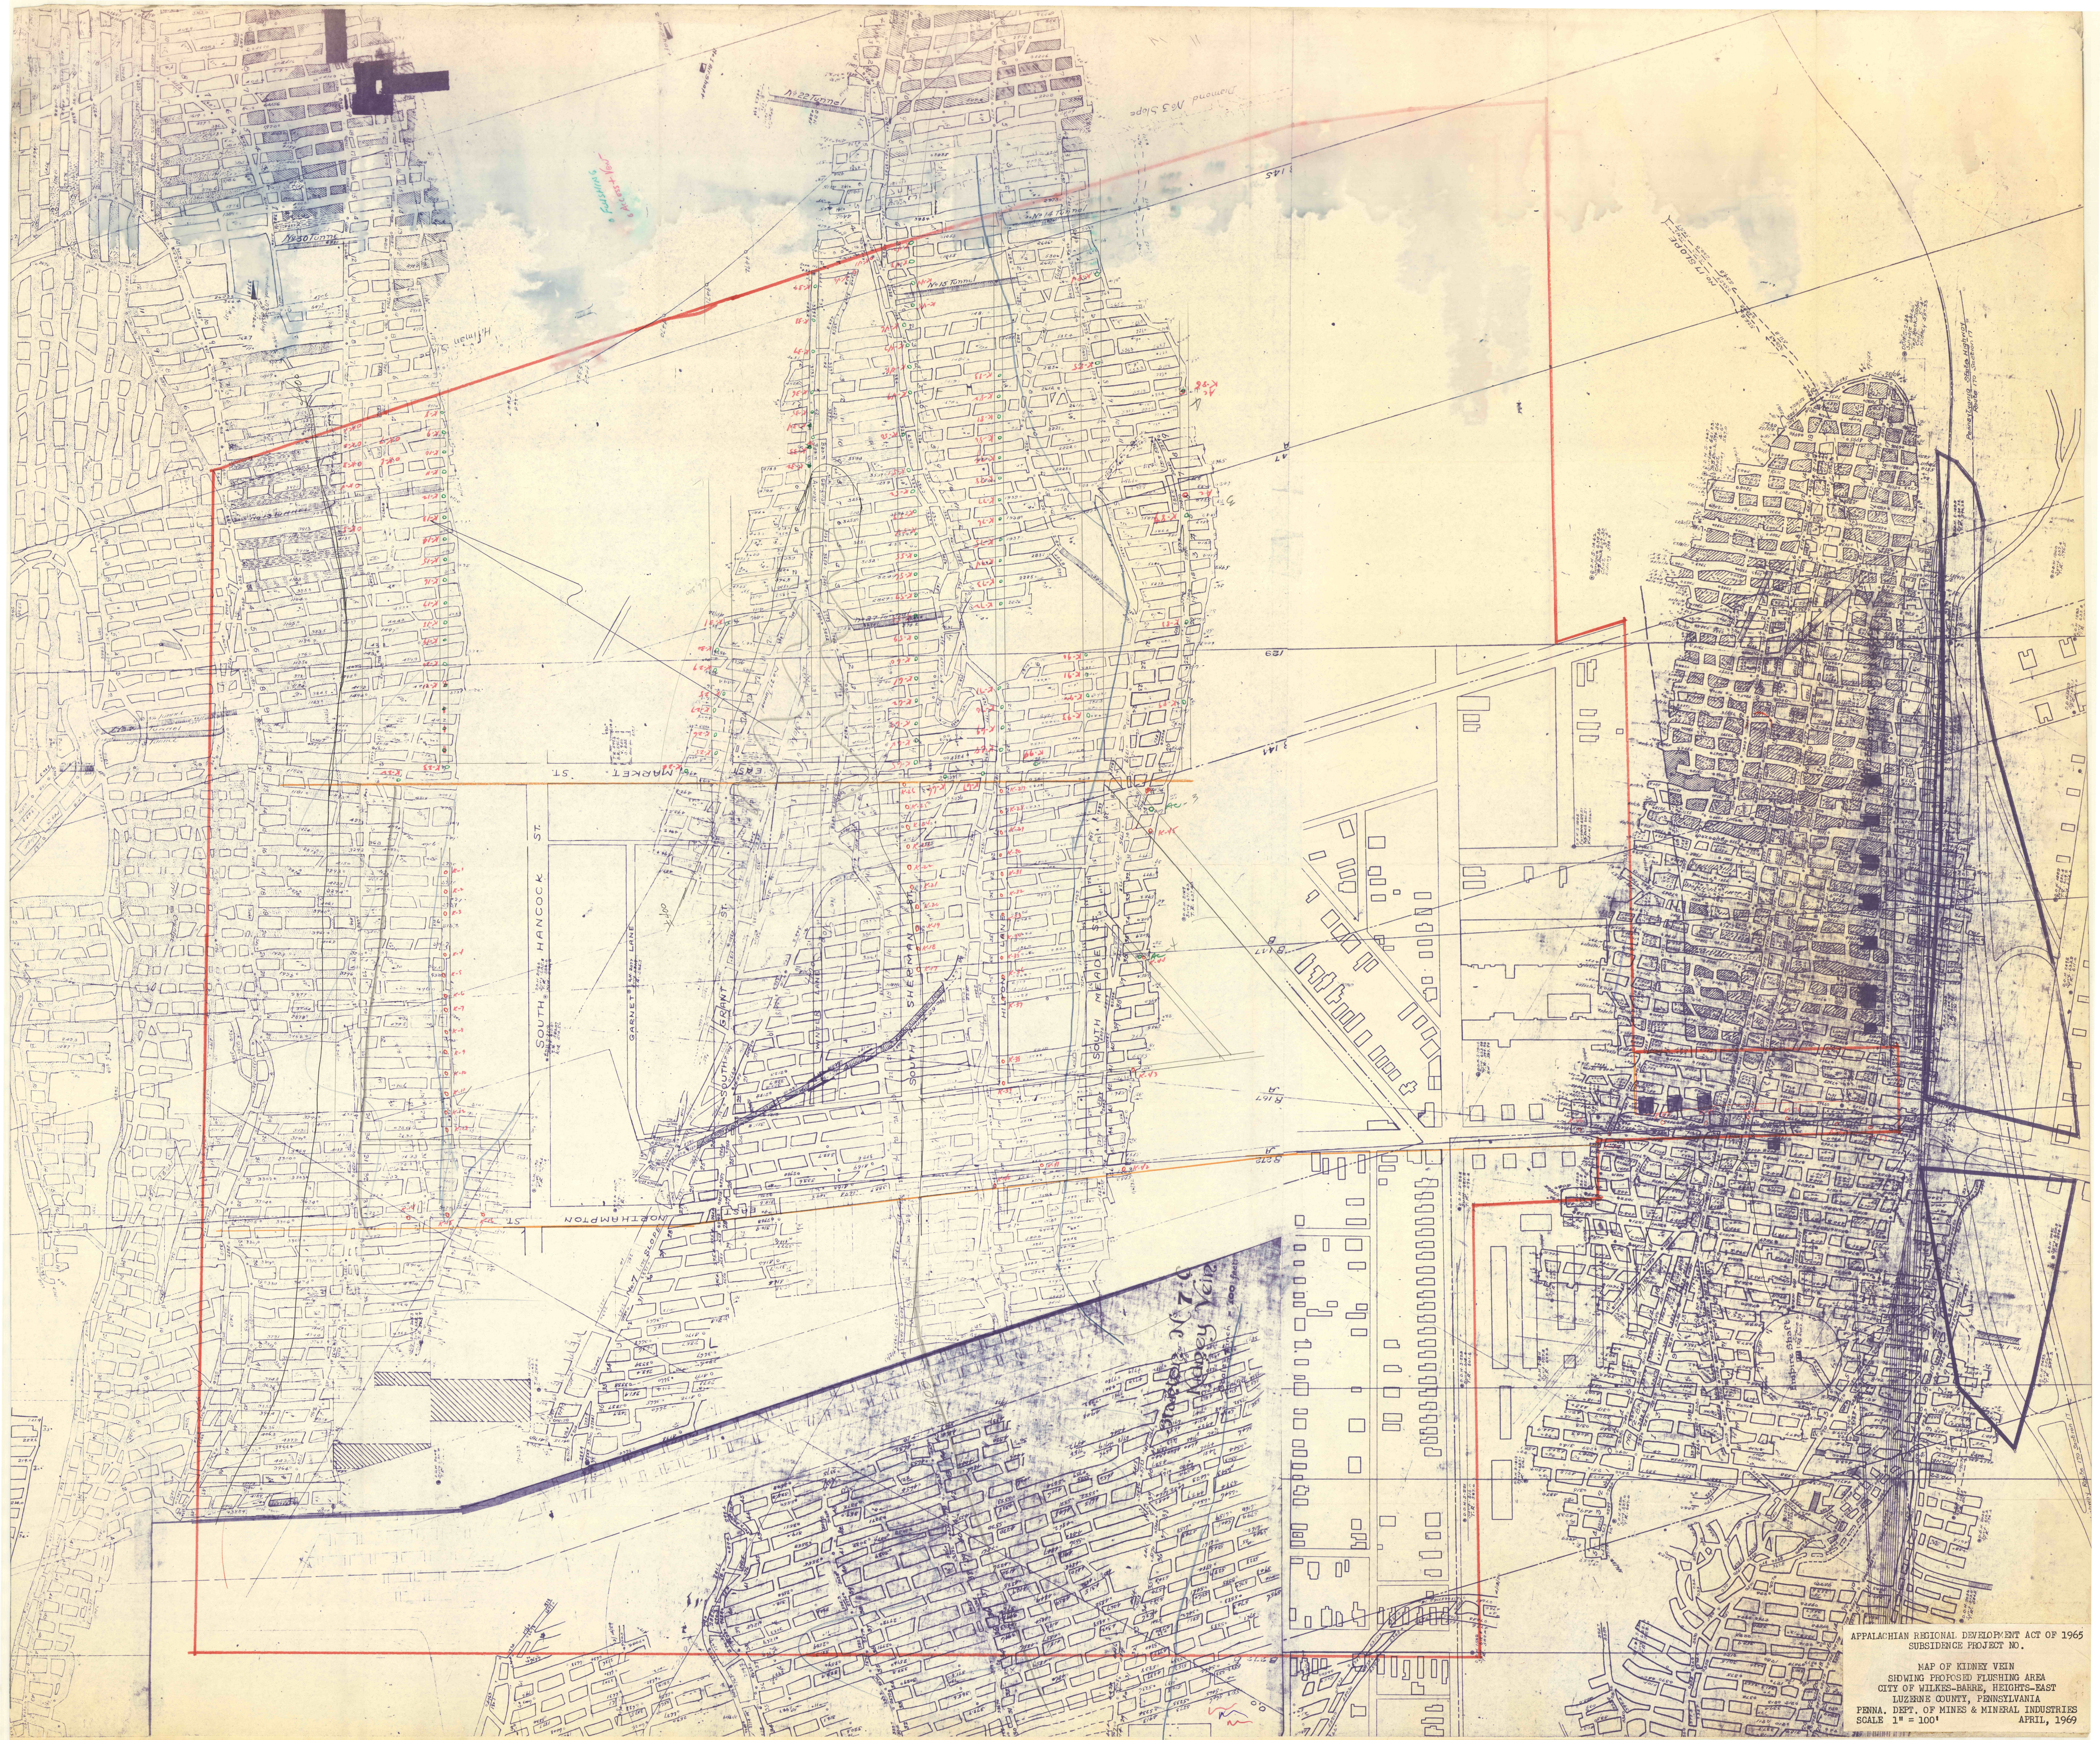

APPALACHIAN REGIONAL DEVELOPMENT ACT OF 1965
MAP OF KINNEY VEIN
SHOWING PROPOSED FLUSHING AREA
CITY OF WILKES-BARRE, HEIGHTS-EAST
LUZERNE COUNTY, PENNSYLVANIA
PENNA. DEPT. OF MINES & MINERAL INDUSTRIES
SCALE 1" = 100'
APRIL, 1969