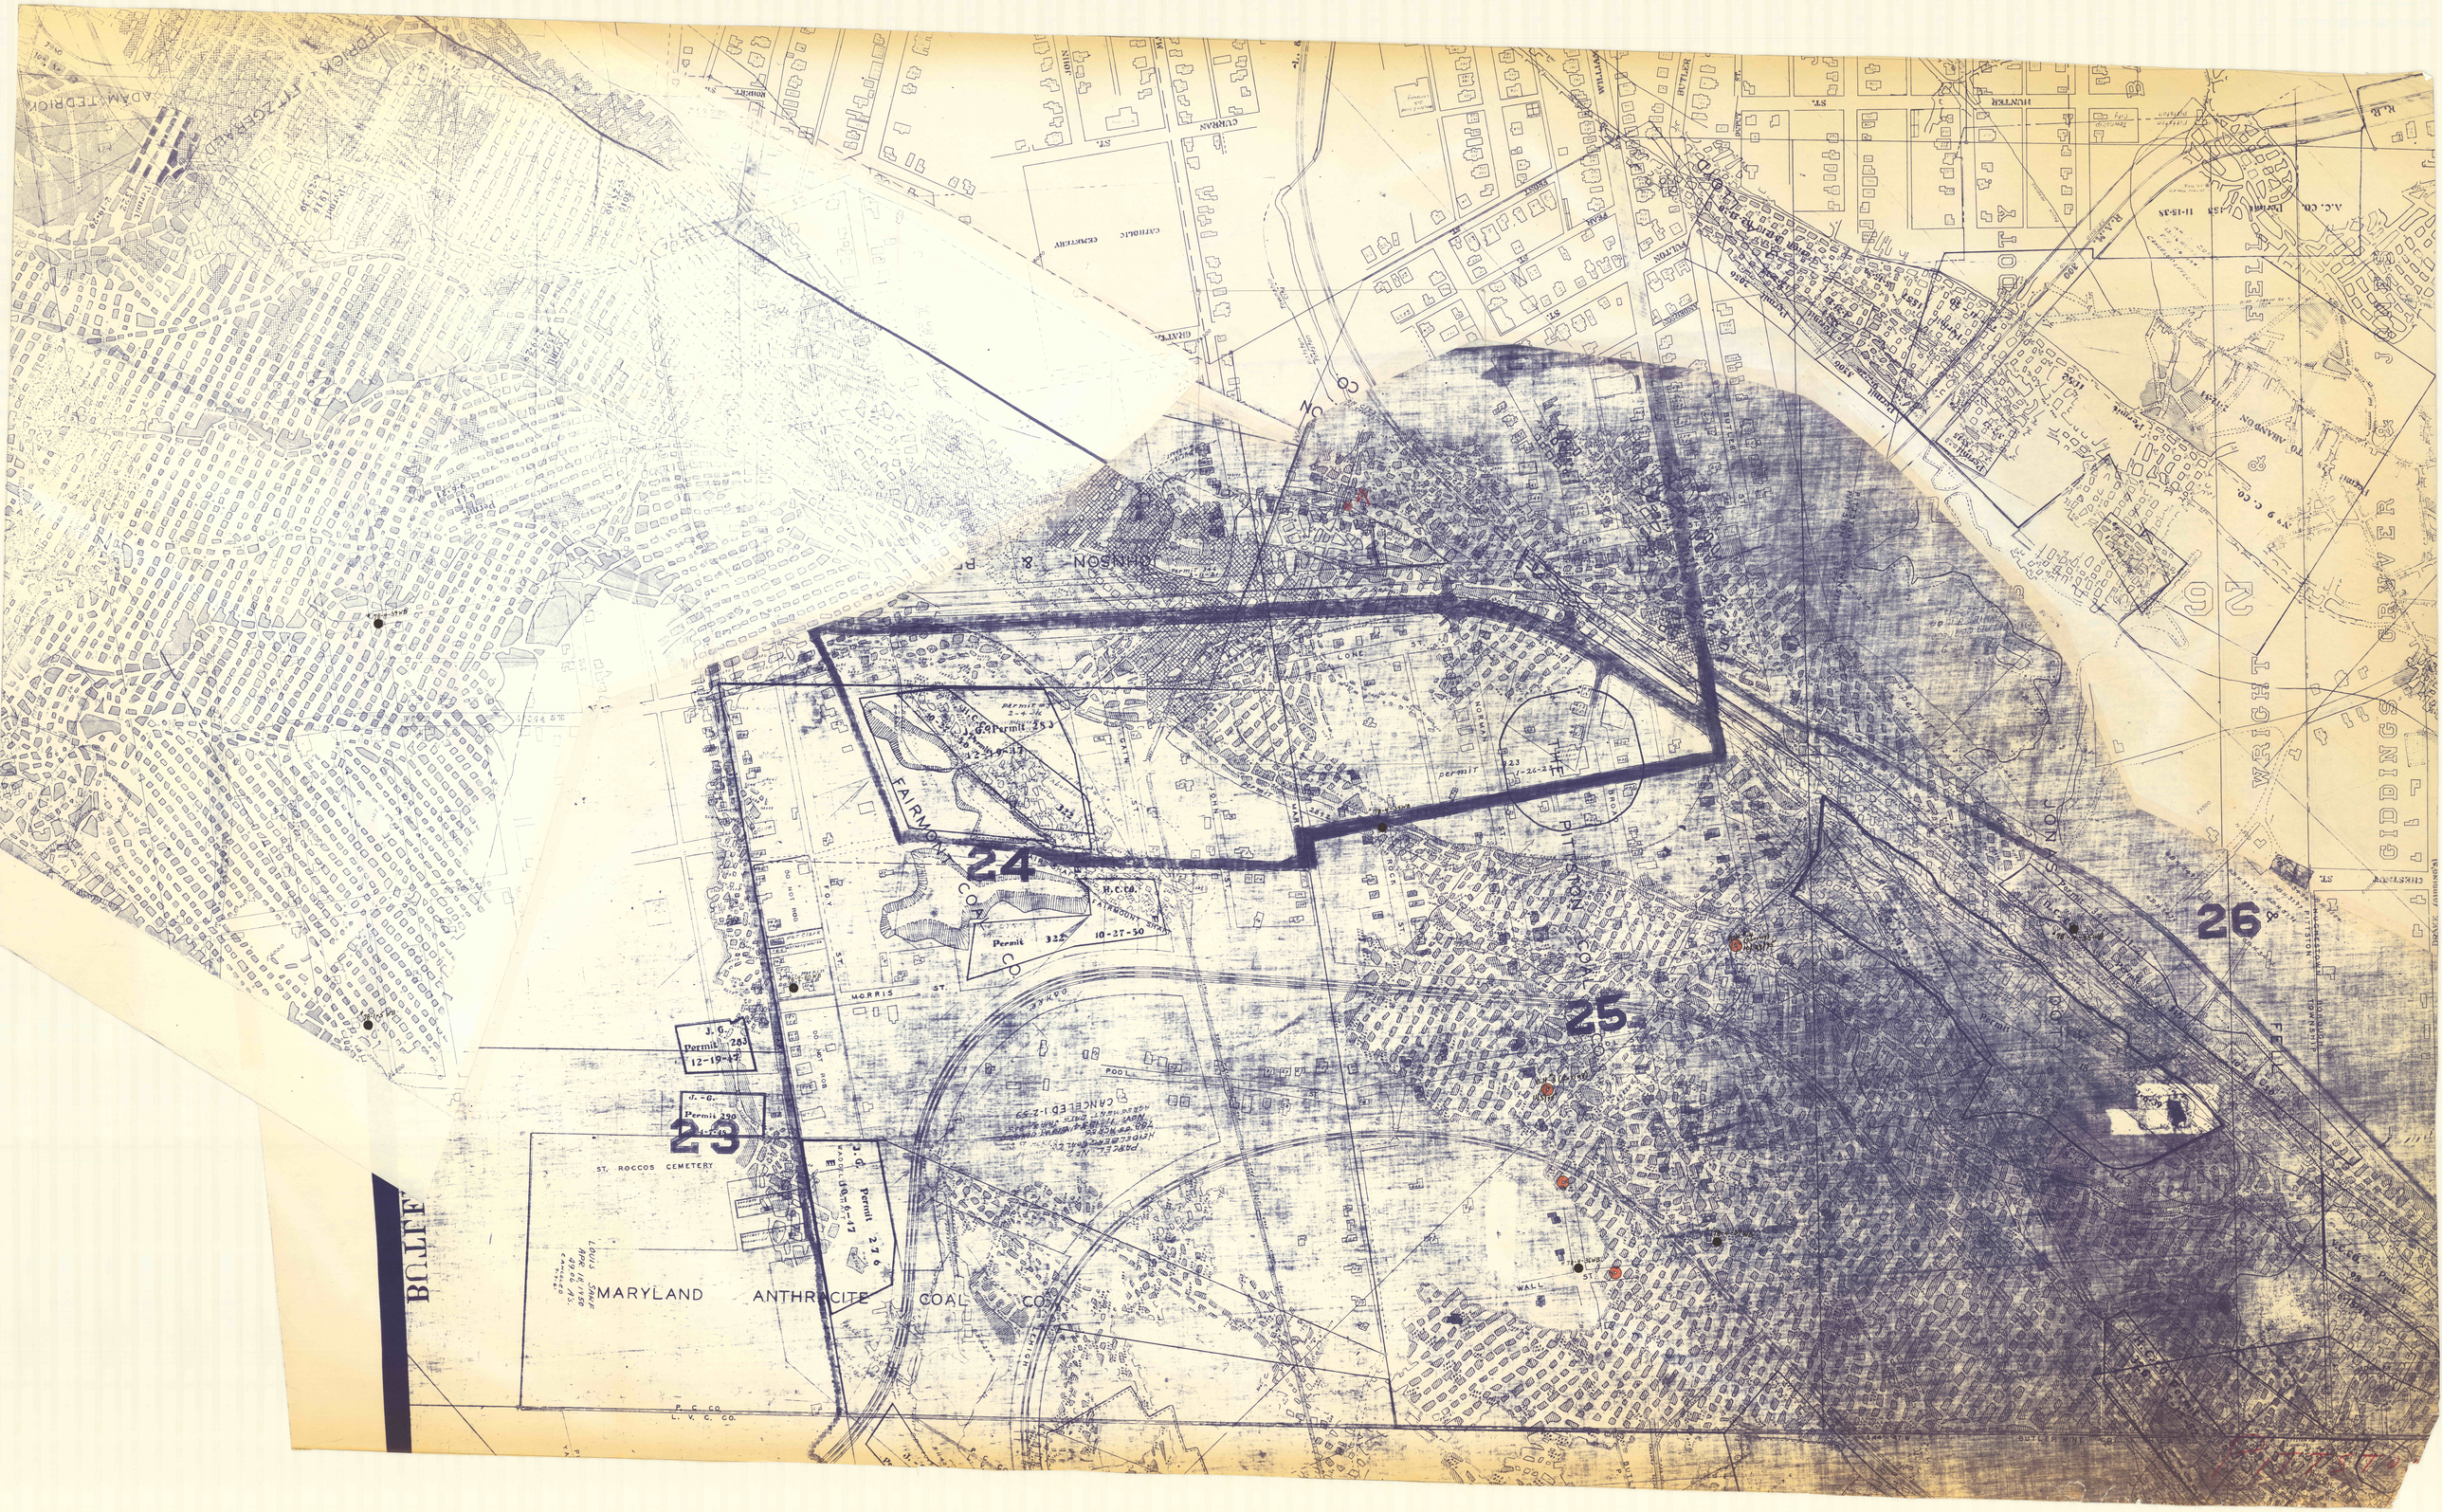
24
25
26
23
FAIRMONT COAL CO.
PITTSTON COAL CO.
MARYLAND ANTHRACITE COAL CO.
ST. ROCCOS CEMETERY
CATHOLIC CEMETERY
J. G. Permit 253
12-29-43
J. G. Permit 290
J. G. Permit 276
B.C.Co. Permit 322
10-27-50
MORRIS ST.
POOL
WALL
NORMAN
LONG
JOHNSON & R
GIDDINGS
WRIGHT
BOLLE