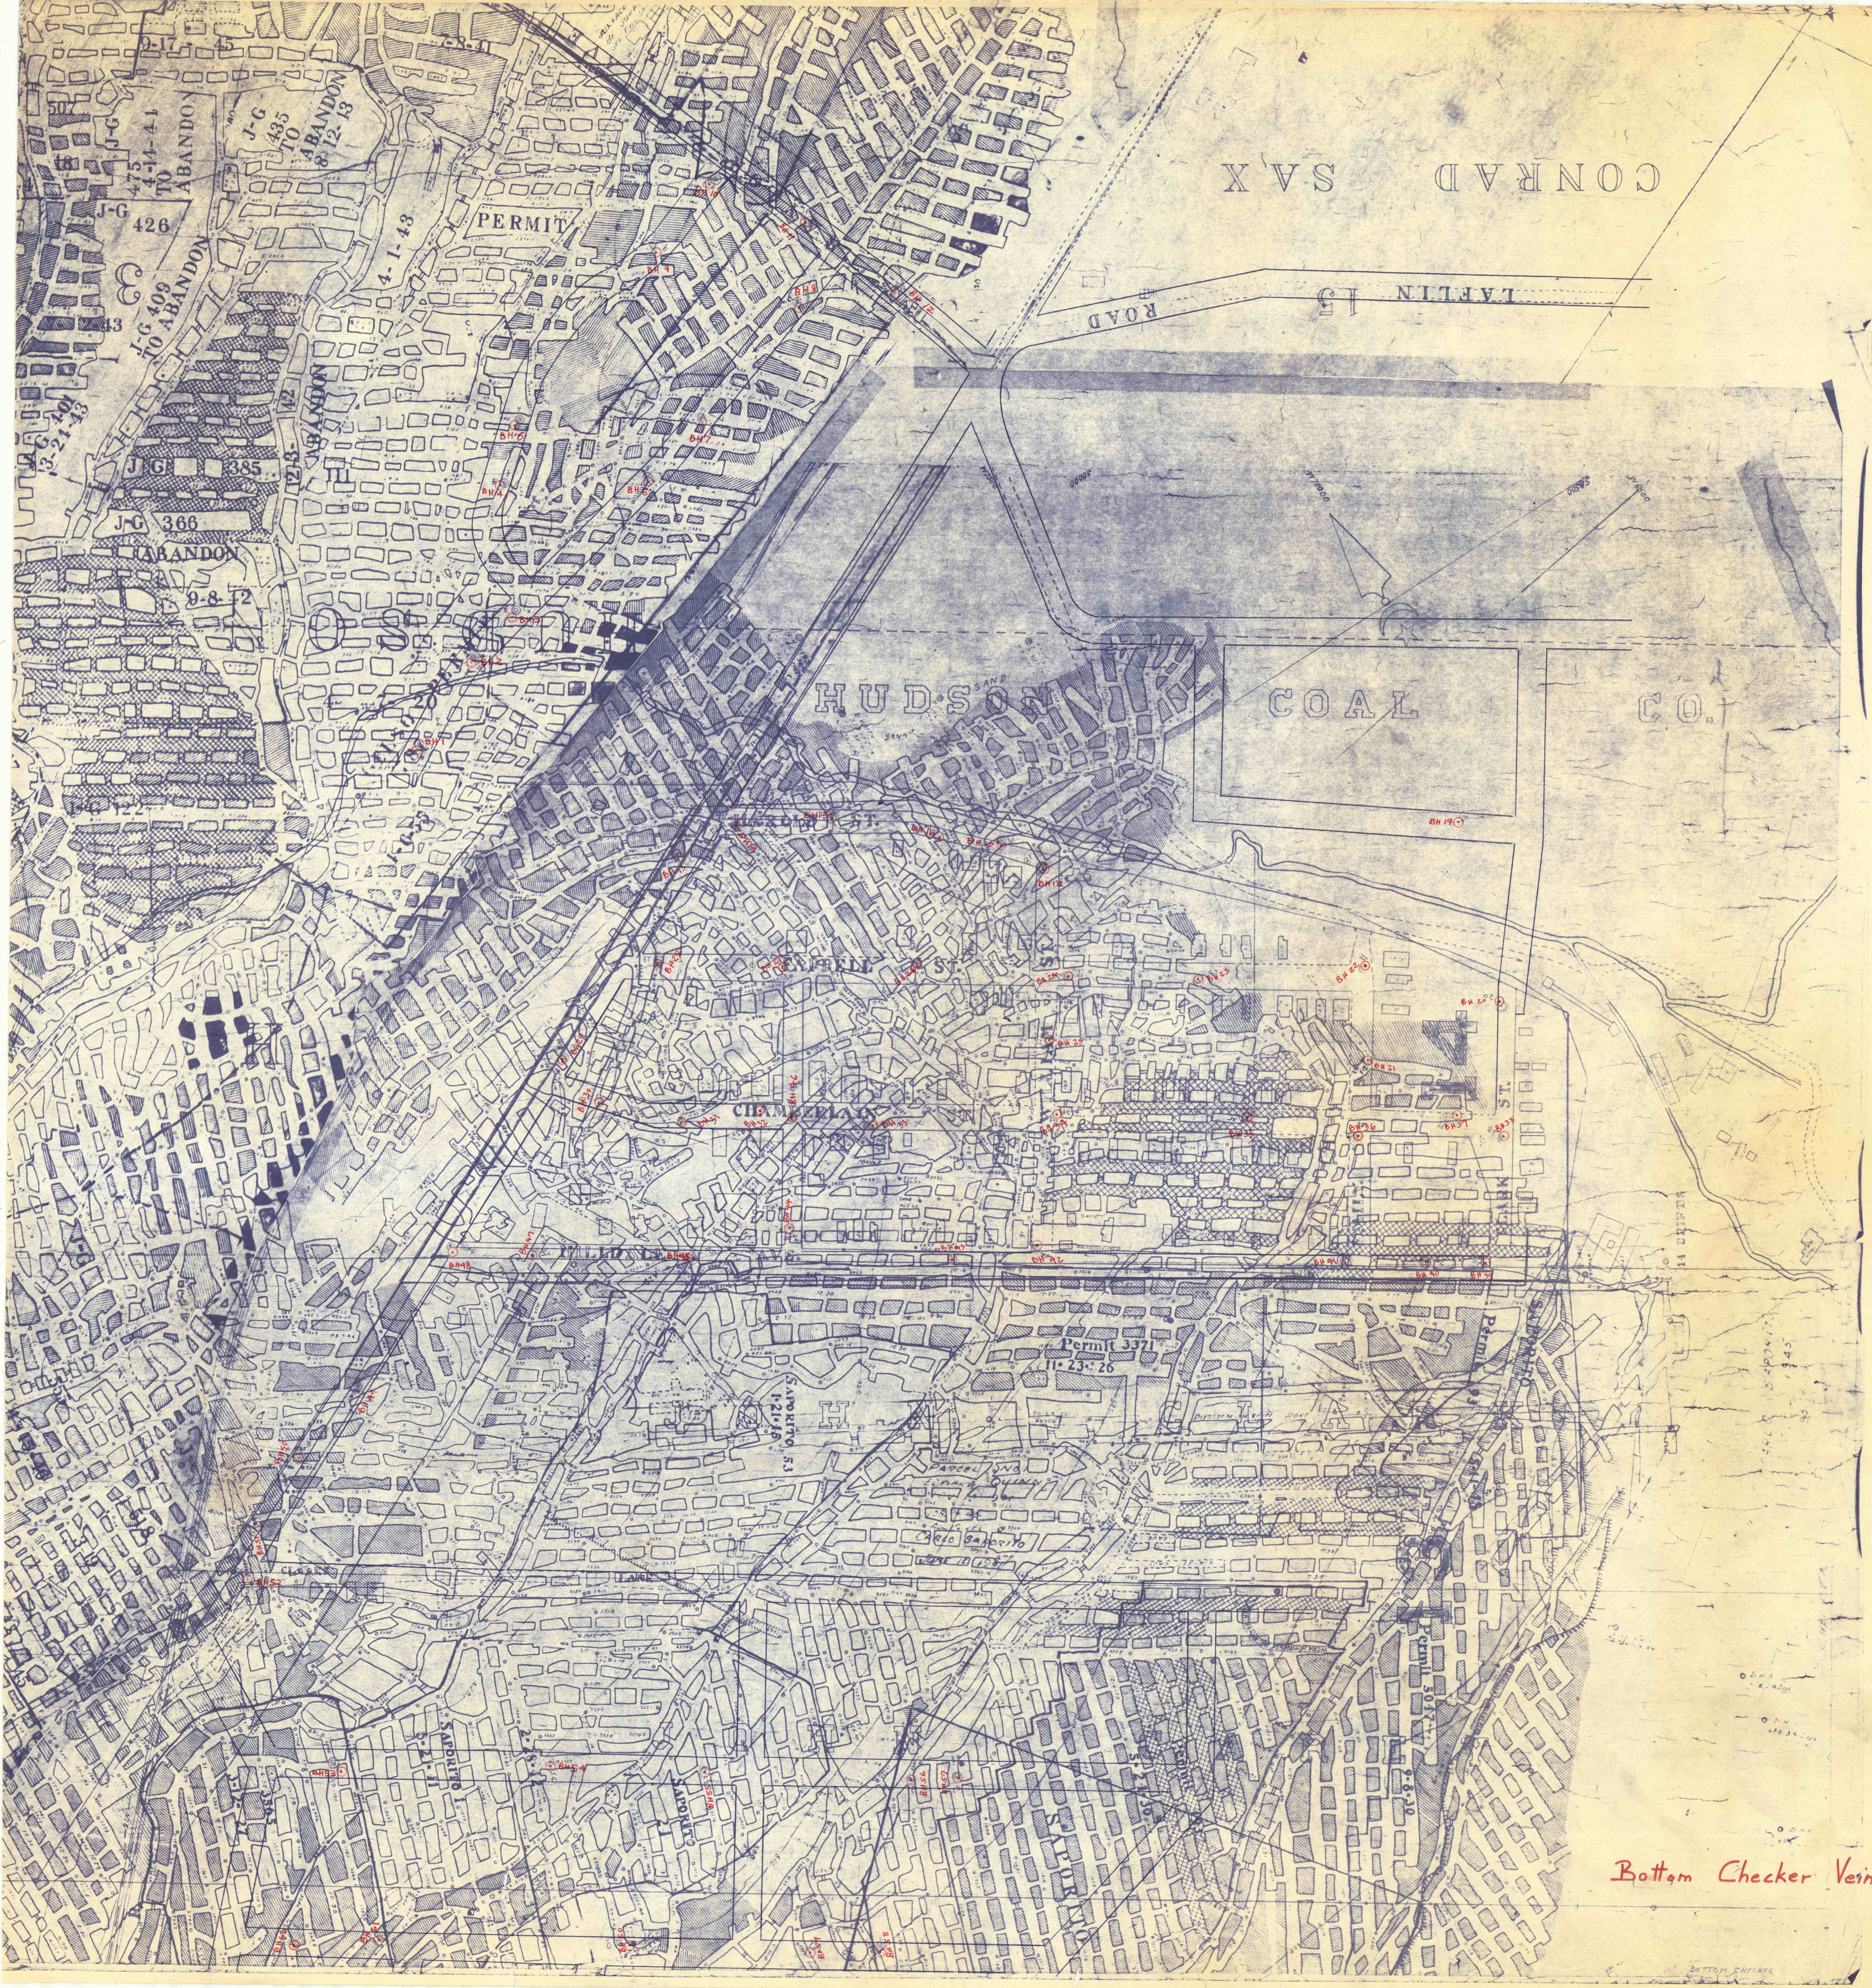
CONRAD SAX
LAFLIN 13
ROAD
HUDSON COAL CO.
PERMIT
J-G 426
J-G 409 TO ABANDON
J-G 435 TO ABANDON 8-12-13
J-G 385
J-G 366
ABANDON
9-8-12
4-1-43
HAROLD ST.
FARRELL ST.
CHAMBERLAIN
Permit 3371
11-23-26
SAPORITO 53
1-21-46
CARLO SAPORITO
JUNE 11 1951
PITTSTON VEIN
Permit 5047
9-8-30
SAPORITO
14 DRIFTS
Bottom Checker Vein
BOTTOM CHECKER