

ARRIJE


ESTATE

OV E P R O S

N I X

40104

PHOENIX ST

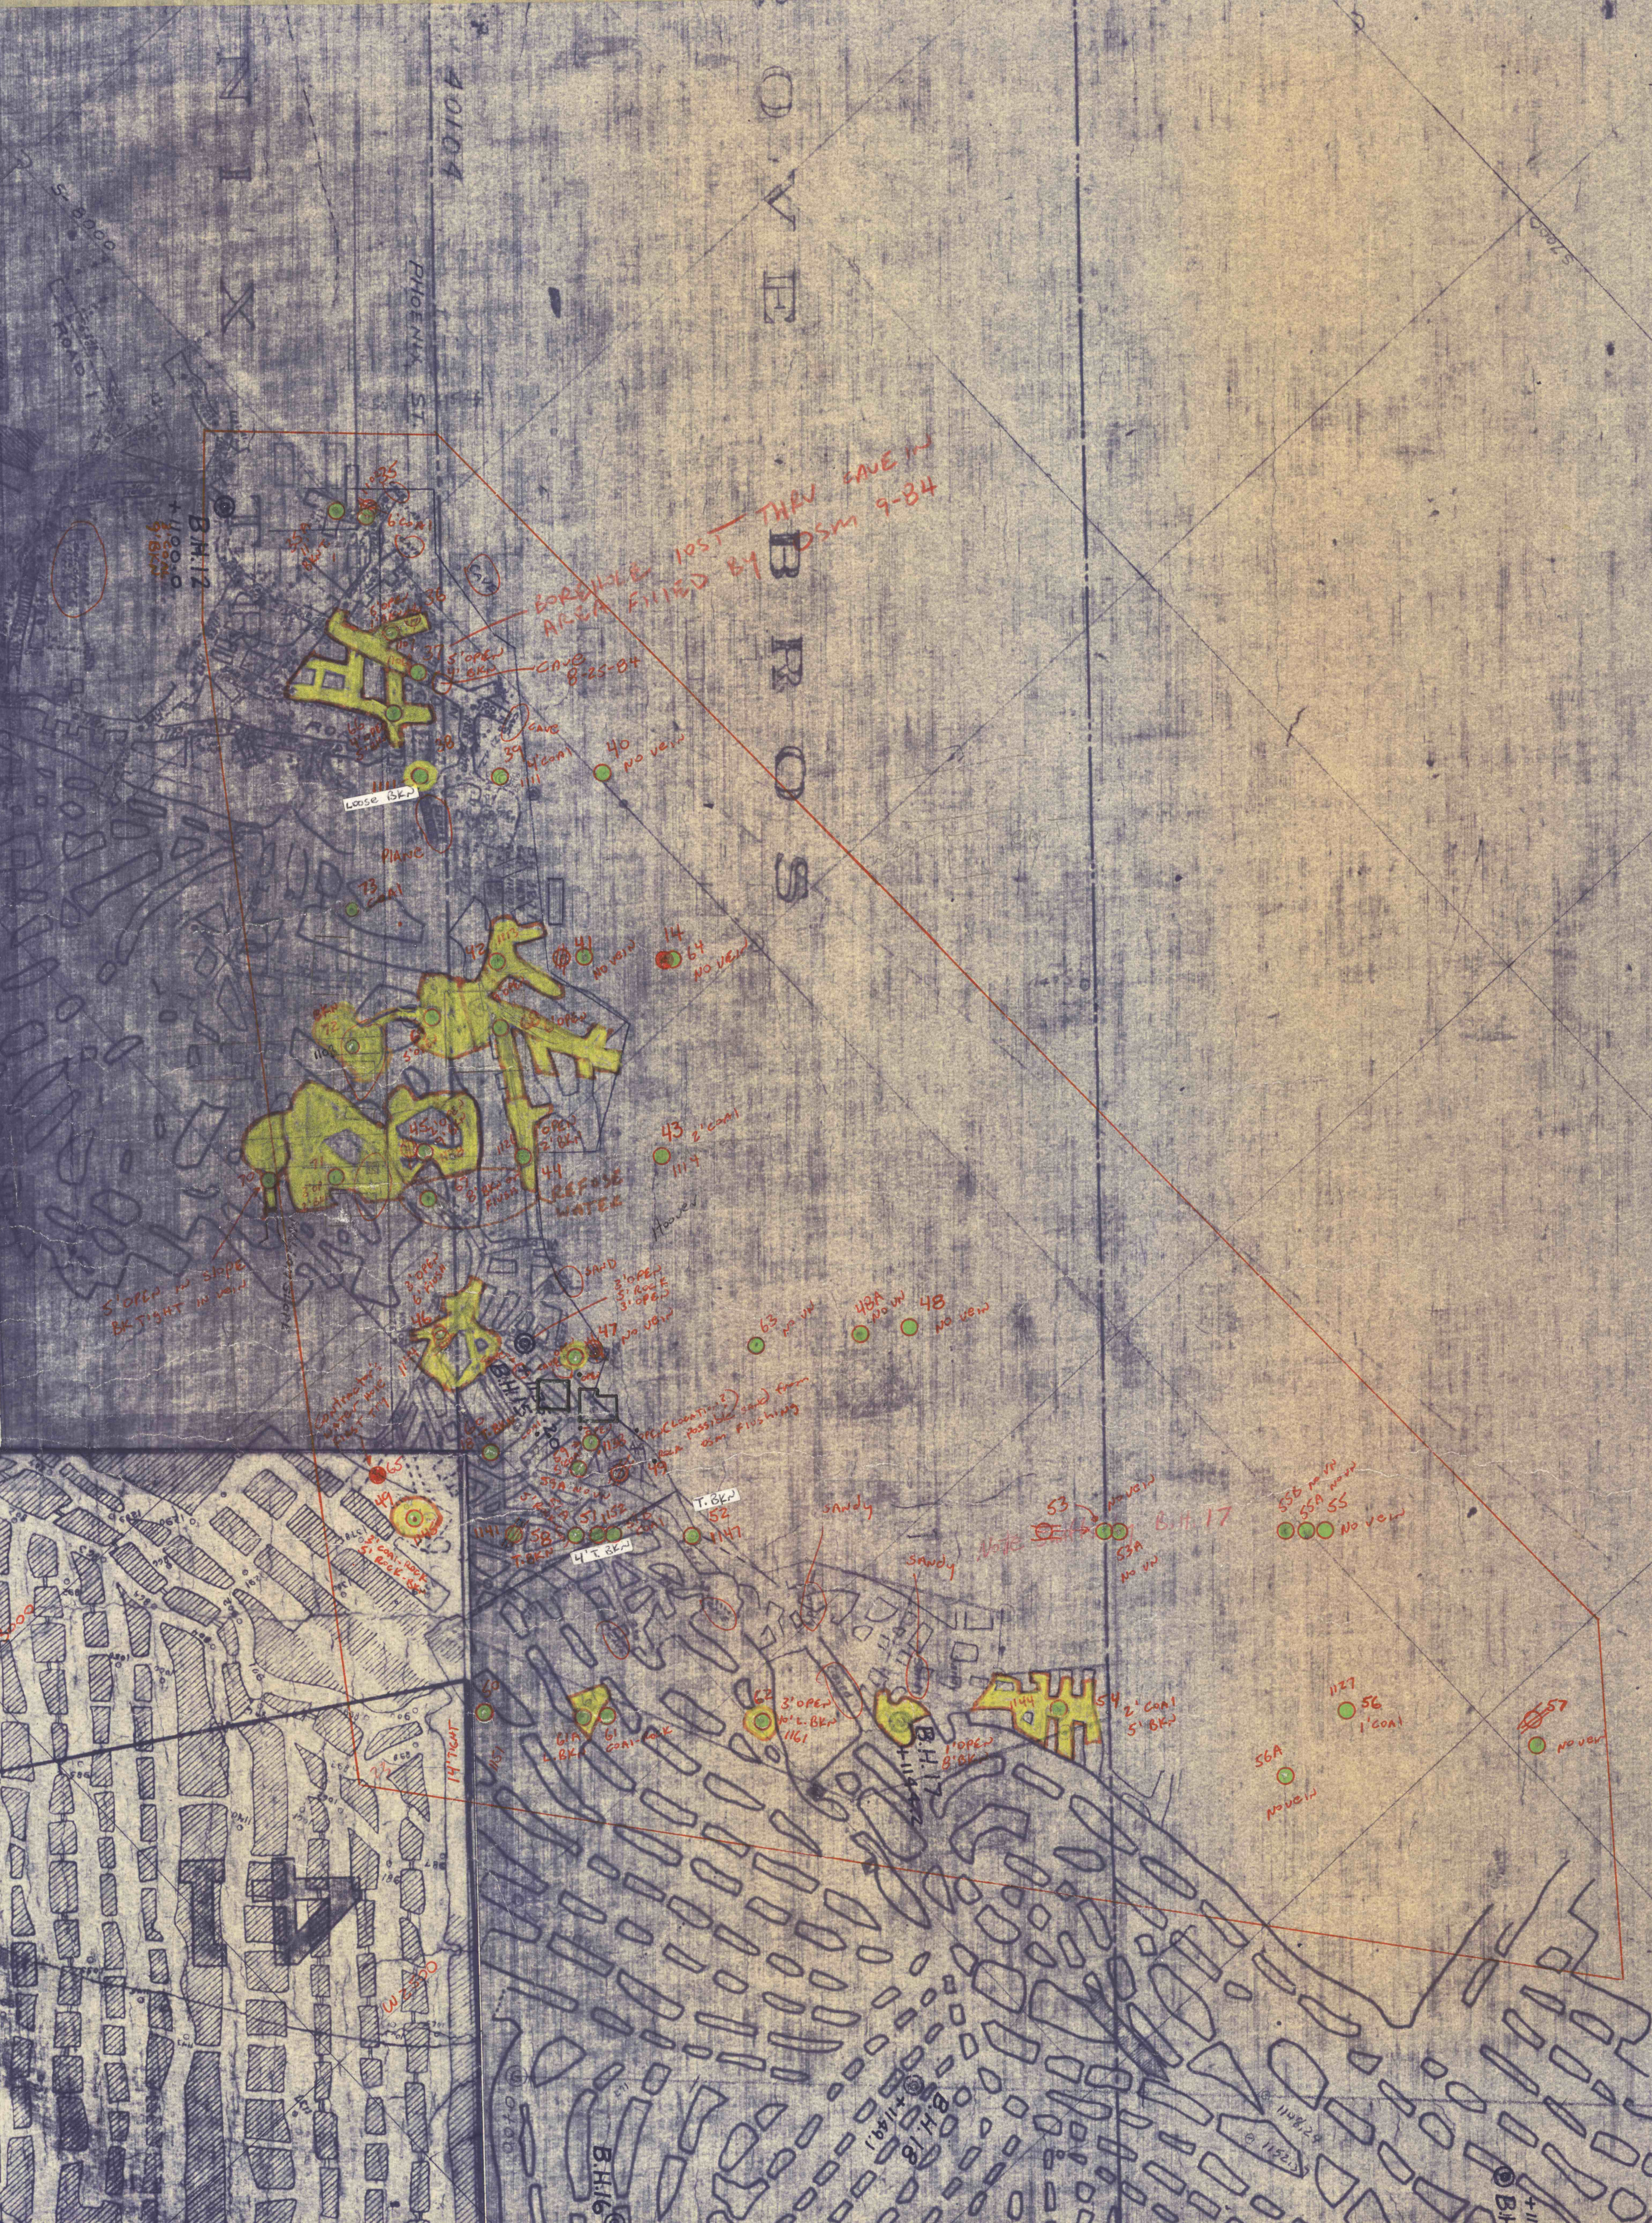

48-9 MISS THRU LANE 11
MAY 9-84
POSSIBLE 1951
AREA FILLED BY

8-23-84

Loose Box

Place

40 no view

43 cont

44

45

46

47

48

49

50

51

52

53

54

55

56

57

58

59

5' open in slope
BETTER in view

3' open










sandy












CHECKER VIEW
USE WITH DWG 306

CHECKER PHOEN