


MIDDLE

SUSQ. COLLIERIES  
GLENALDEN

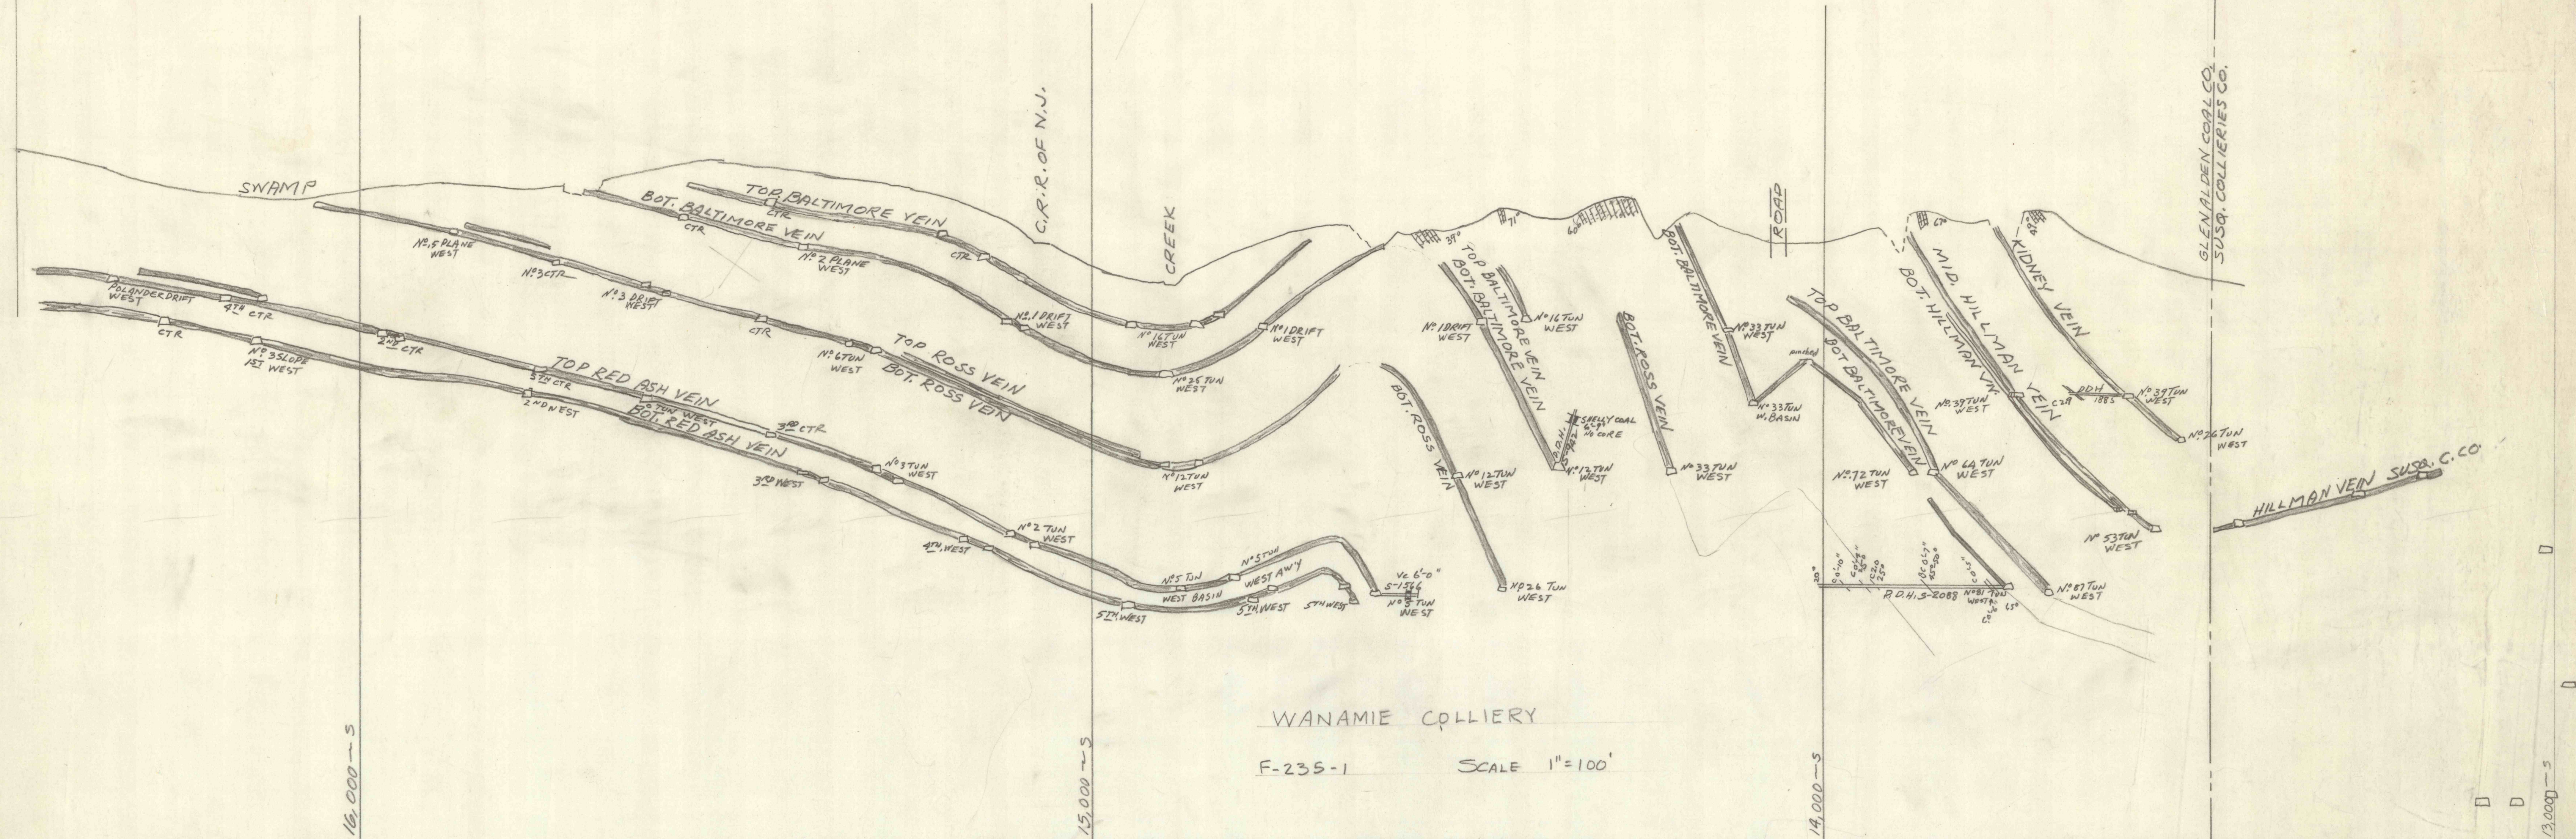

GLENALDEN COAL CO.  
SUSQ. COLLIERIES CO.

WANAMIE COLLIERY

F-235-1 SCALE 1"=100'

WANAMIE WINE CISE AREA

7-26-71