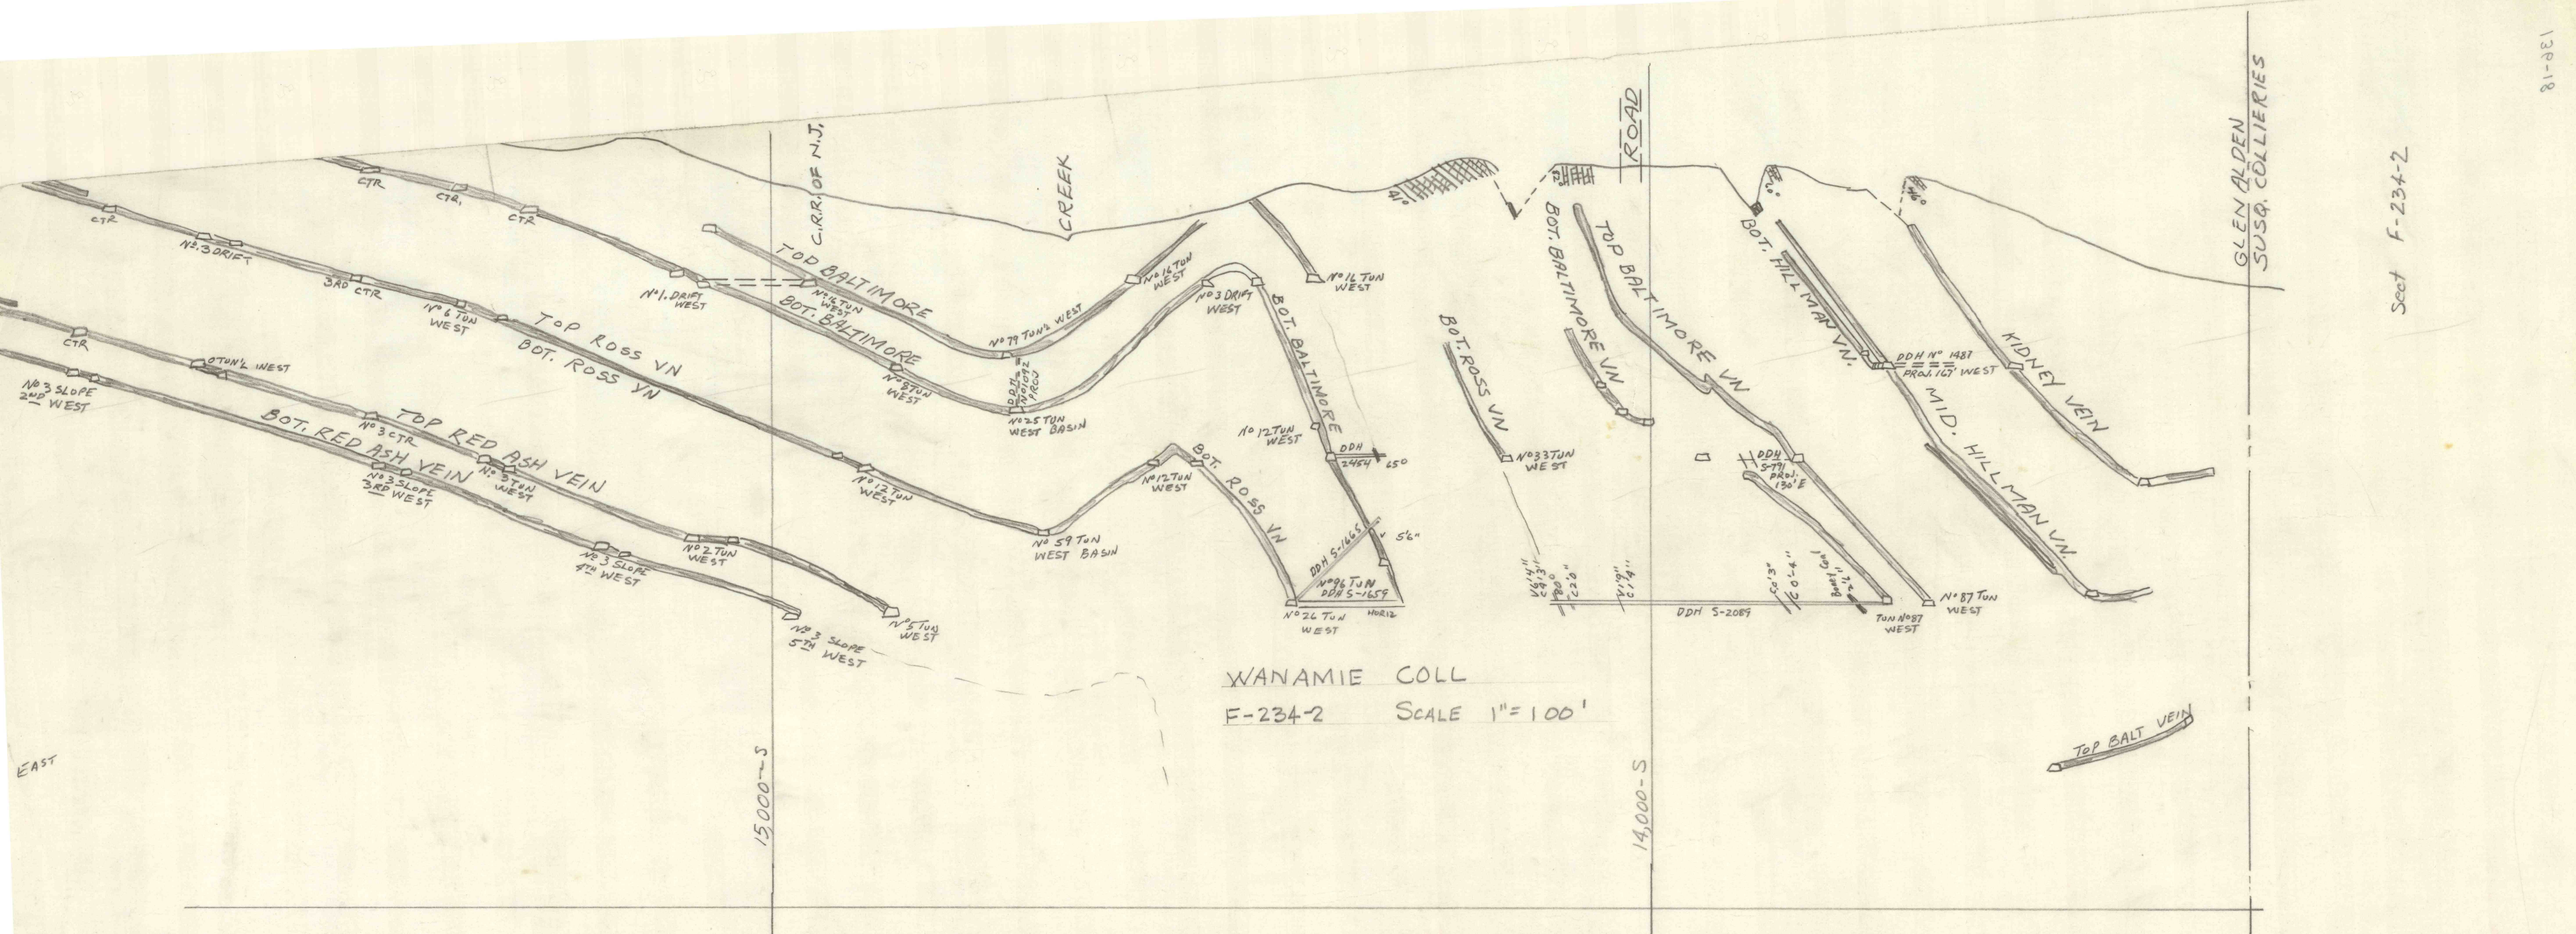

WANAMIE COLL

F-234-2 SCALE 1"=100'

Sect F-234-2

138-18