
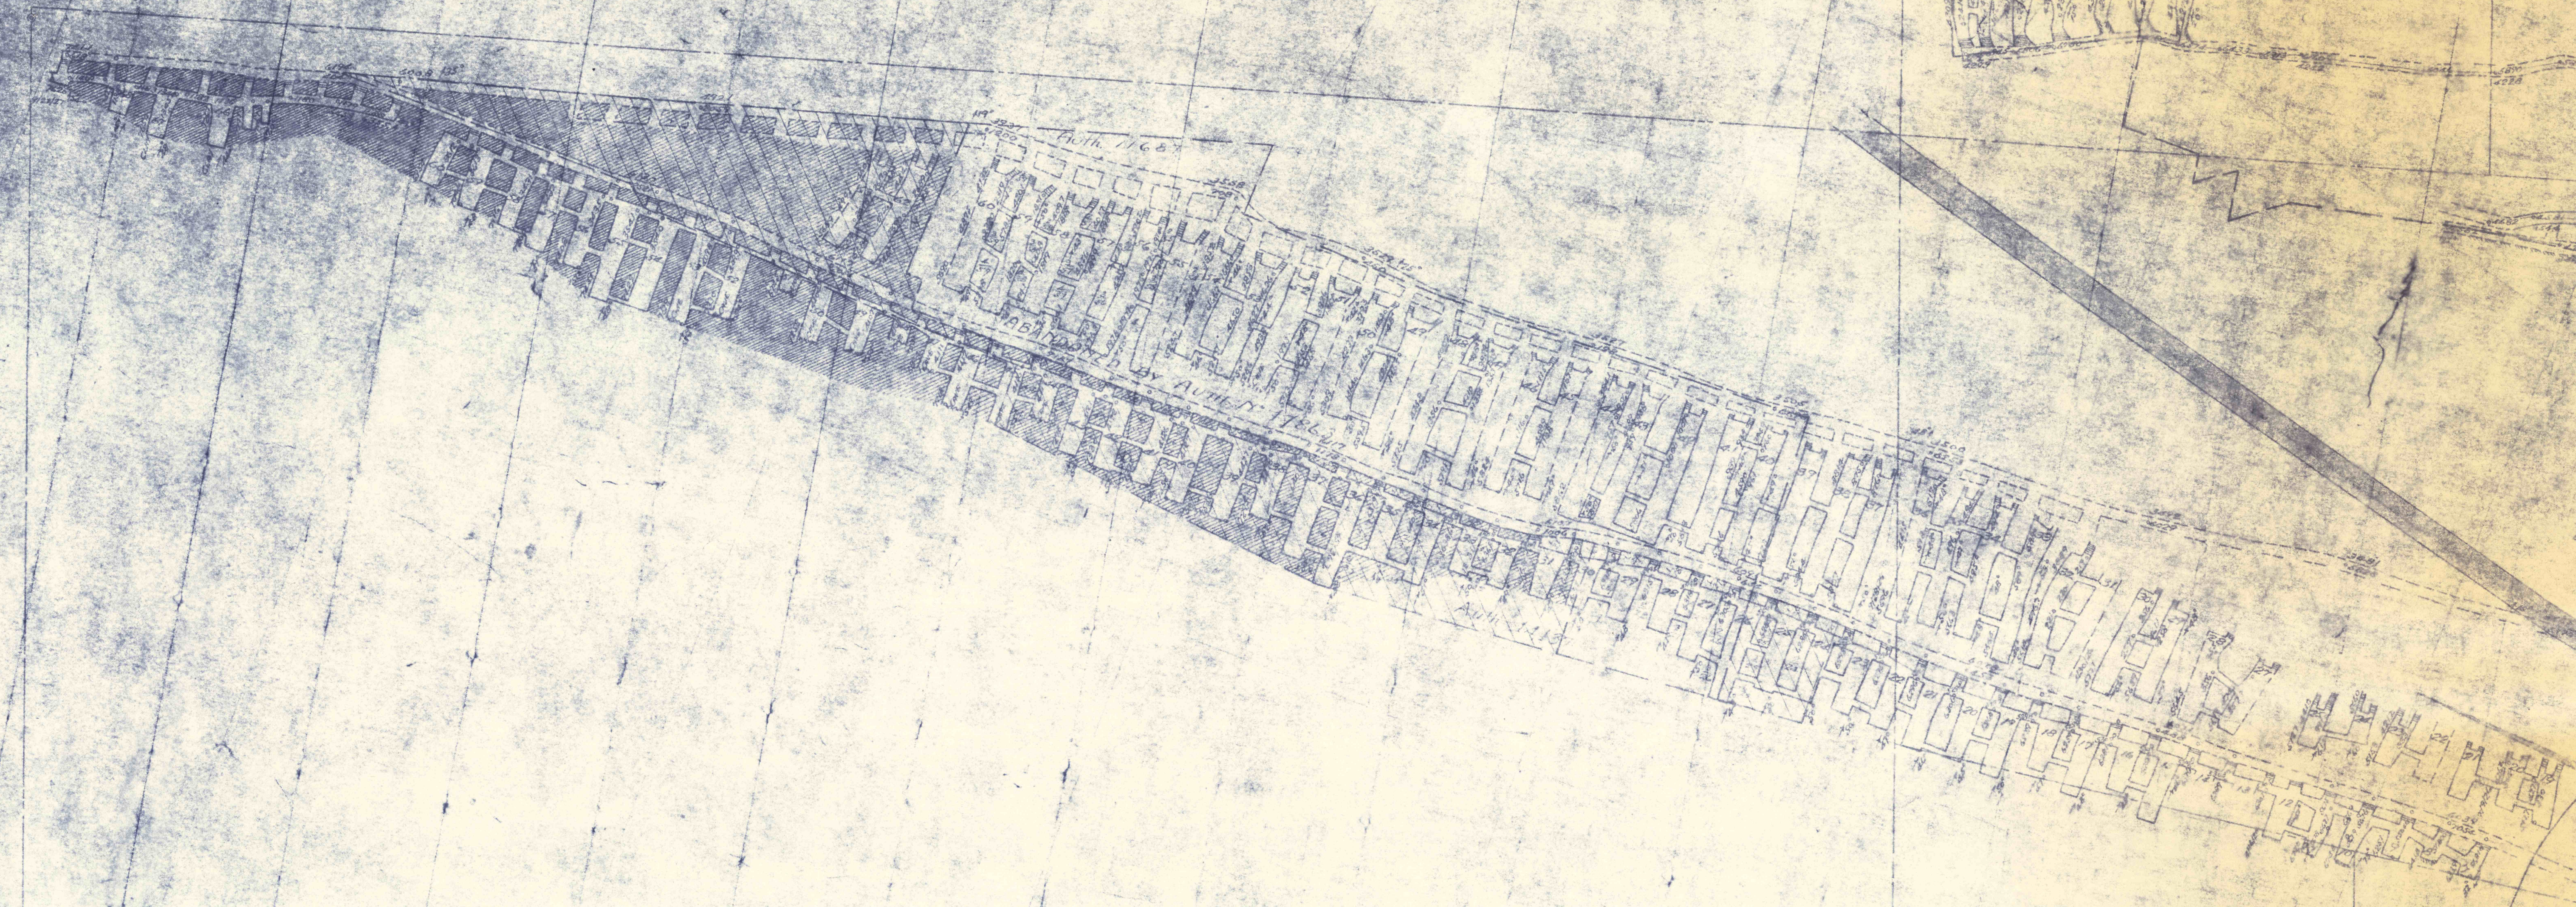


BOTTOM EMERGENCY AREA

SAFETY ZONE

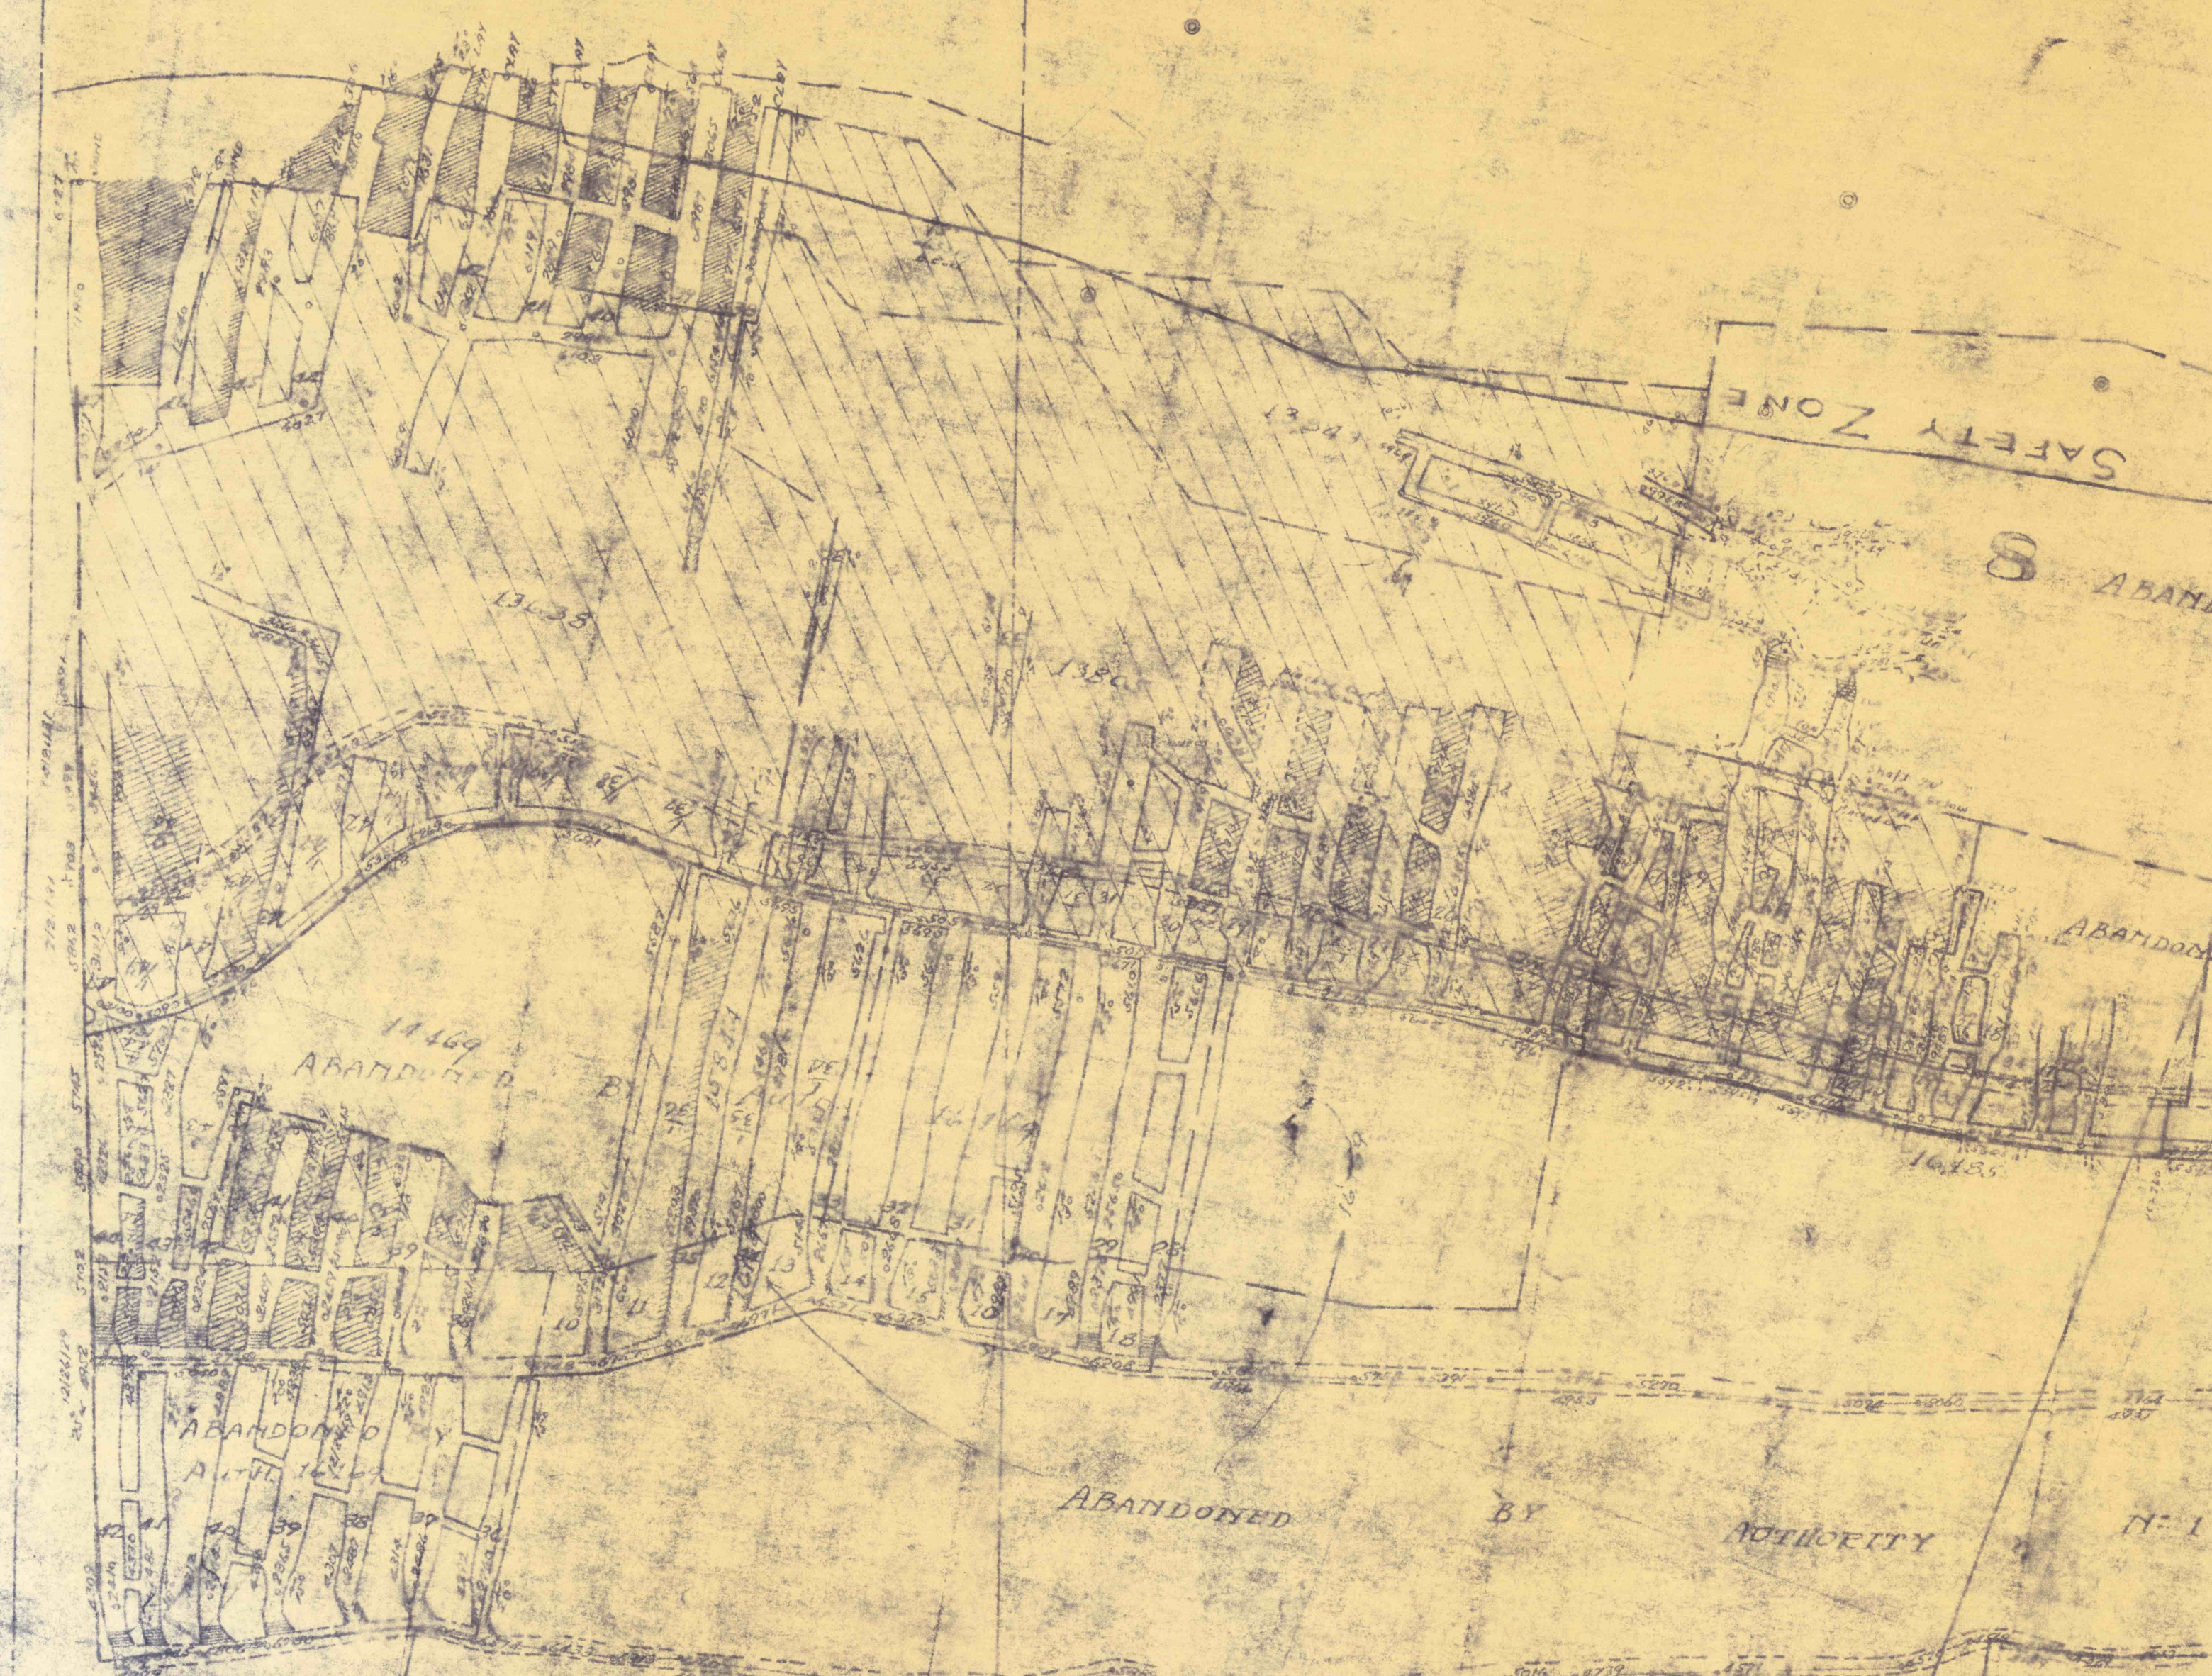

16

18

17

18

General Bot. Hillman
Lance @ Glen Lyon

PACING NO 1