



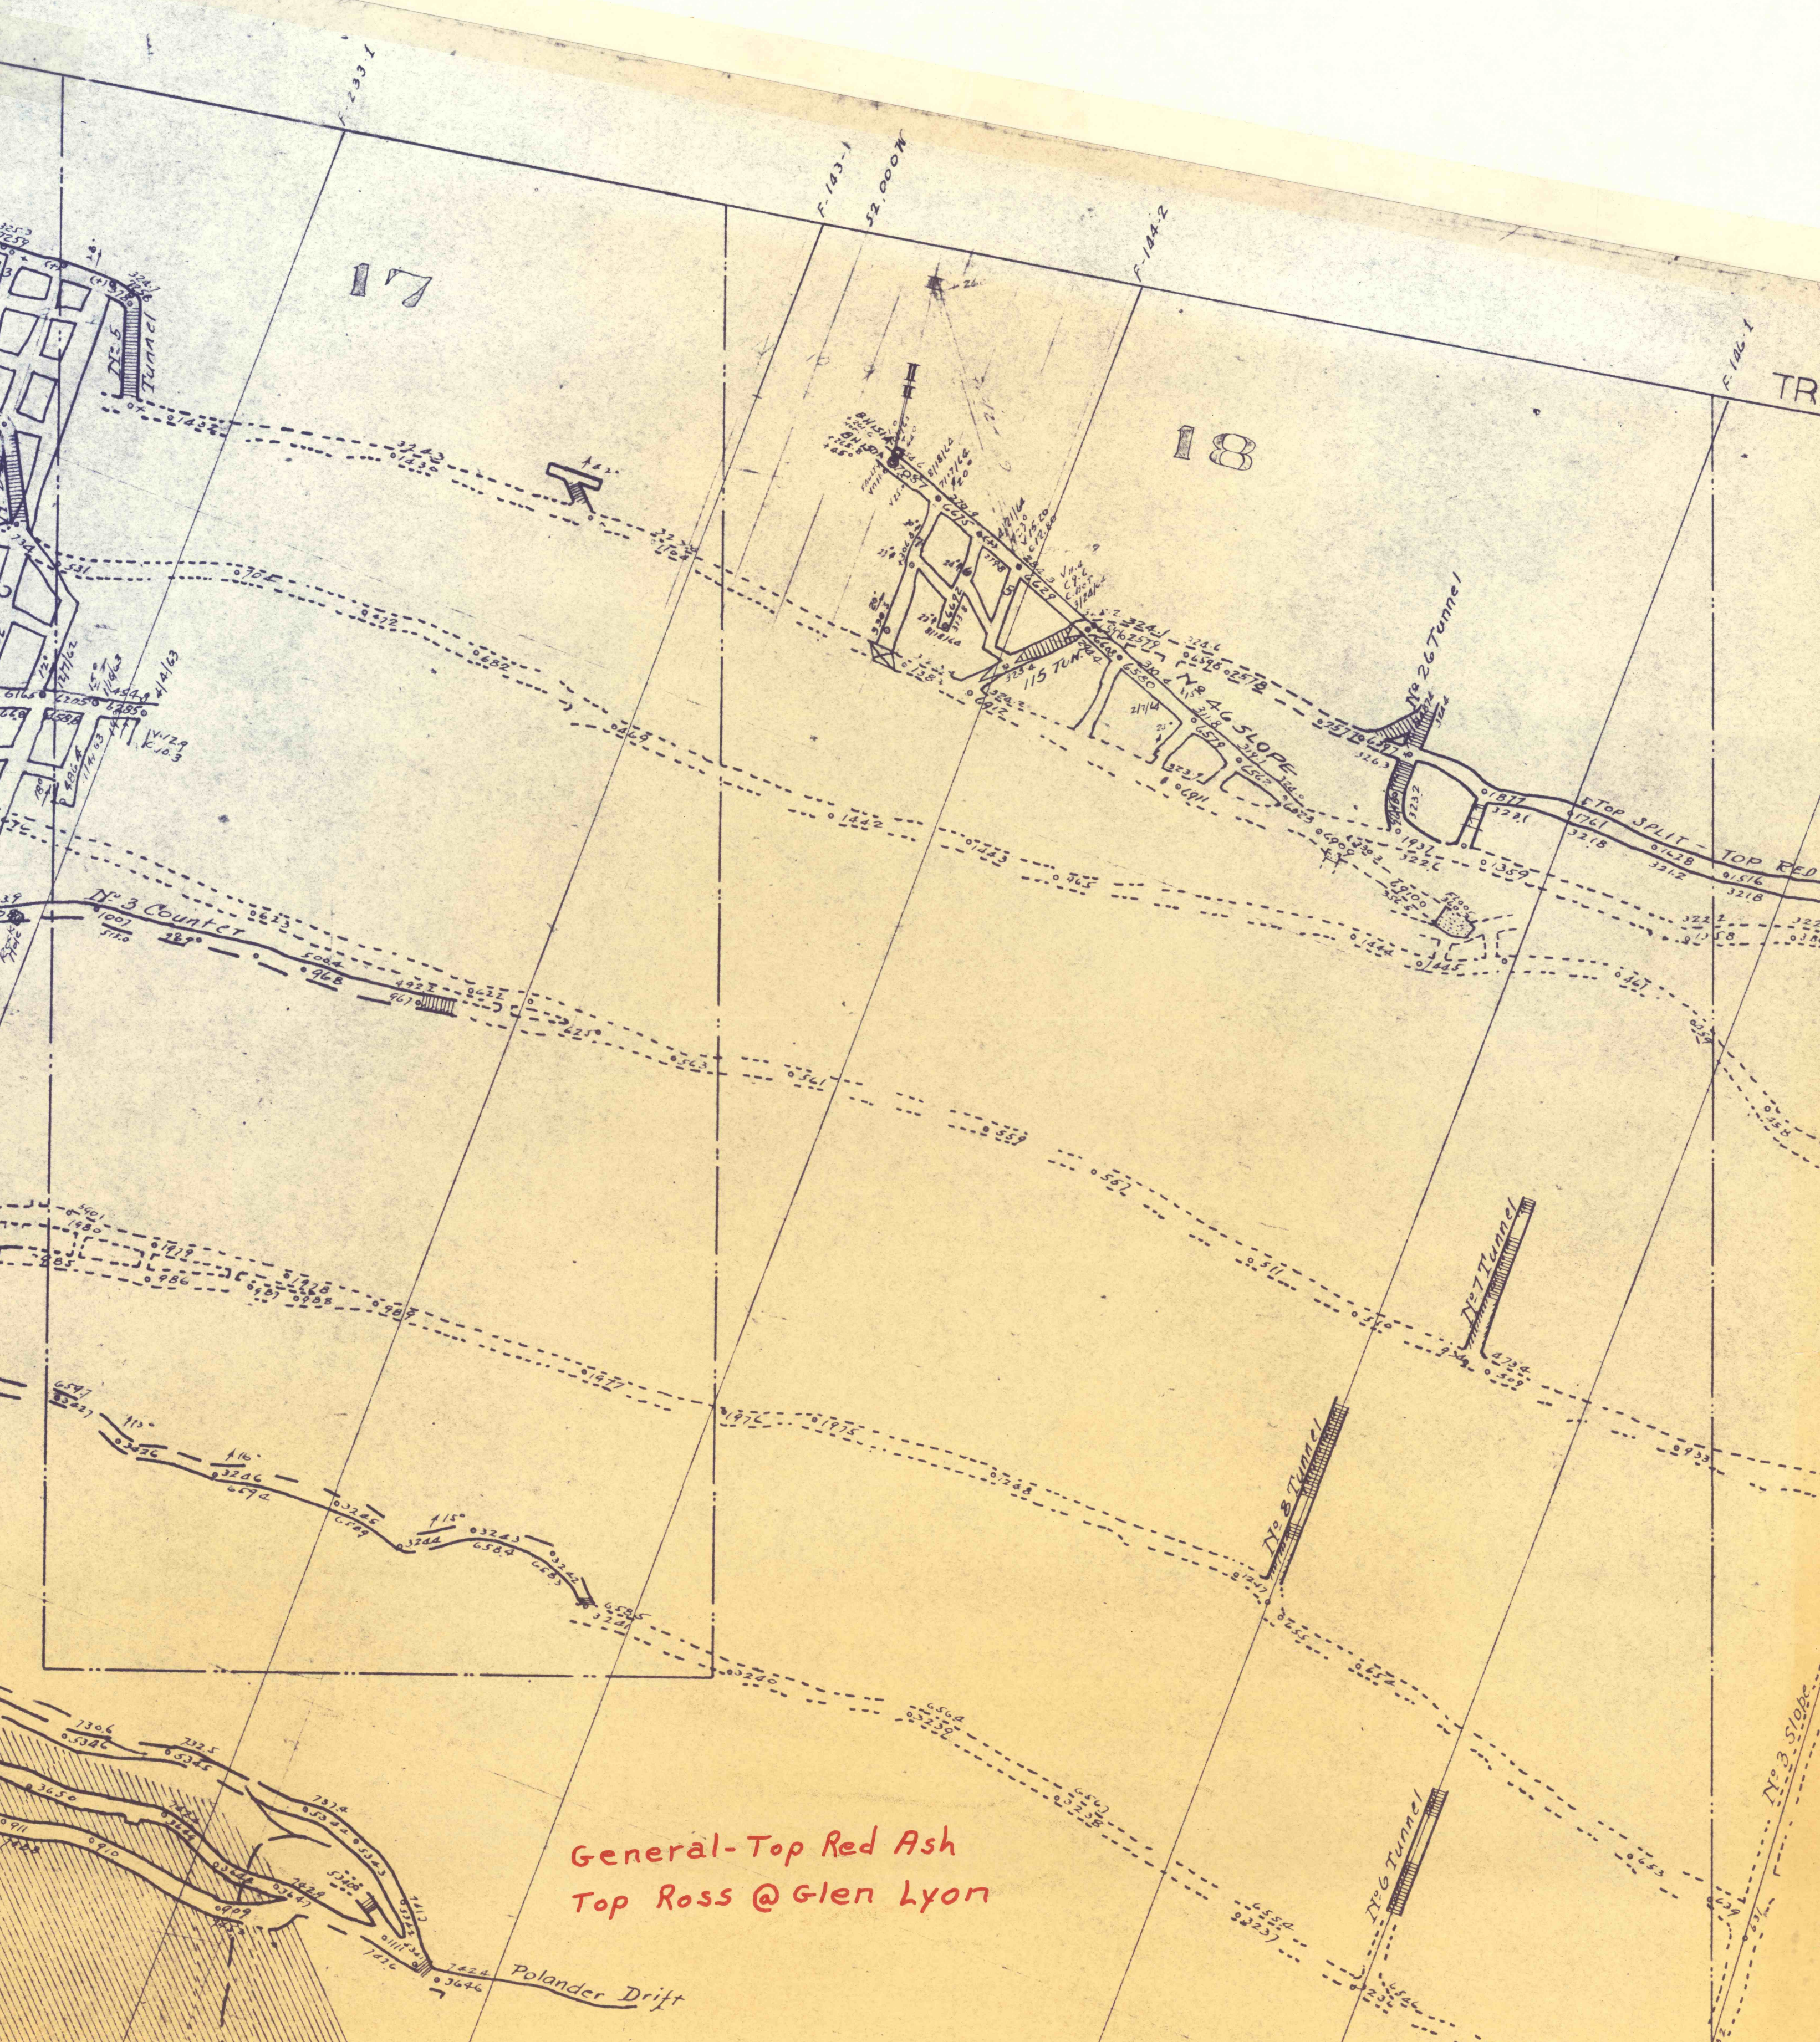

COAL LIERIES CO.  
LIERY  
S-MIDDLE SECTION  
DEC. 1940

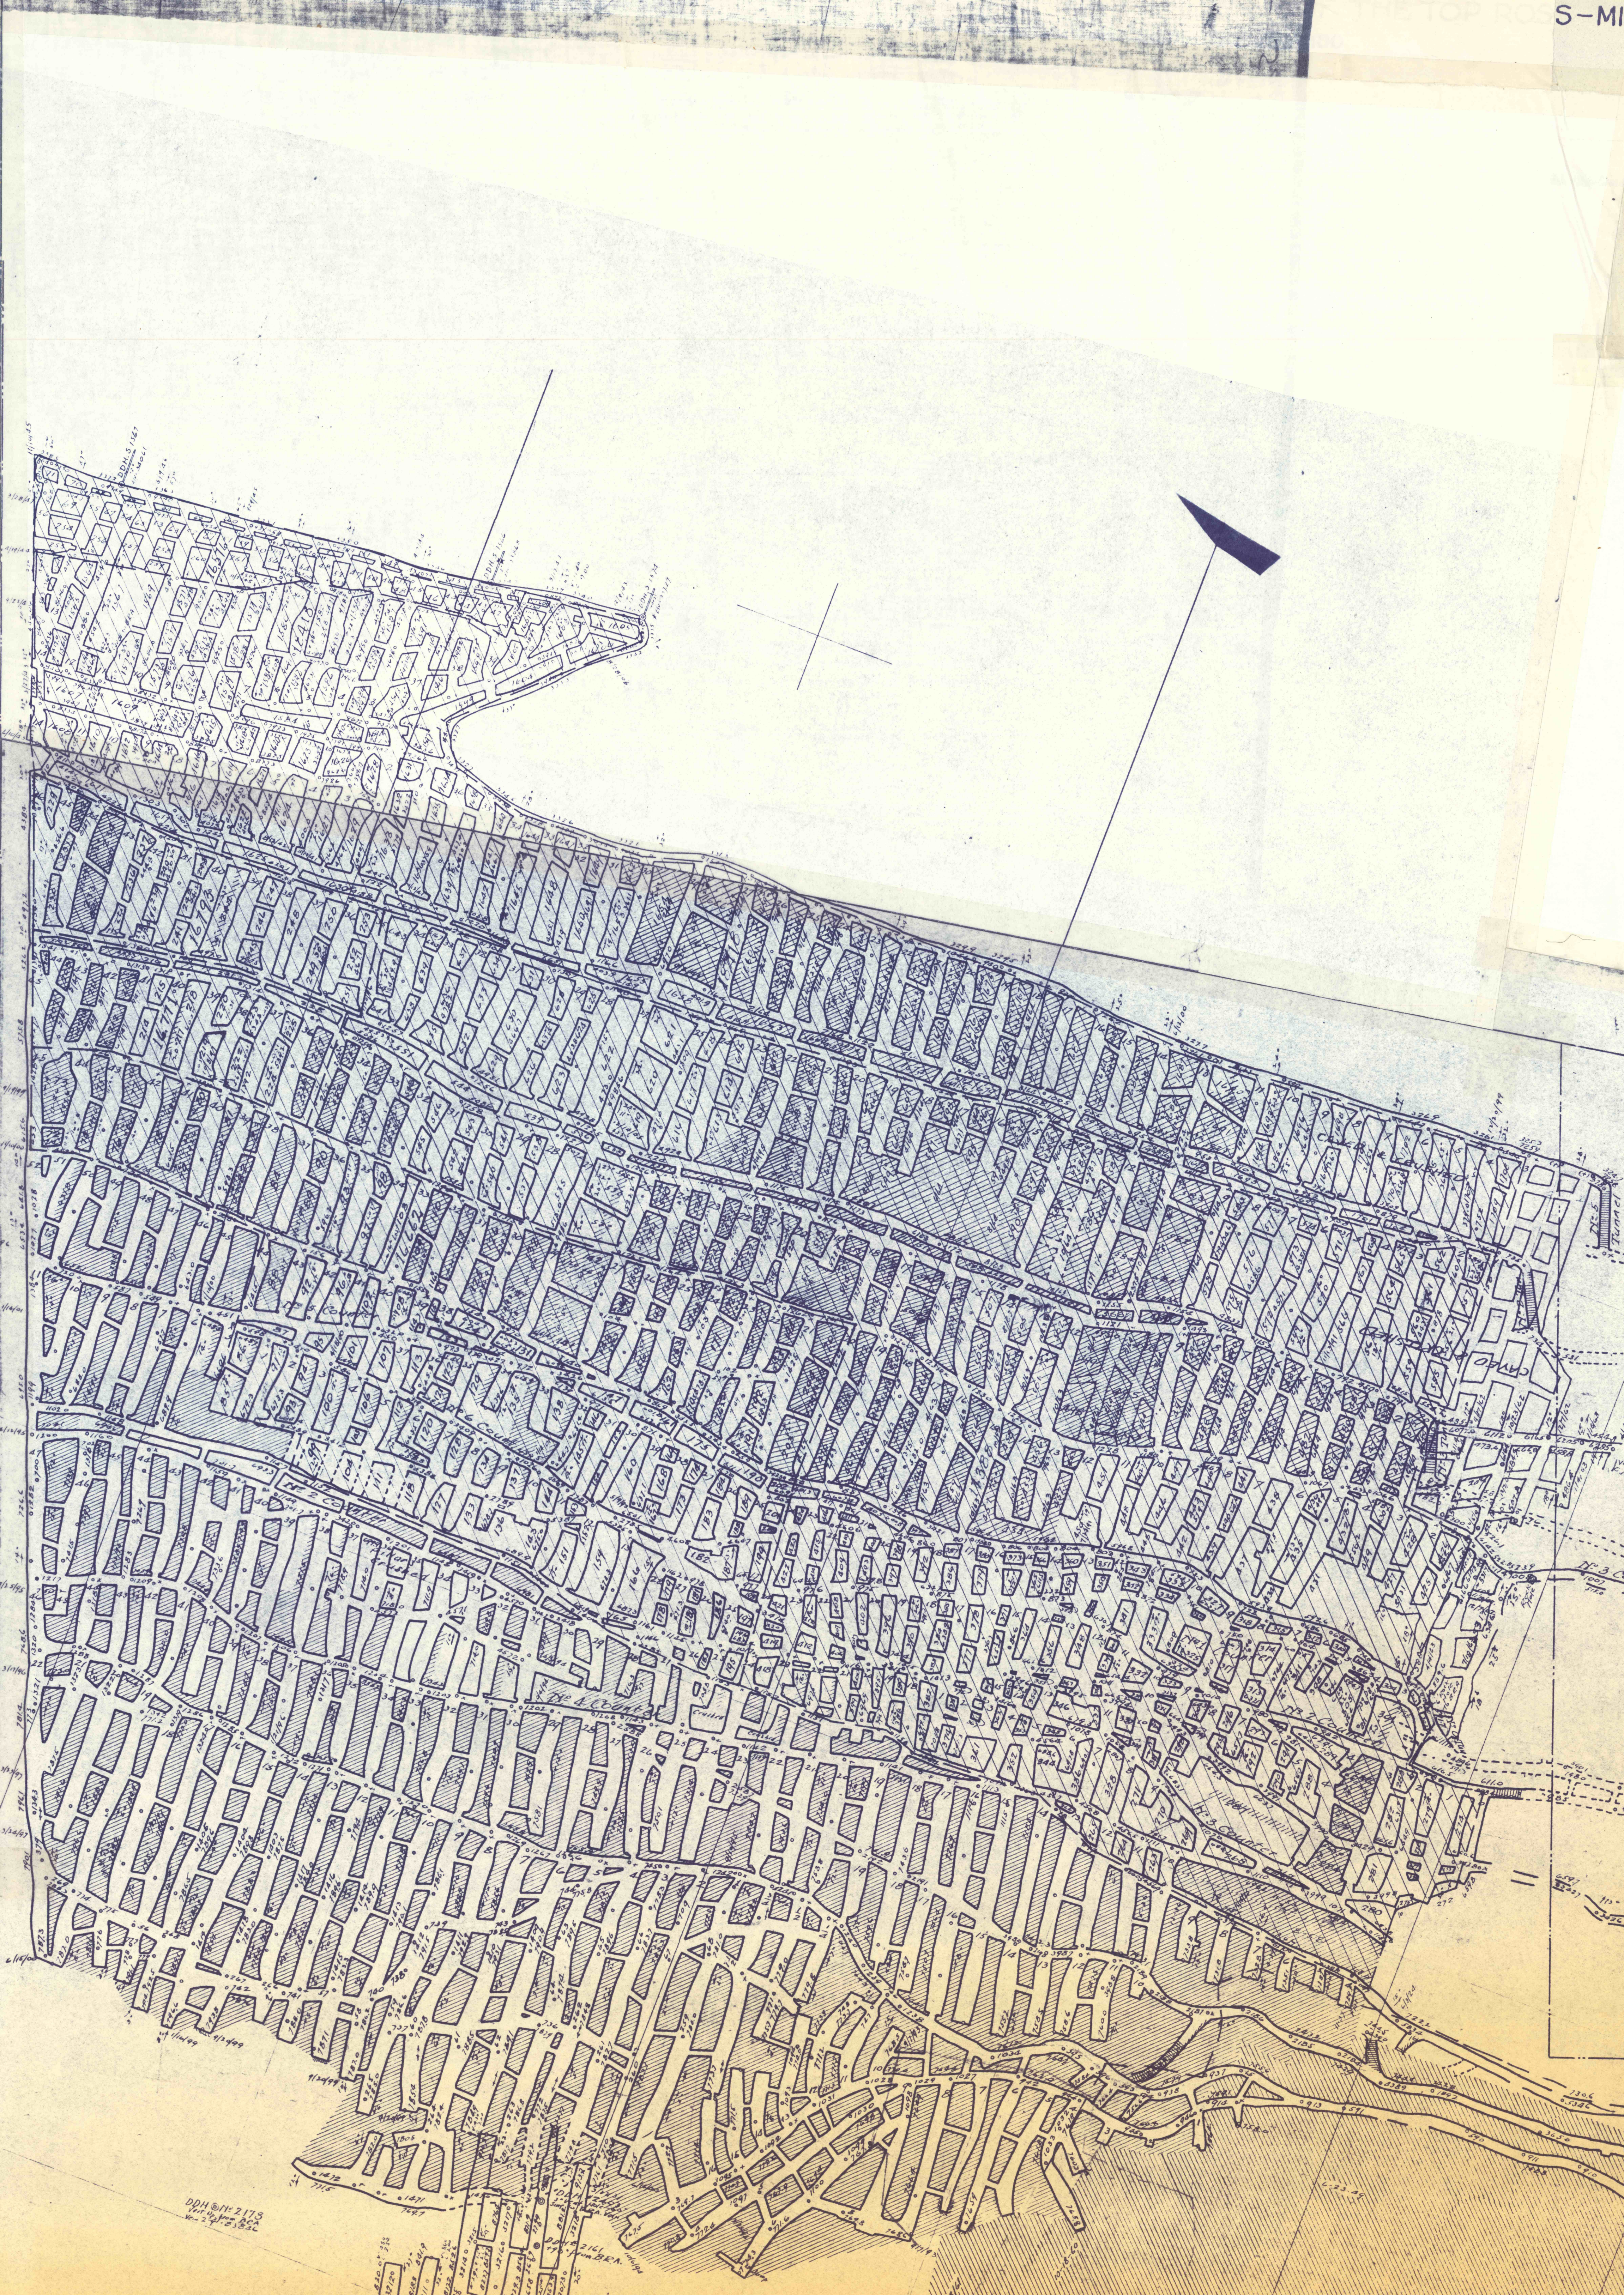

General-Top Red Ash  
Top Ross @ Glen Lyon