


WANAMIE MINE FIRE
1" = 100'

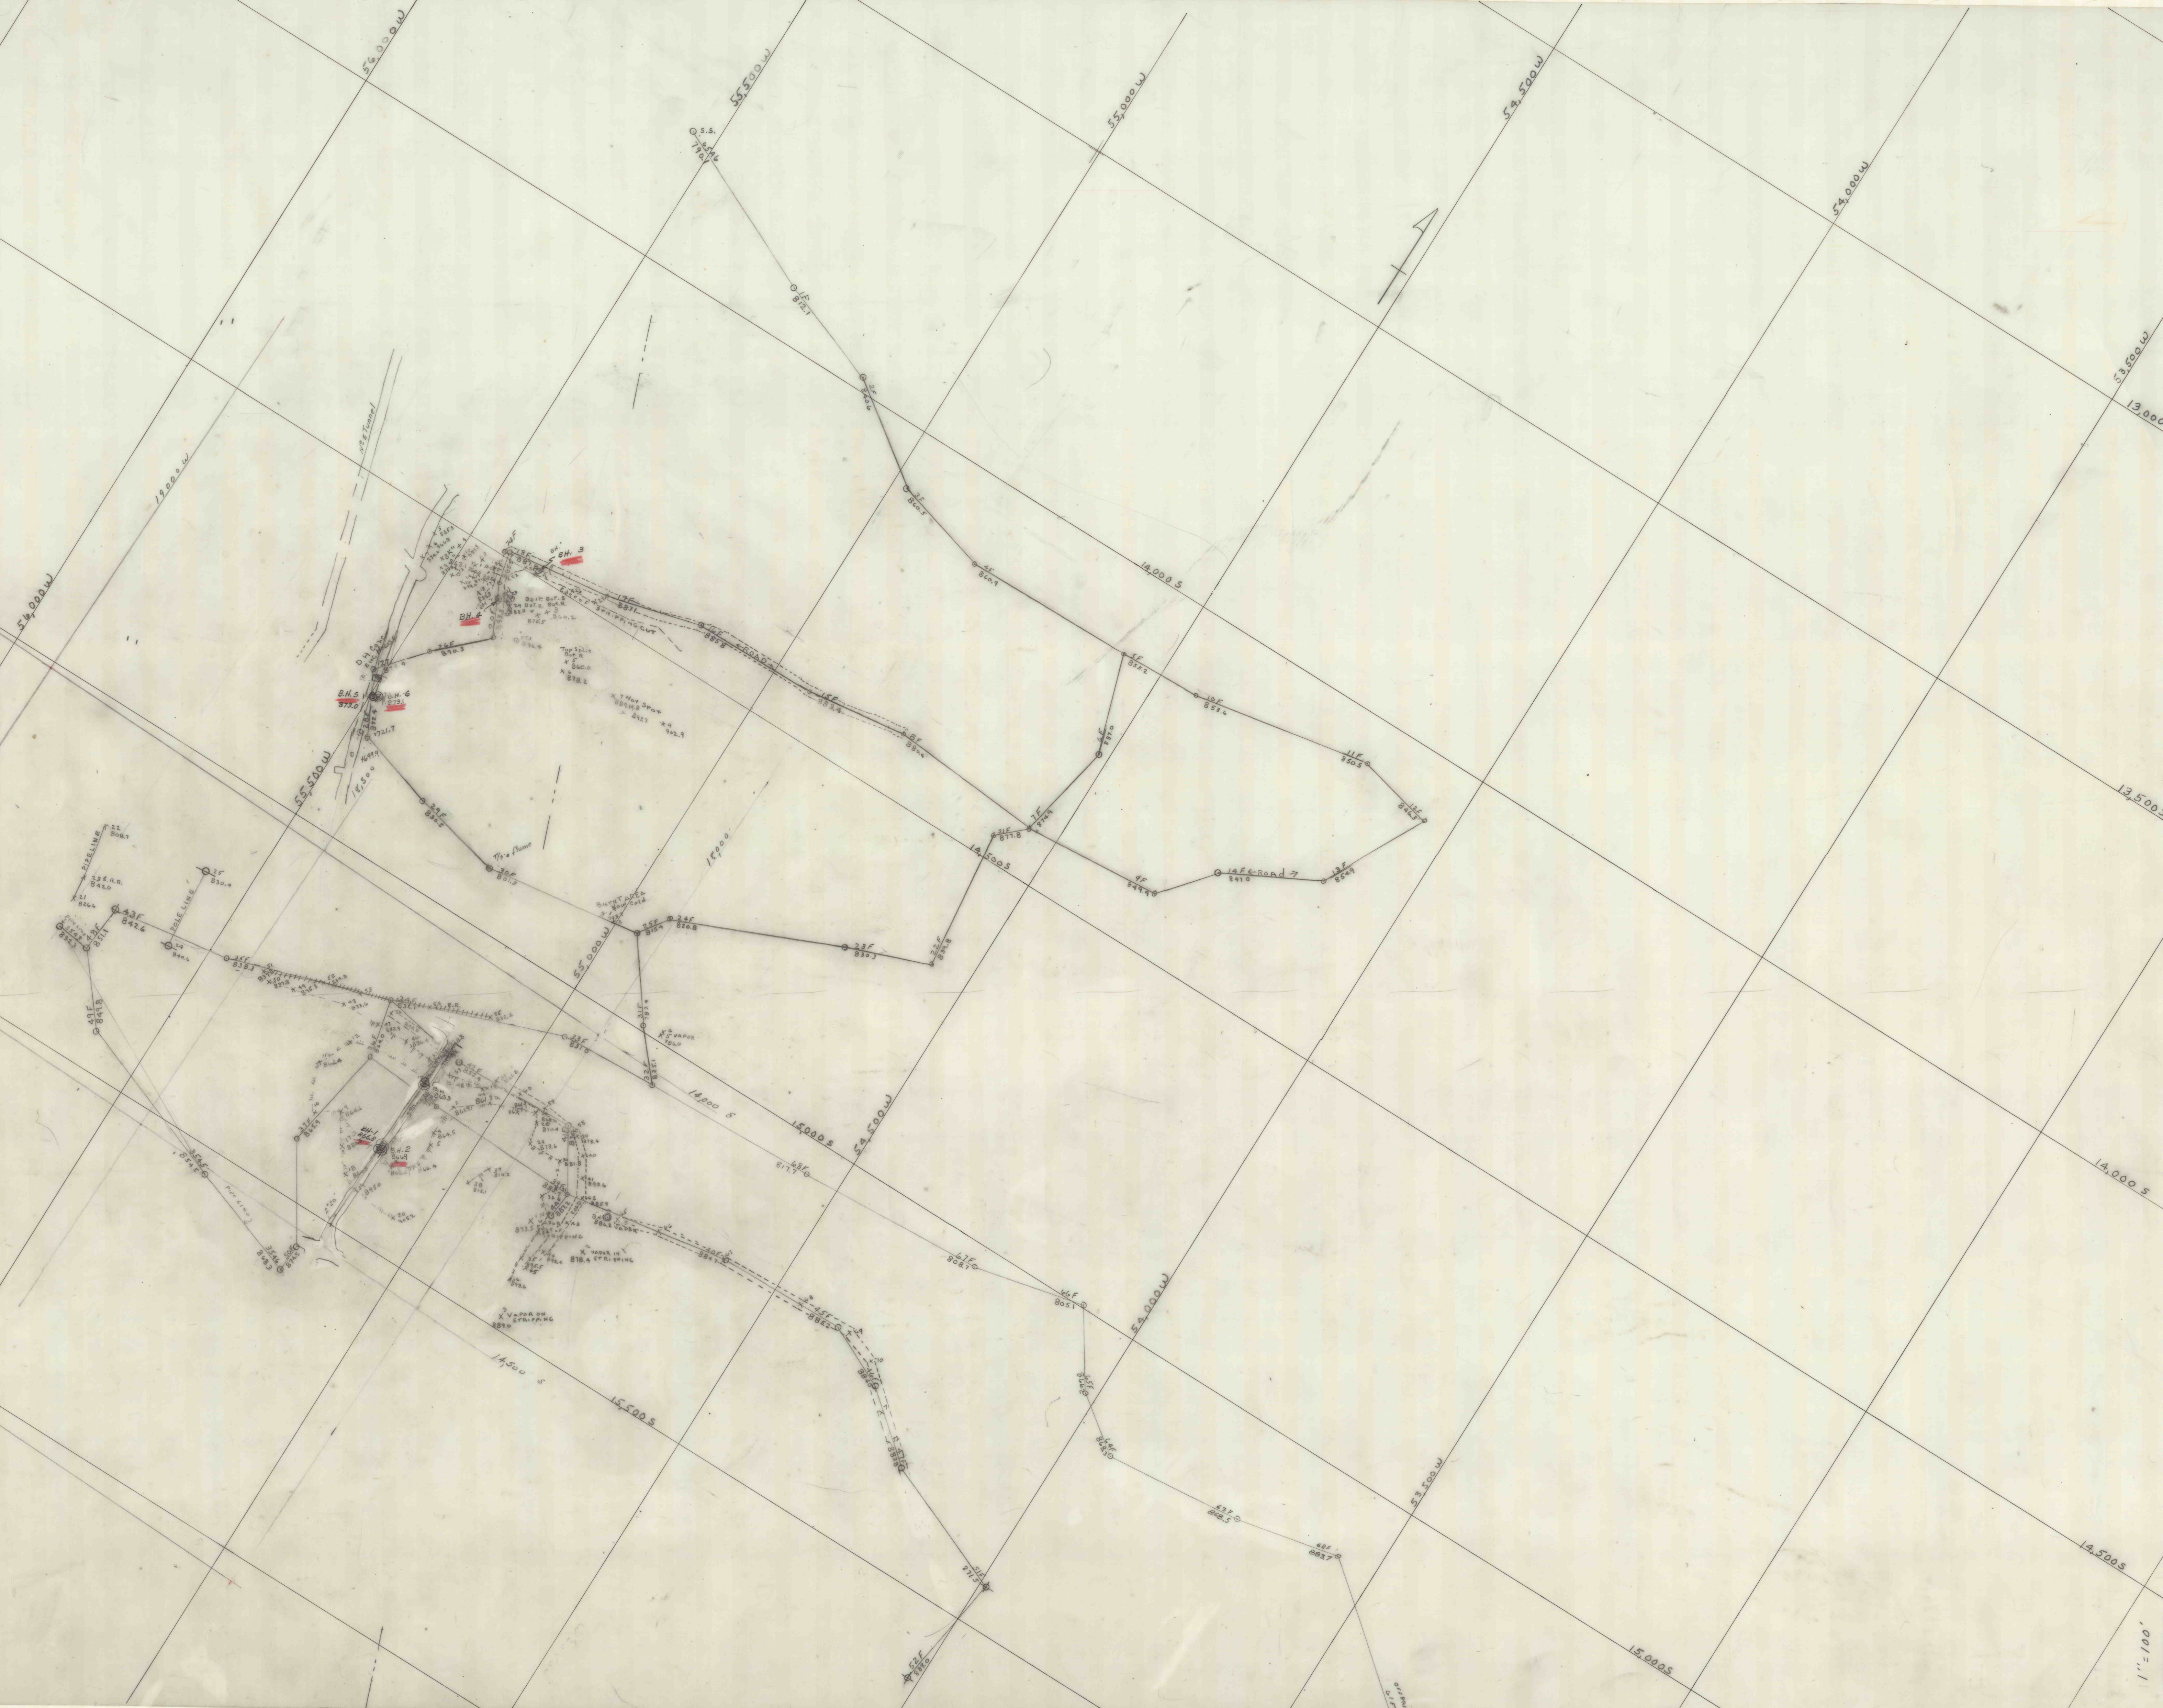

WANAMIE MINE FIRE
1" = 100'