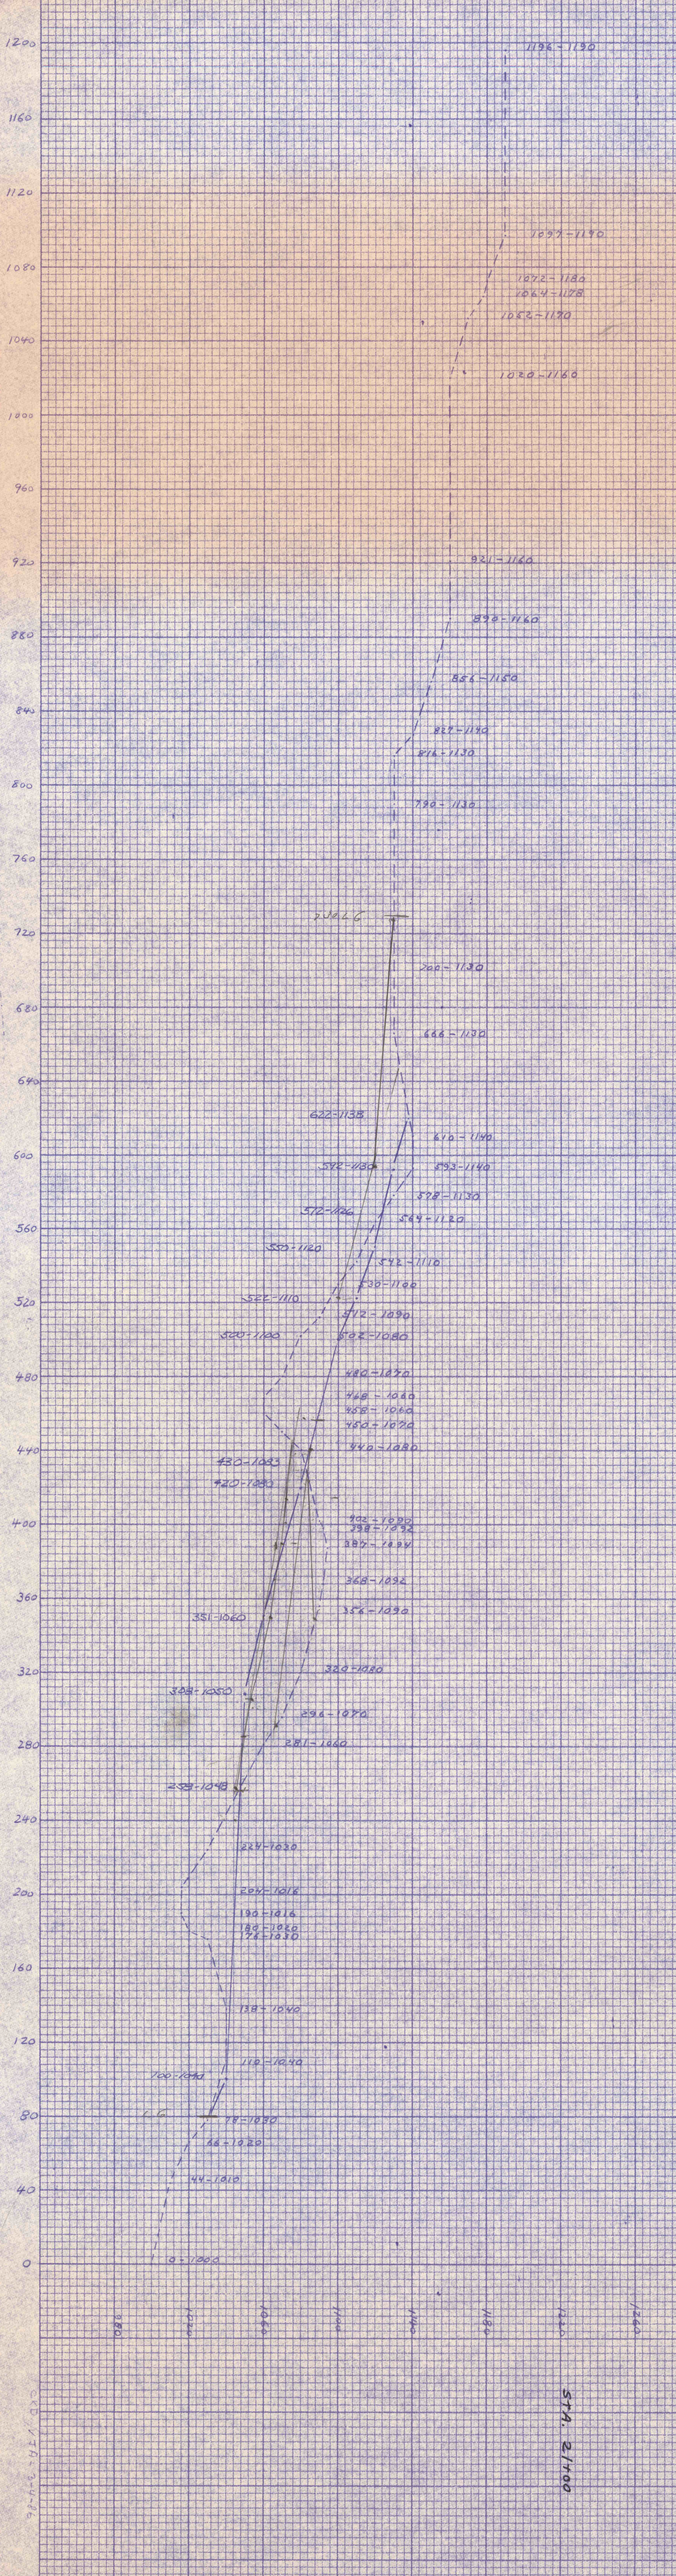
1200
1160
1120
1080
1040
1000
960
920
880
840
800
760
720
680
640
600
560
520
480
440
400
360
320
280
240
200
160
120
80
40
0
1196-1190
1097-1190
1072-1180
1064-1178
1052-1170
1020-1160
921-1160
898-1160
856-1150
827-1140
816-1130
780-1130
FUEL G
700-1130
666-1130
622-1135
610-1140
593-1140
578-1130
564-1120
572-1100
550-1120
542-1110
530-1100
522-1110
512-1090
500-1100
502-1080
480-1070
468-1060
458-1060
450-1070
440-1080
430-1085
420-1080
402-1090
398-1092
387-1092
368-1092
356-1090
351-1060
320-1080
308-1050
296-1070
281-1060
258-1048
224-1030
204-1016
190-1016
180-1020
176-1030
138-1040
110-1040
100-1040
CG
78-1030
66-1020
44-1010
0-1000
STA. 2/100