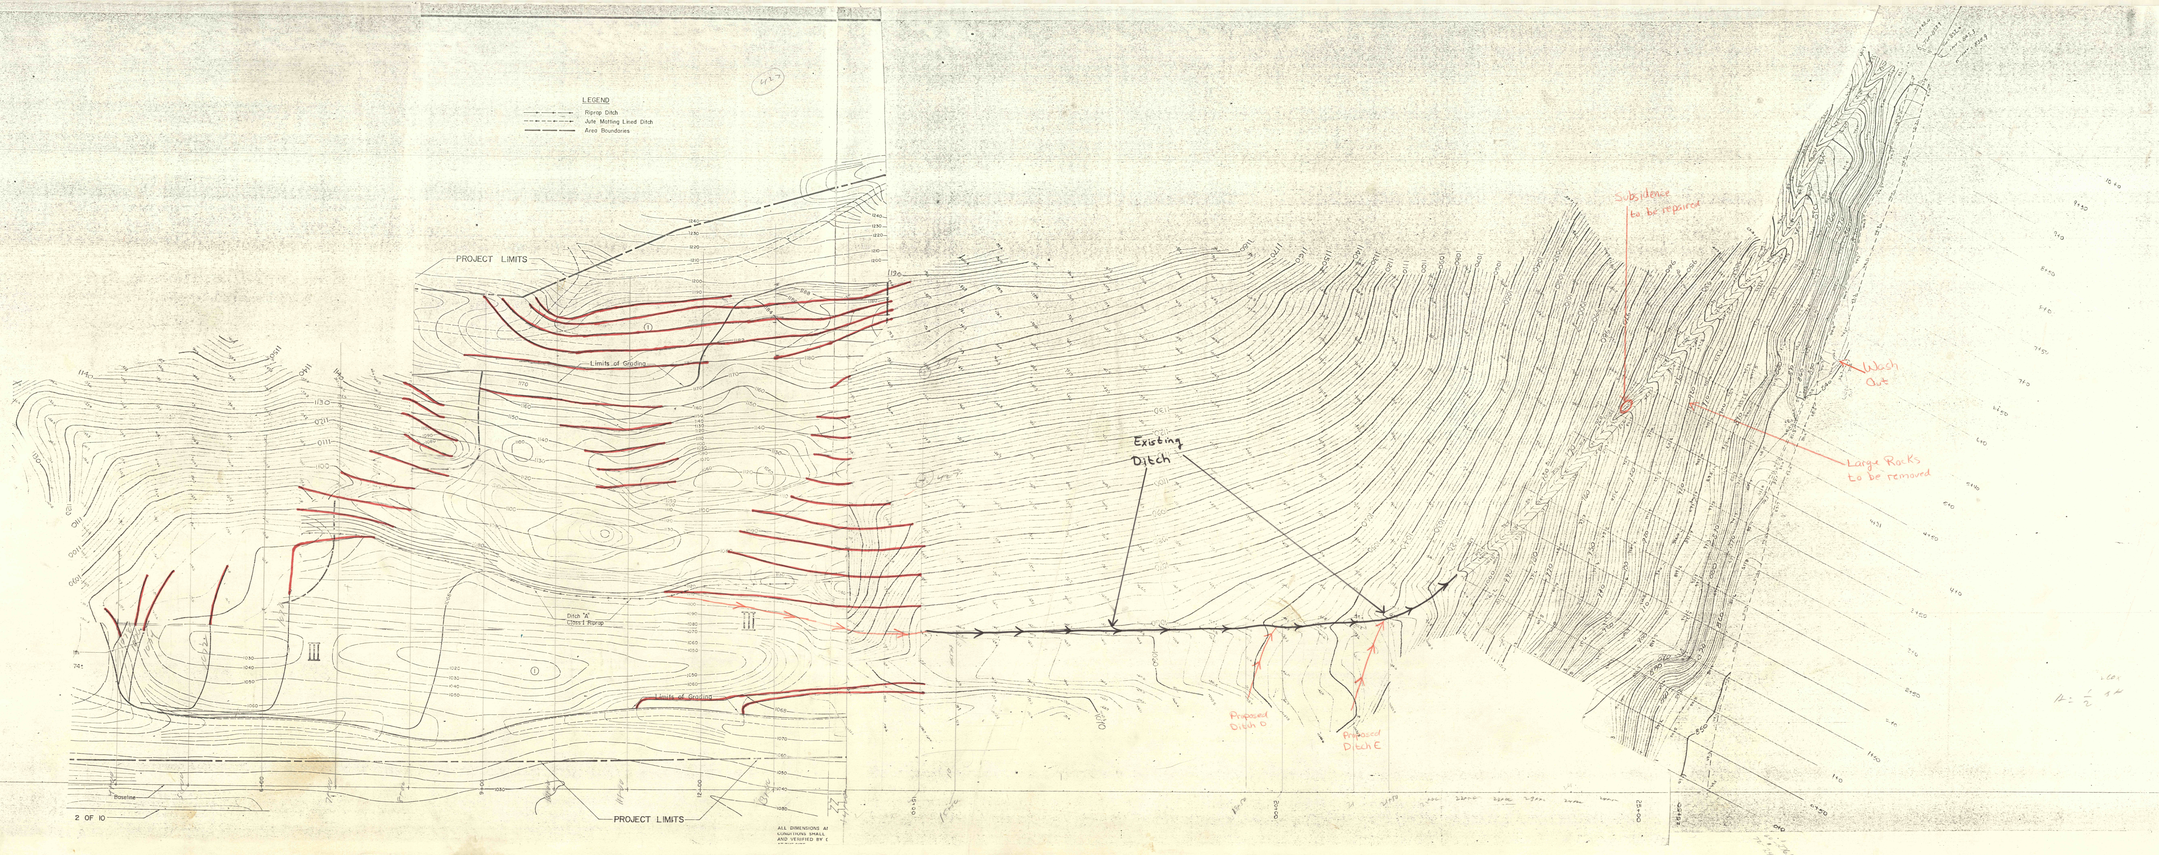

ASHTON
USM 54(32A) 10.1
Scale 1" = 50'