

1000
EST 14
5920

EST 1

4480


926
EST 13
TOTAL 3/20

PRINTED IN U.S.A.

ENGINEERED BY
10 X 10 - ONE INCH
SCALE - 1" = 100'

PRINTED IN U.S.A.

ENGINEERED BY
10 X 10 - ONE INCH
SCALE - 1" = 100'

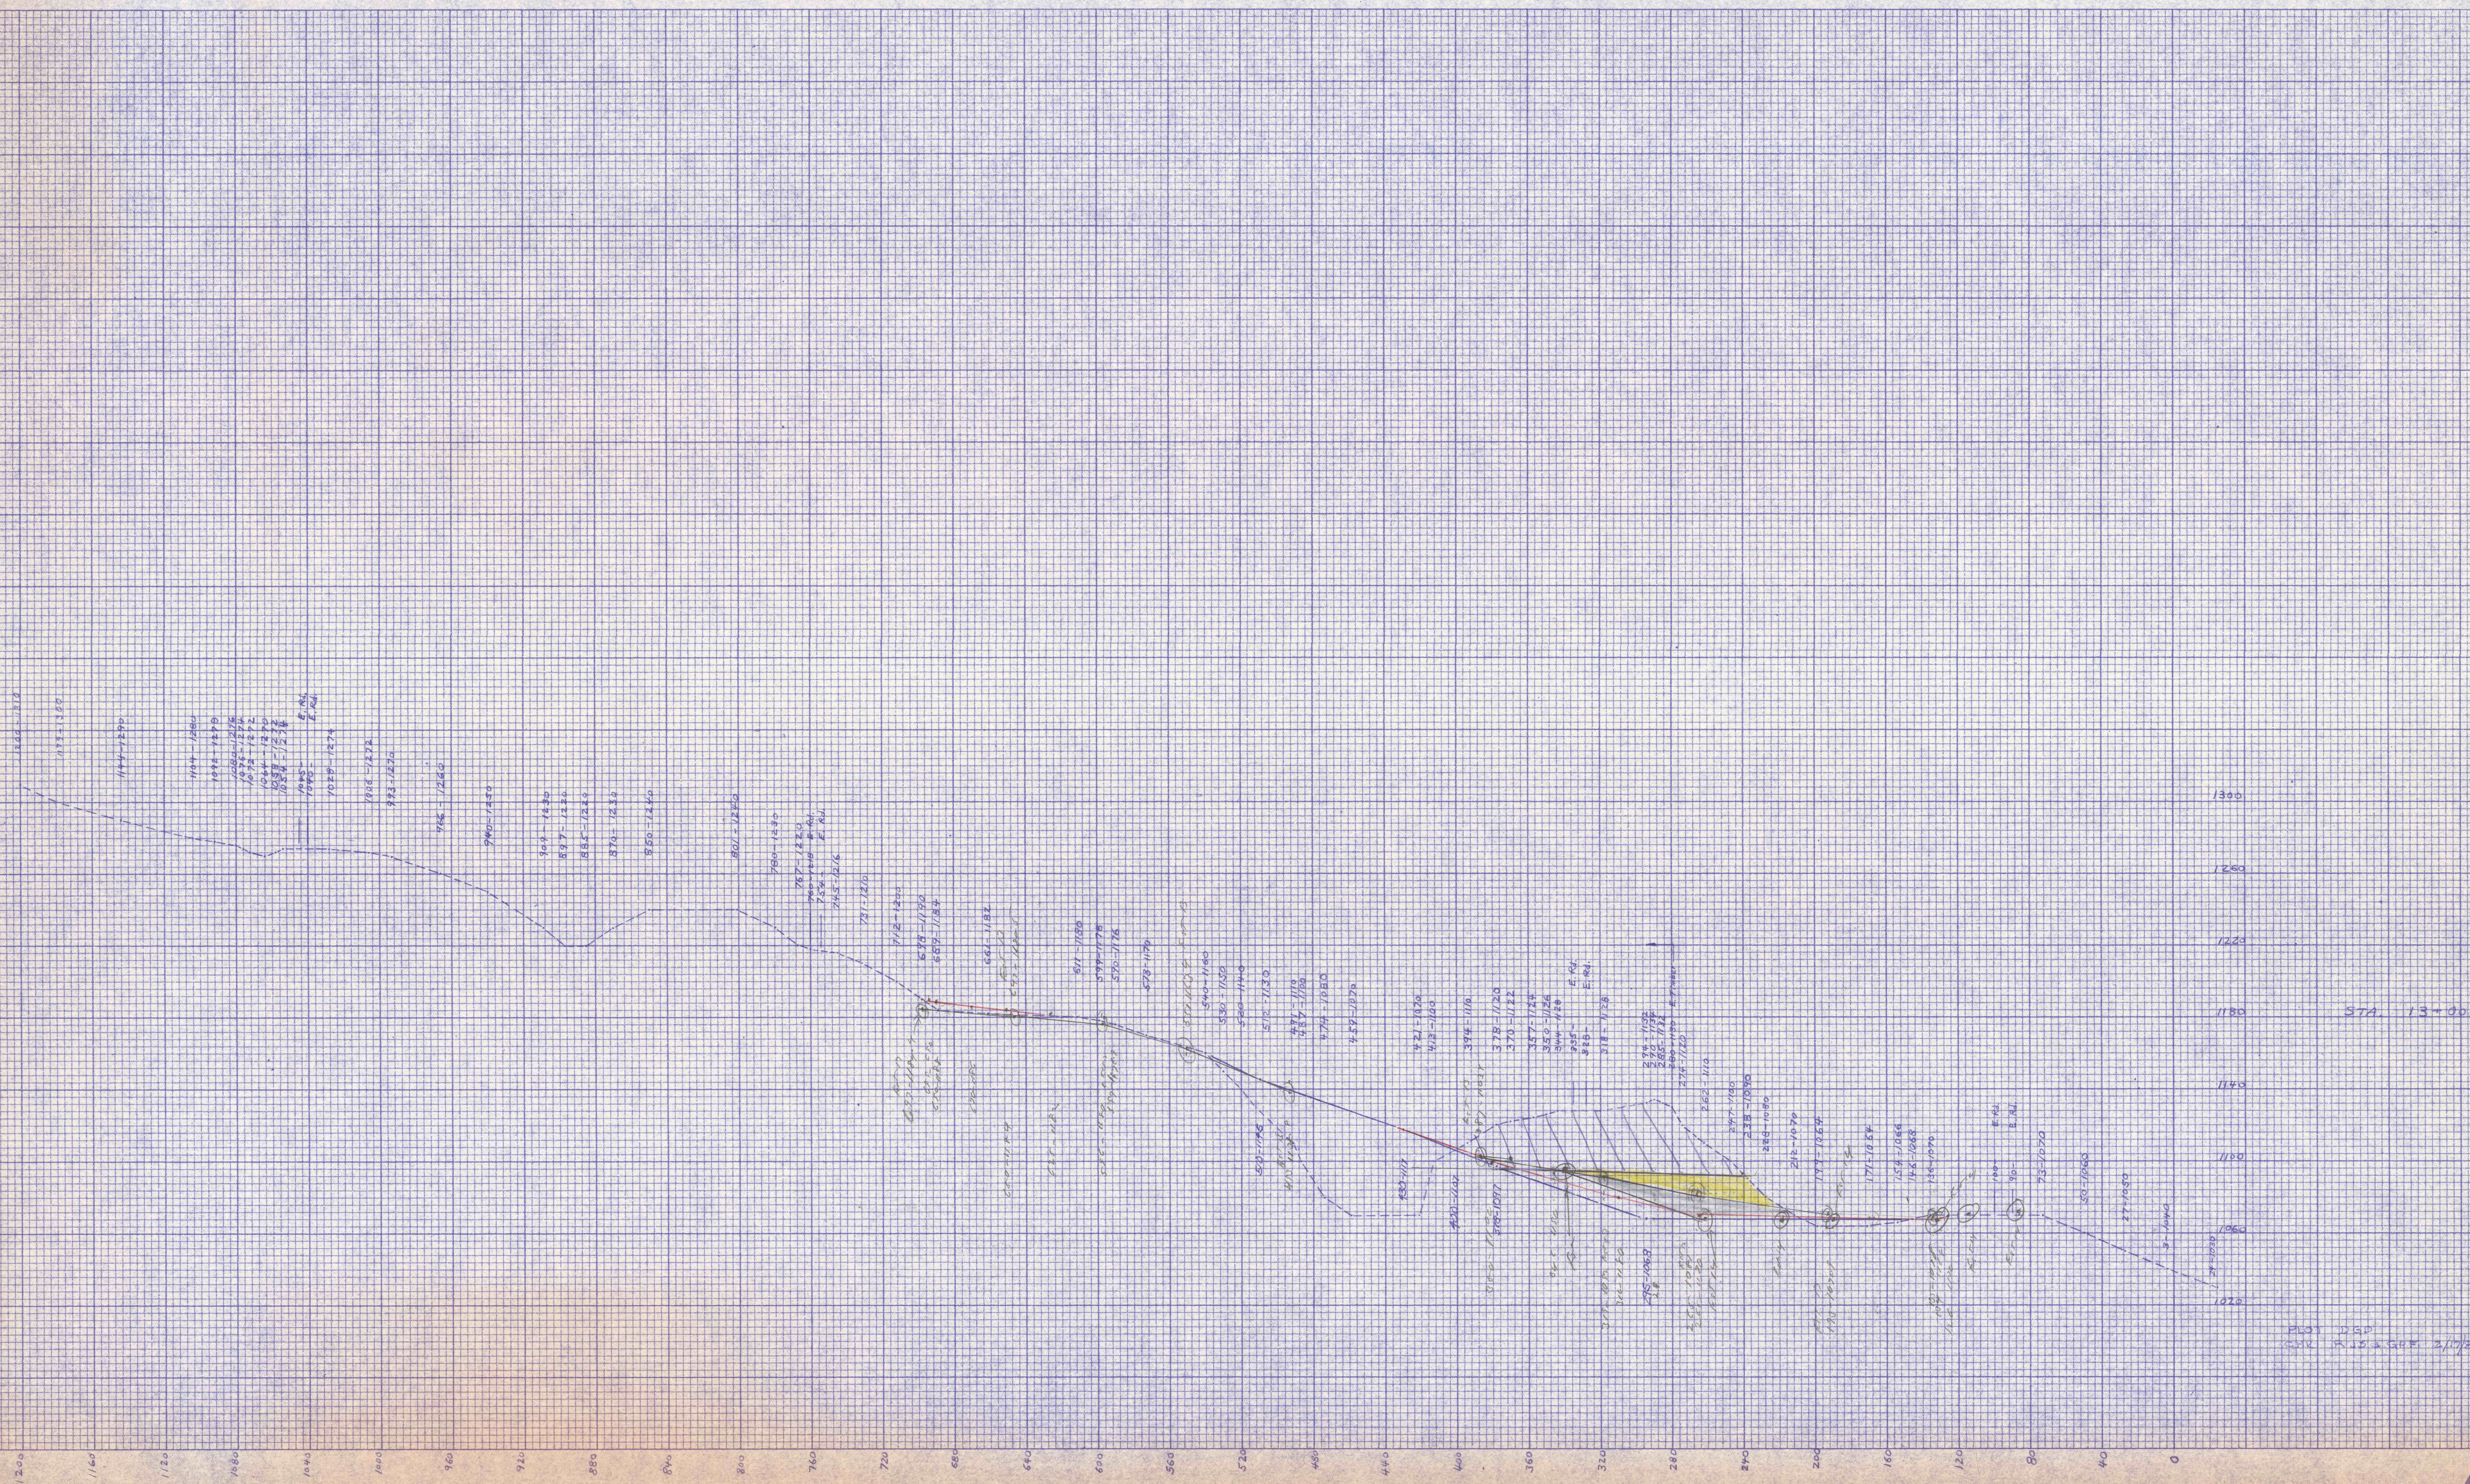

STA. 13+00

PLD 1050
CON. 5/15/50
3/17/51