


EST 14  
10/14/85  
6400

EST 13

EST B  
4640

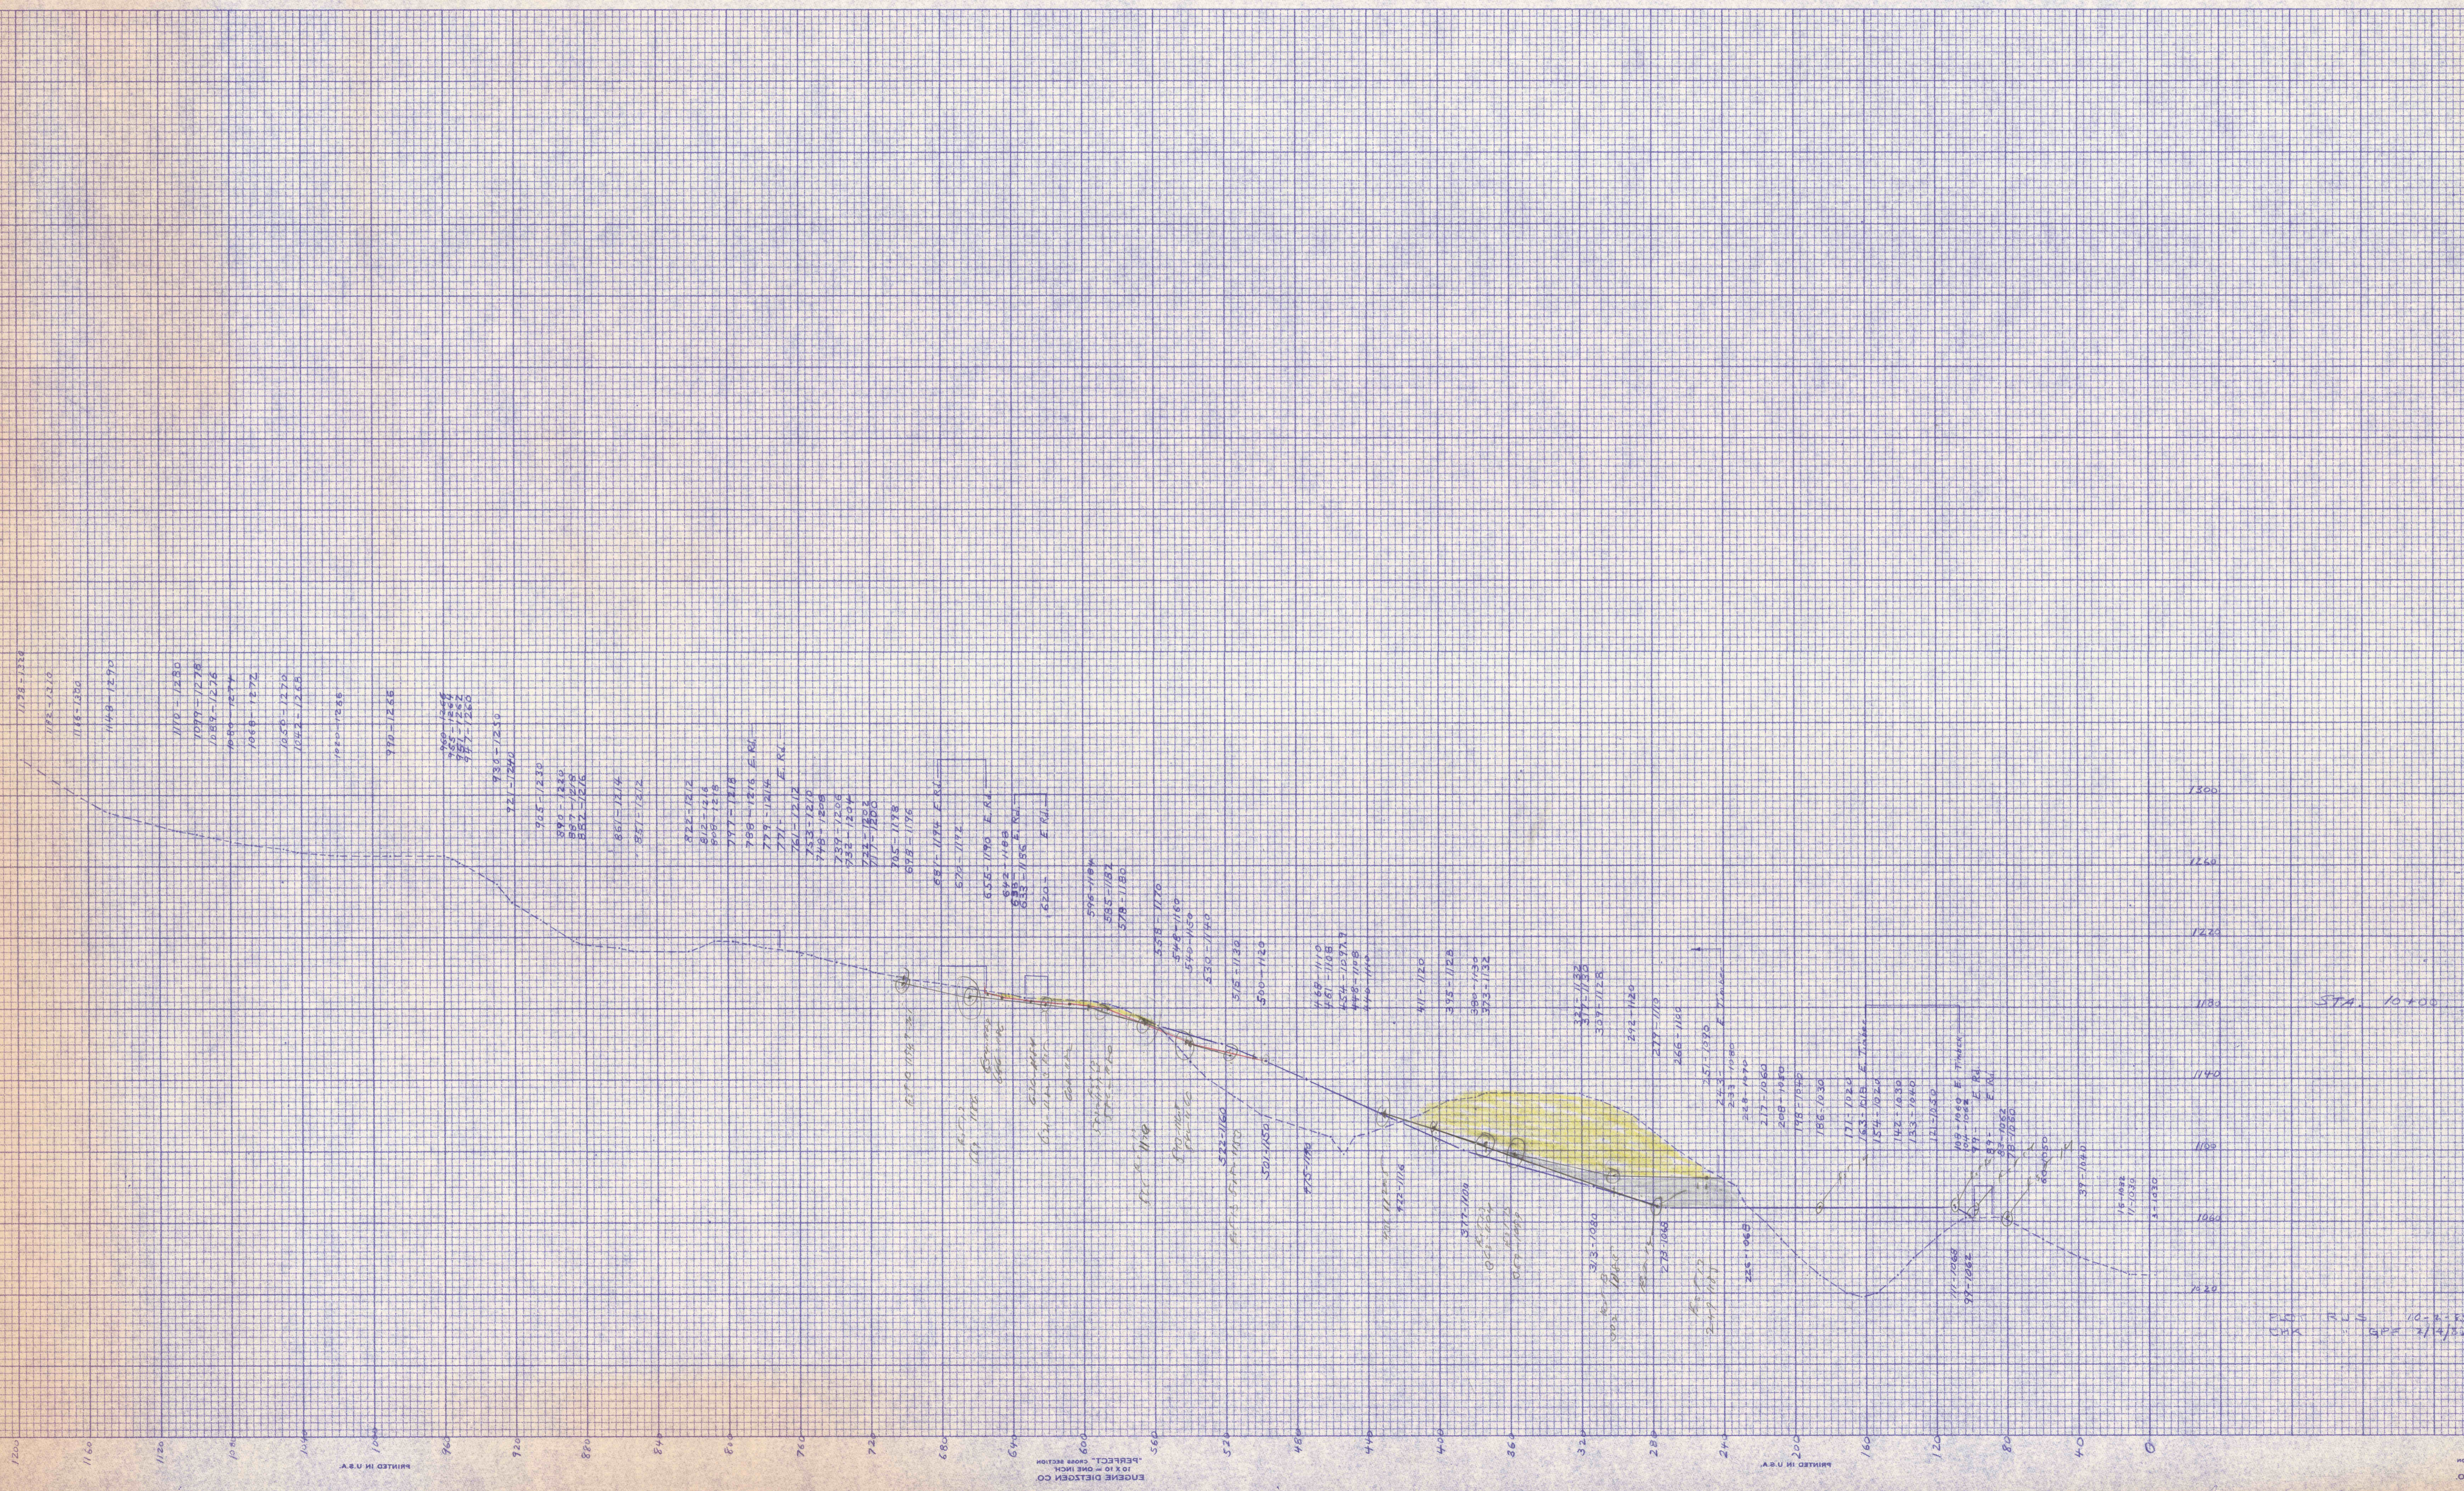

1200  
1160  
1120  
1080  
1040  
1000  
960  
920  
880  
840  
800  
760  
720  
680  
640  
600  
560  
520  
480  
440  
400  
360  
320  
280  
240  
200  
160  
120  
80  
40  
0

1200  
1160  
1120  
1080  
1040  
1000  
960  
920  
880  
840  
800  
760  
720  
680  
640  
600  
560  
520  
480  
440  
400  
360  
320  
280  
240  
200  
160  
120  
80  
40  
0

STA. 10+00

ENGINEER DIETZEN CO.  
10 X 10 - ONE INCH  
PERFECT COPY SECTION  
PRINTED IN U.S.A.  
STA. 10+00  
E. R. 100  
10-2-85  
3/14/85  
CHK  
RUS  
10-2-85  
3/14/85