


OSM 59(3240)10.1  
 Ashton  
 6+00  
 1/1/20

DATE	1/1/20
BY	390
CHECKED	272
SCALE	1"=20'

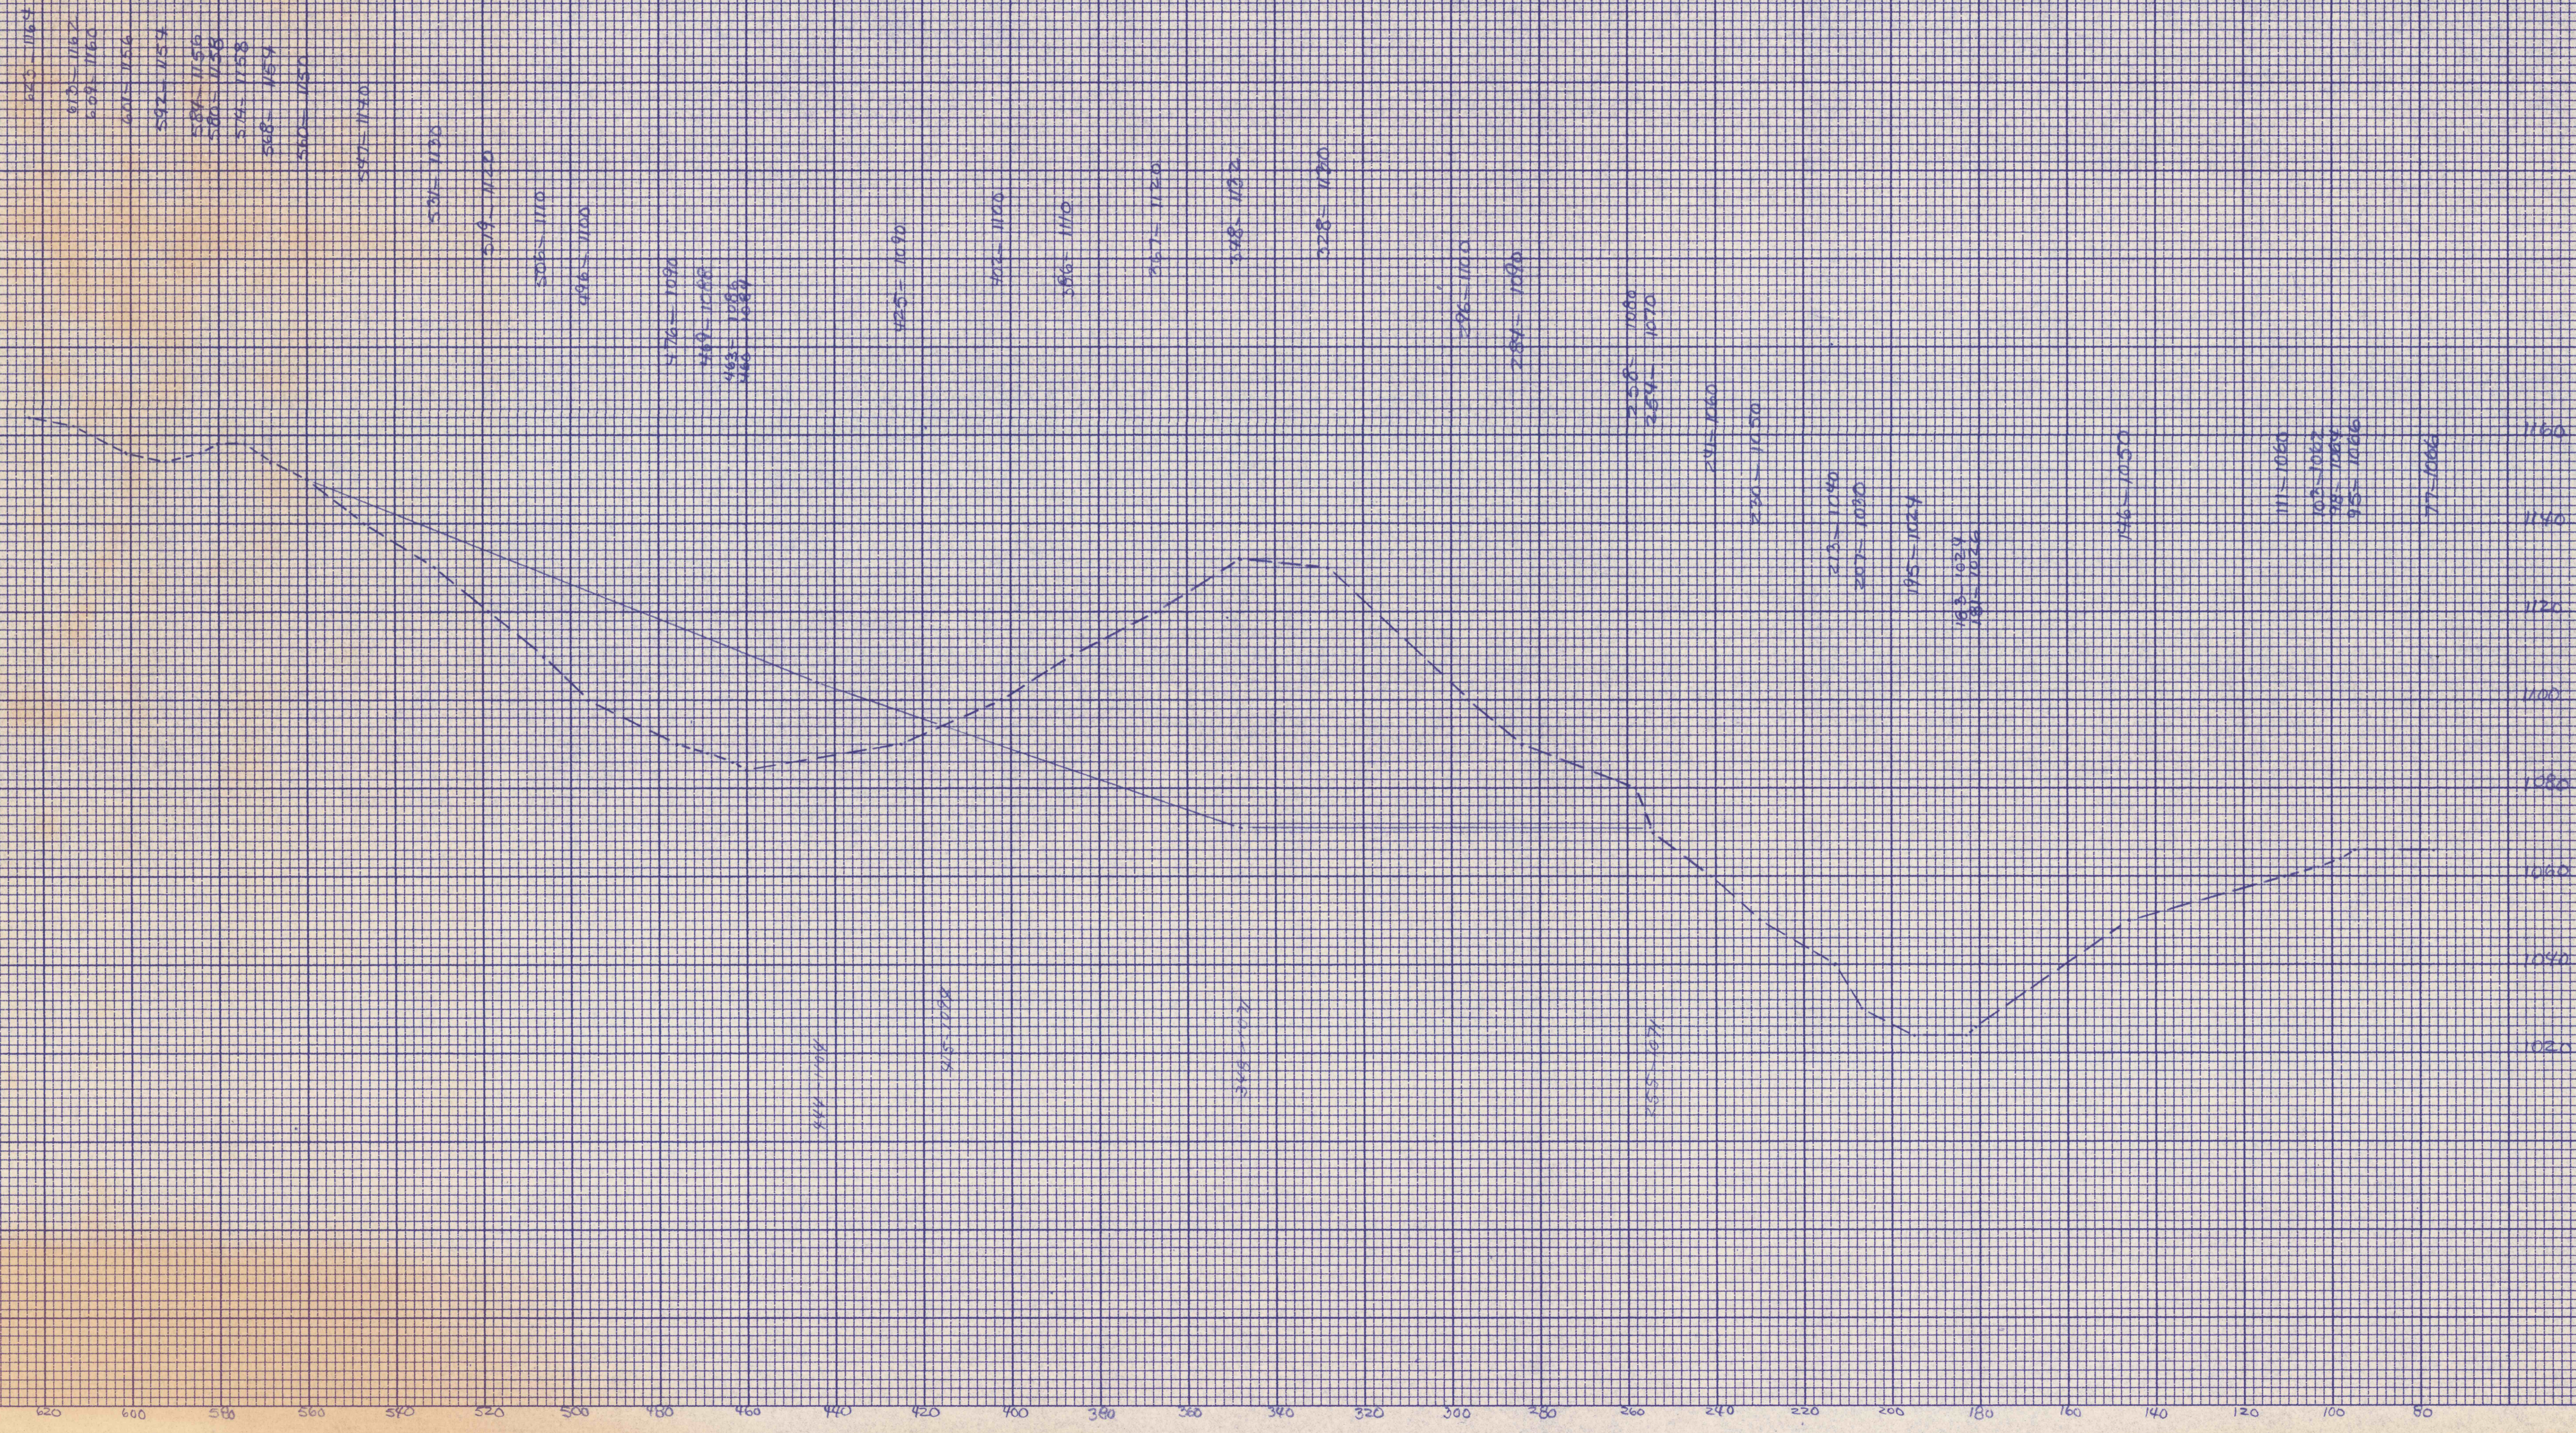

PERFECT CROSS SECTION  
 10 X 10 - ONE INCH  
 DIETZEN

PRINTED IN U.S.A.

DIETZEN  
 10 X 10 - ONE INCH  
 PERFECT CROSS SECTION

PRINTED IN U.S.A.