


TOTAL CUT - 32,396 S.F.
 EST. 13,700 S.F.
 18,696 S.F. REMAINING

[Symbol] = HARD ROCK. COULD NOT BE CUT.

DIETZEN
 10.10 ONE INCH
 10.10 ONE INCH
 PERFECT - CROSS SECTION

DIETZEN
 10.10 ONE INCH
 10.10 ONE INCH
 PERFECT - CROSS SECTION

PRINTED IN U.S.A.

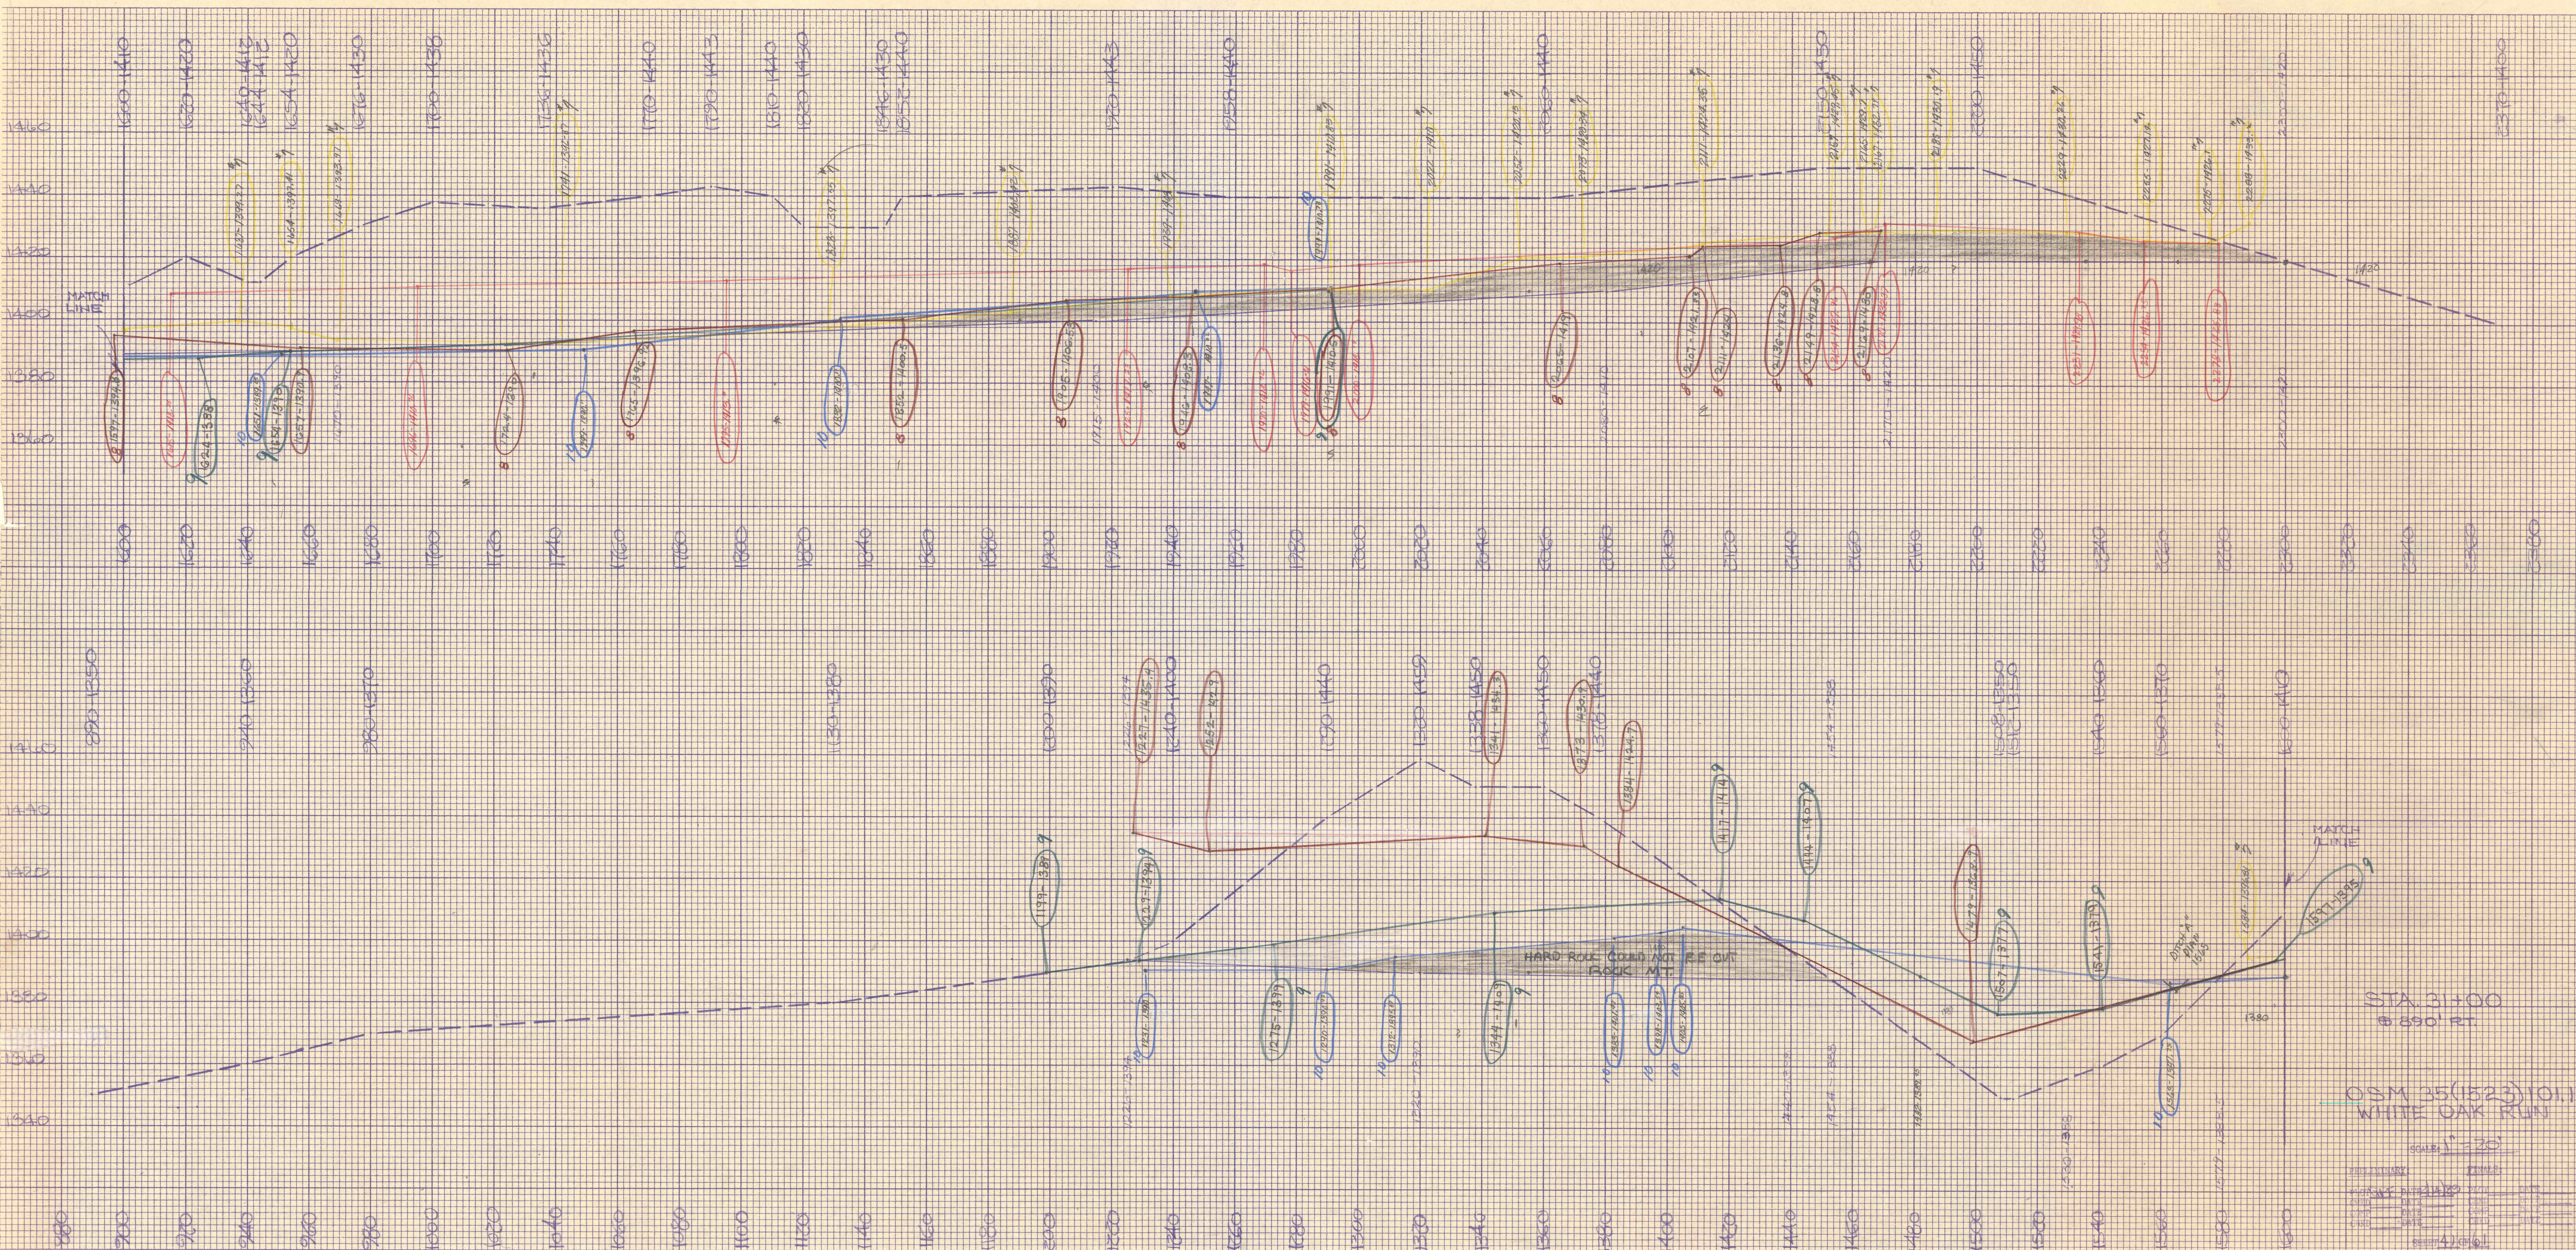

STA. 31+00
 @ 890 FT.

OSM 35(1523)1011
 WHITE OAK RUN

SCALE: 1" = 30'

NO.	DATE	BY	CHKD.	APP.
