

TOTAL CUT = 21,213 S.F.
 EST # 4 3,720 S.F.
 EST # 6 17,493 S.F. REMAINING
 7000 S.F.
 10,493 S.F. REMAINING


Rock COULD NOT BE CUT

DIETZEN
 10' x 10' ONE INCH
 PERFECT CROSS SECTION

PRINTED IN U.S.A.

DIETZEN
 10' x 10' ONE INCH
 PERFECT CROSS SECTION

PRINTED IN U.S.A.

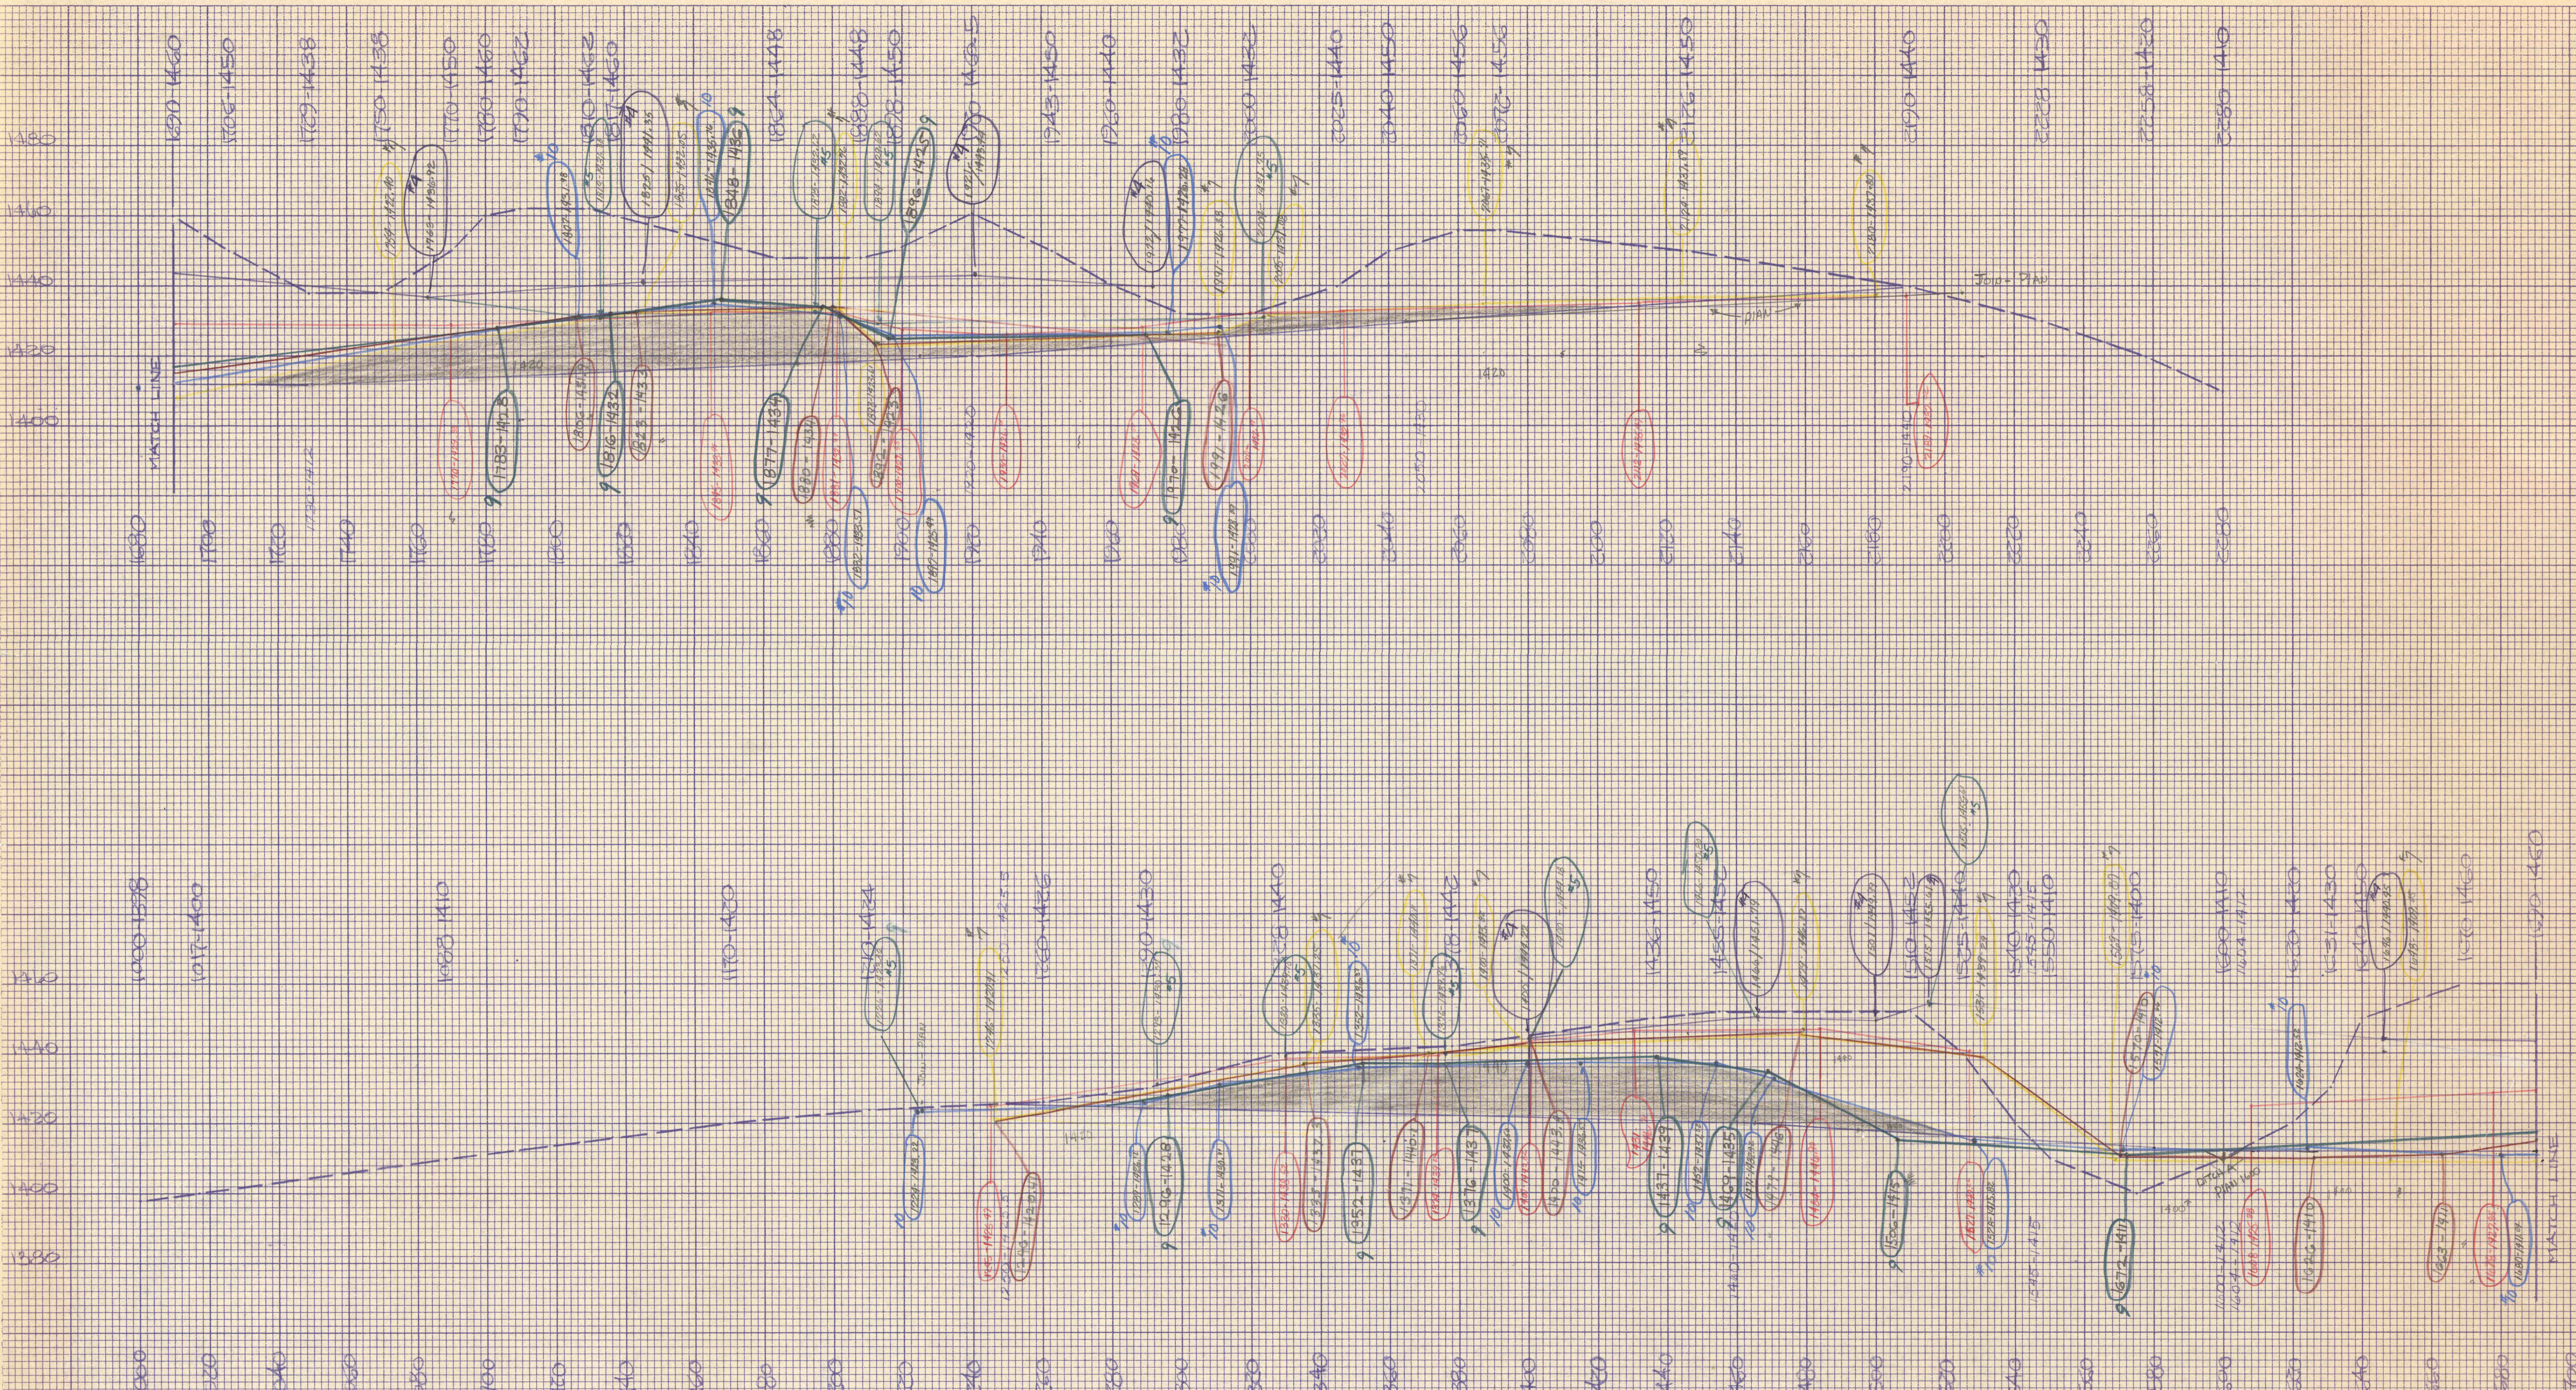

STA 33+00
 @ 100' RT.

OSM 25(1523)10.1
 WHITE OAK RUN

SCALE: 1" = 20'

REVISION	DATE	BY	CHKD
1	12/15/82
2
3
4
5