


TOTAL CUT = 19,460 S.F.
 EST #4 10,520
 EST 5 8,940 SF REMAINS
 EST 6 2,688
 6252 REMAINING
 592
 5660 REMAINING

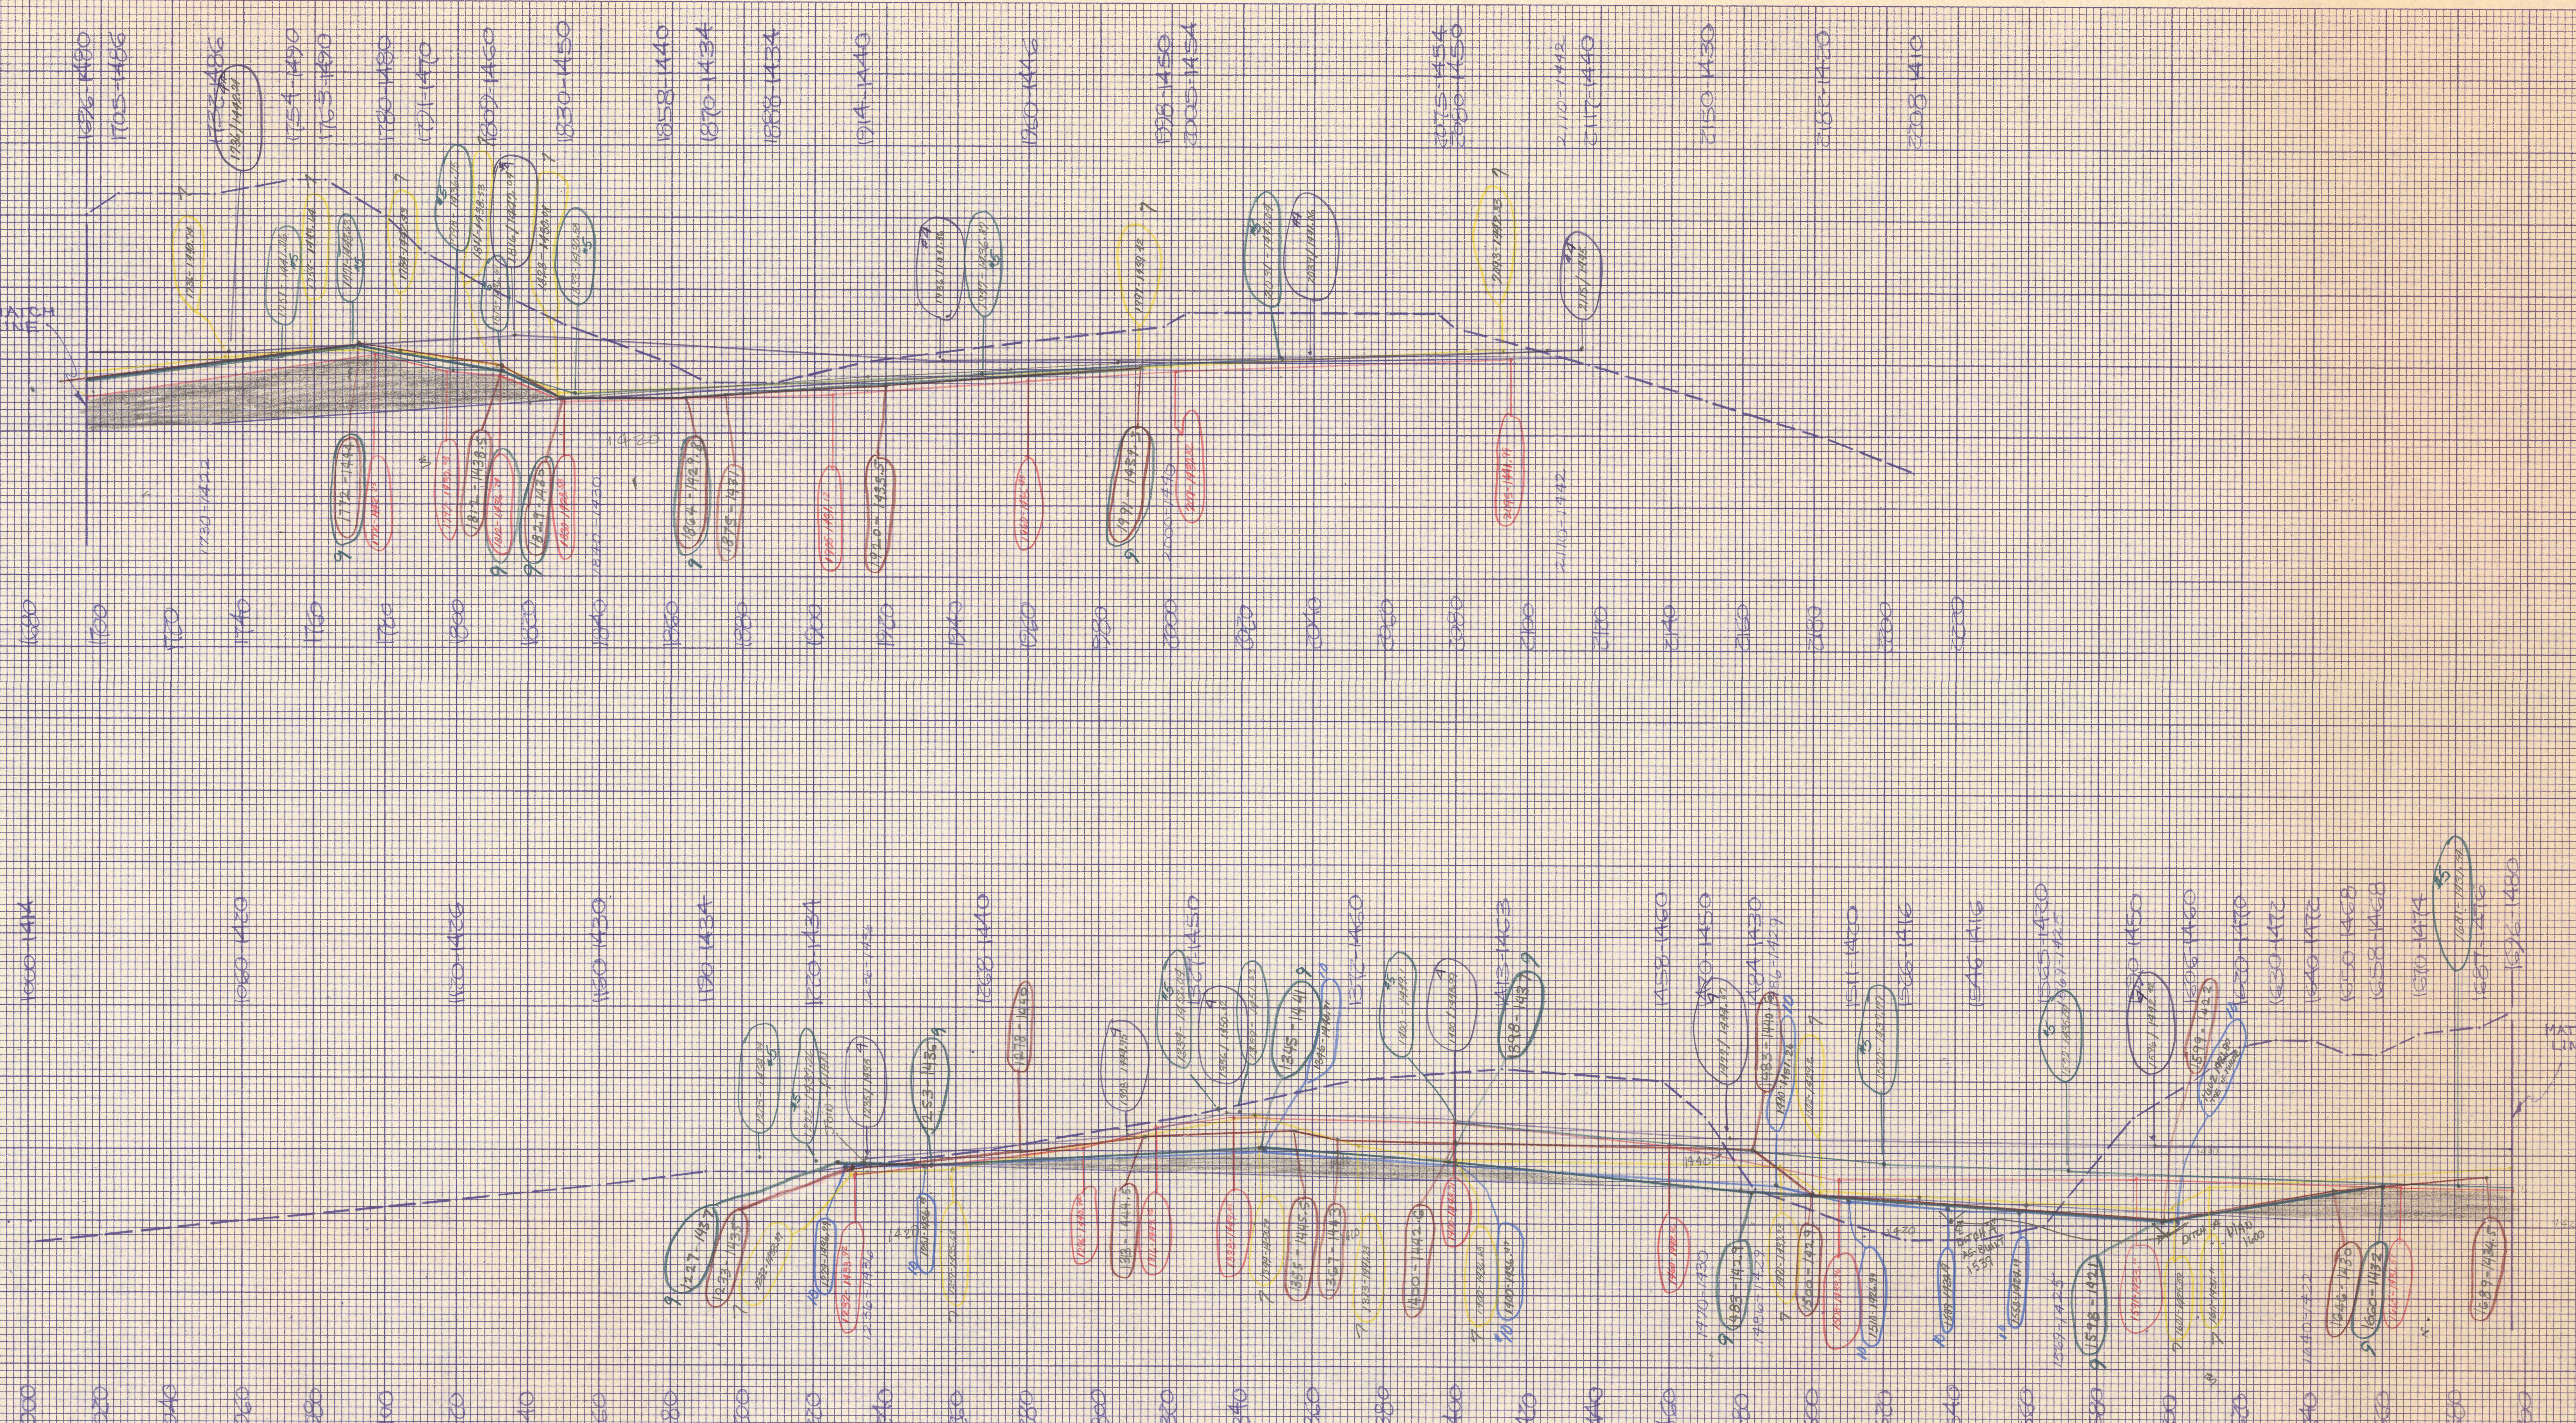

STA 34100
 @ 1000' RT
 OSM 35 (1523) 10.1
 WHITE OAK RUN
 SCALE: 1" = 20'

NO.	DATE	BY	CHKD.
1	10/21/10
2
3
4
5

DIETZEN
 10 X 10 - ONE INCH
 - PERFECT - CROSS SECTION

PRINTED IN U.S.A.

DIETZEN
 10 X 10 - ONE INCH
 - PERFECT - CROSS SECTION

PRINTED IN U.S.A.