


TOTAL CUT 14,056 SF.
 EST #4 10,560
 3,496 SF REMAINING
 EST 5 1,652
 1,814 REMAINING
 122.8
 EST #6 616 REMAINING

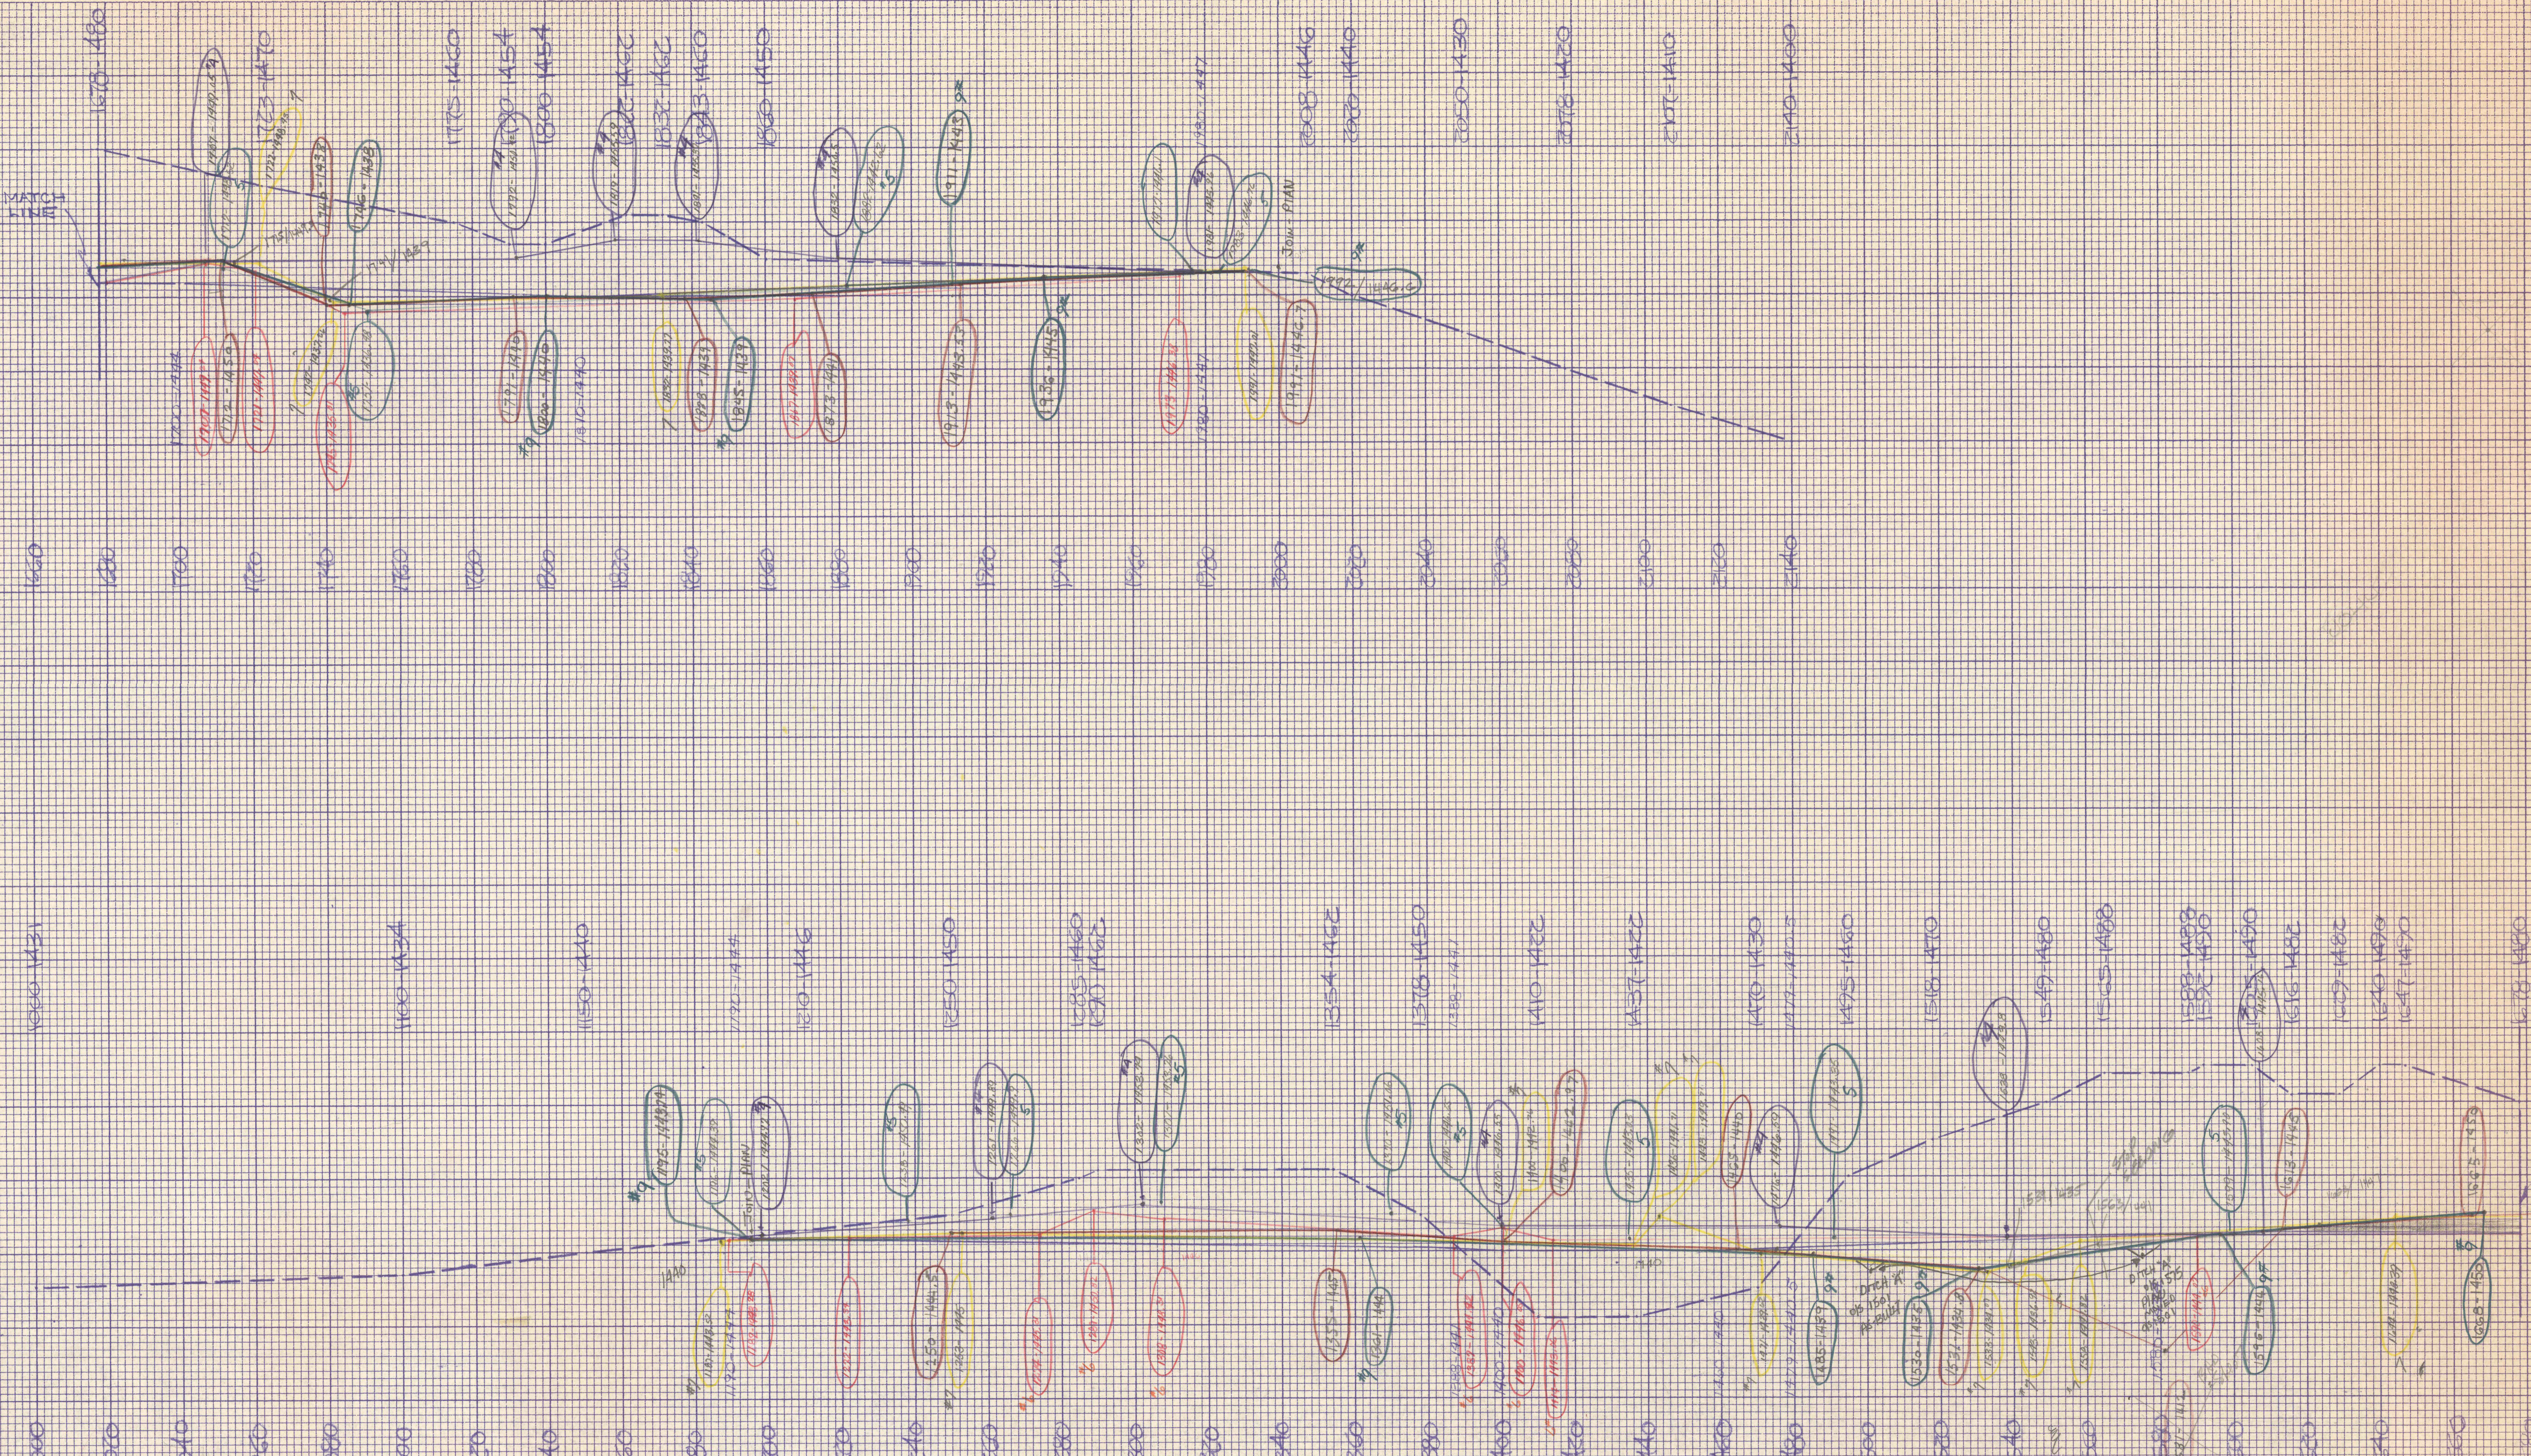

STA 35+00
 @ 1000' RT
 OSM 35(1523) 10.1
 WHITE OAK RUN
 SCALE 1" = 20'
 PREPARED BY: DATE: 12/15/59
 CHECKED BY: DATE: 12/15/59
 DESIGNED BY: DATE: 12/15/59
 DRAWN BY: DATE: 12/15/59
 IN CHARGE: DATE: 12/15/59

DIETZEN
 10 1/2 ONE INCH
 PERFECT COPY SECTION

PRINTED IN U.S.A.

DIETZEN
 10 1/2 ONE INCH
 PERFECT COPY SECTION

PRINTED IN U.S.A.

DIETZEN
 10 1/2 ONE INCH
 PERFECT COPY SECTION