


TOTAL CUT - 6640
EST # 3 4560

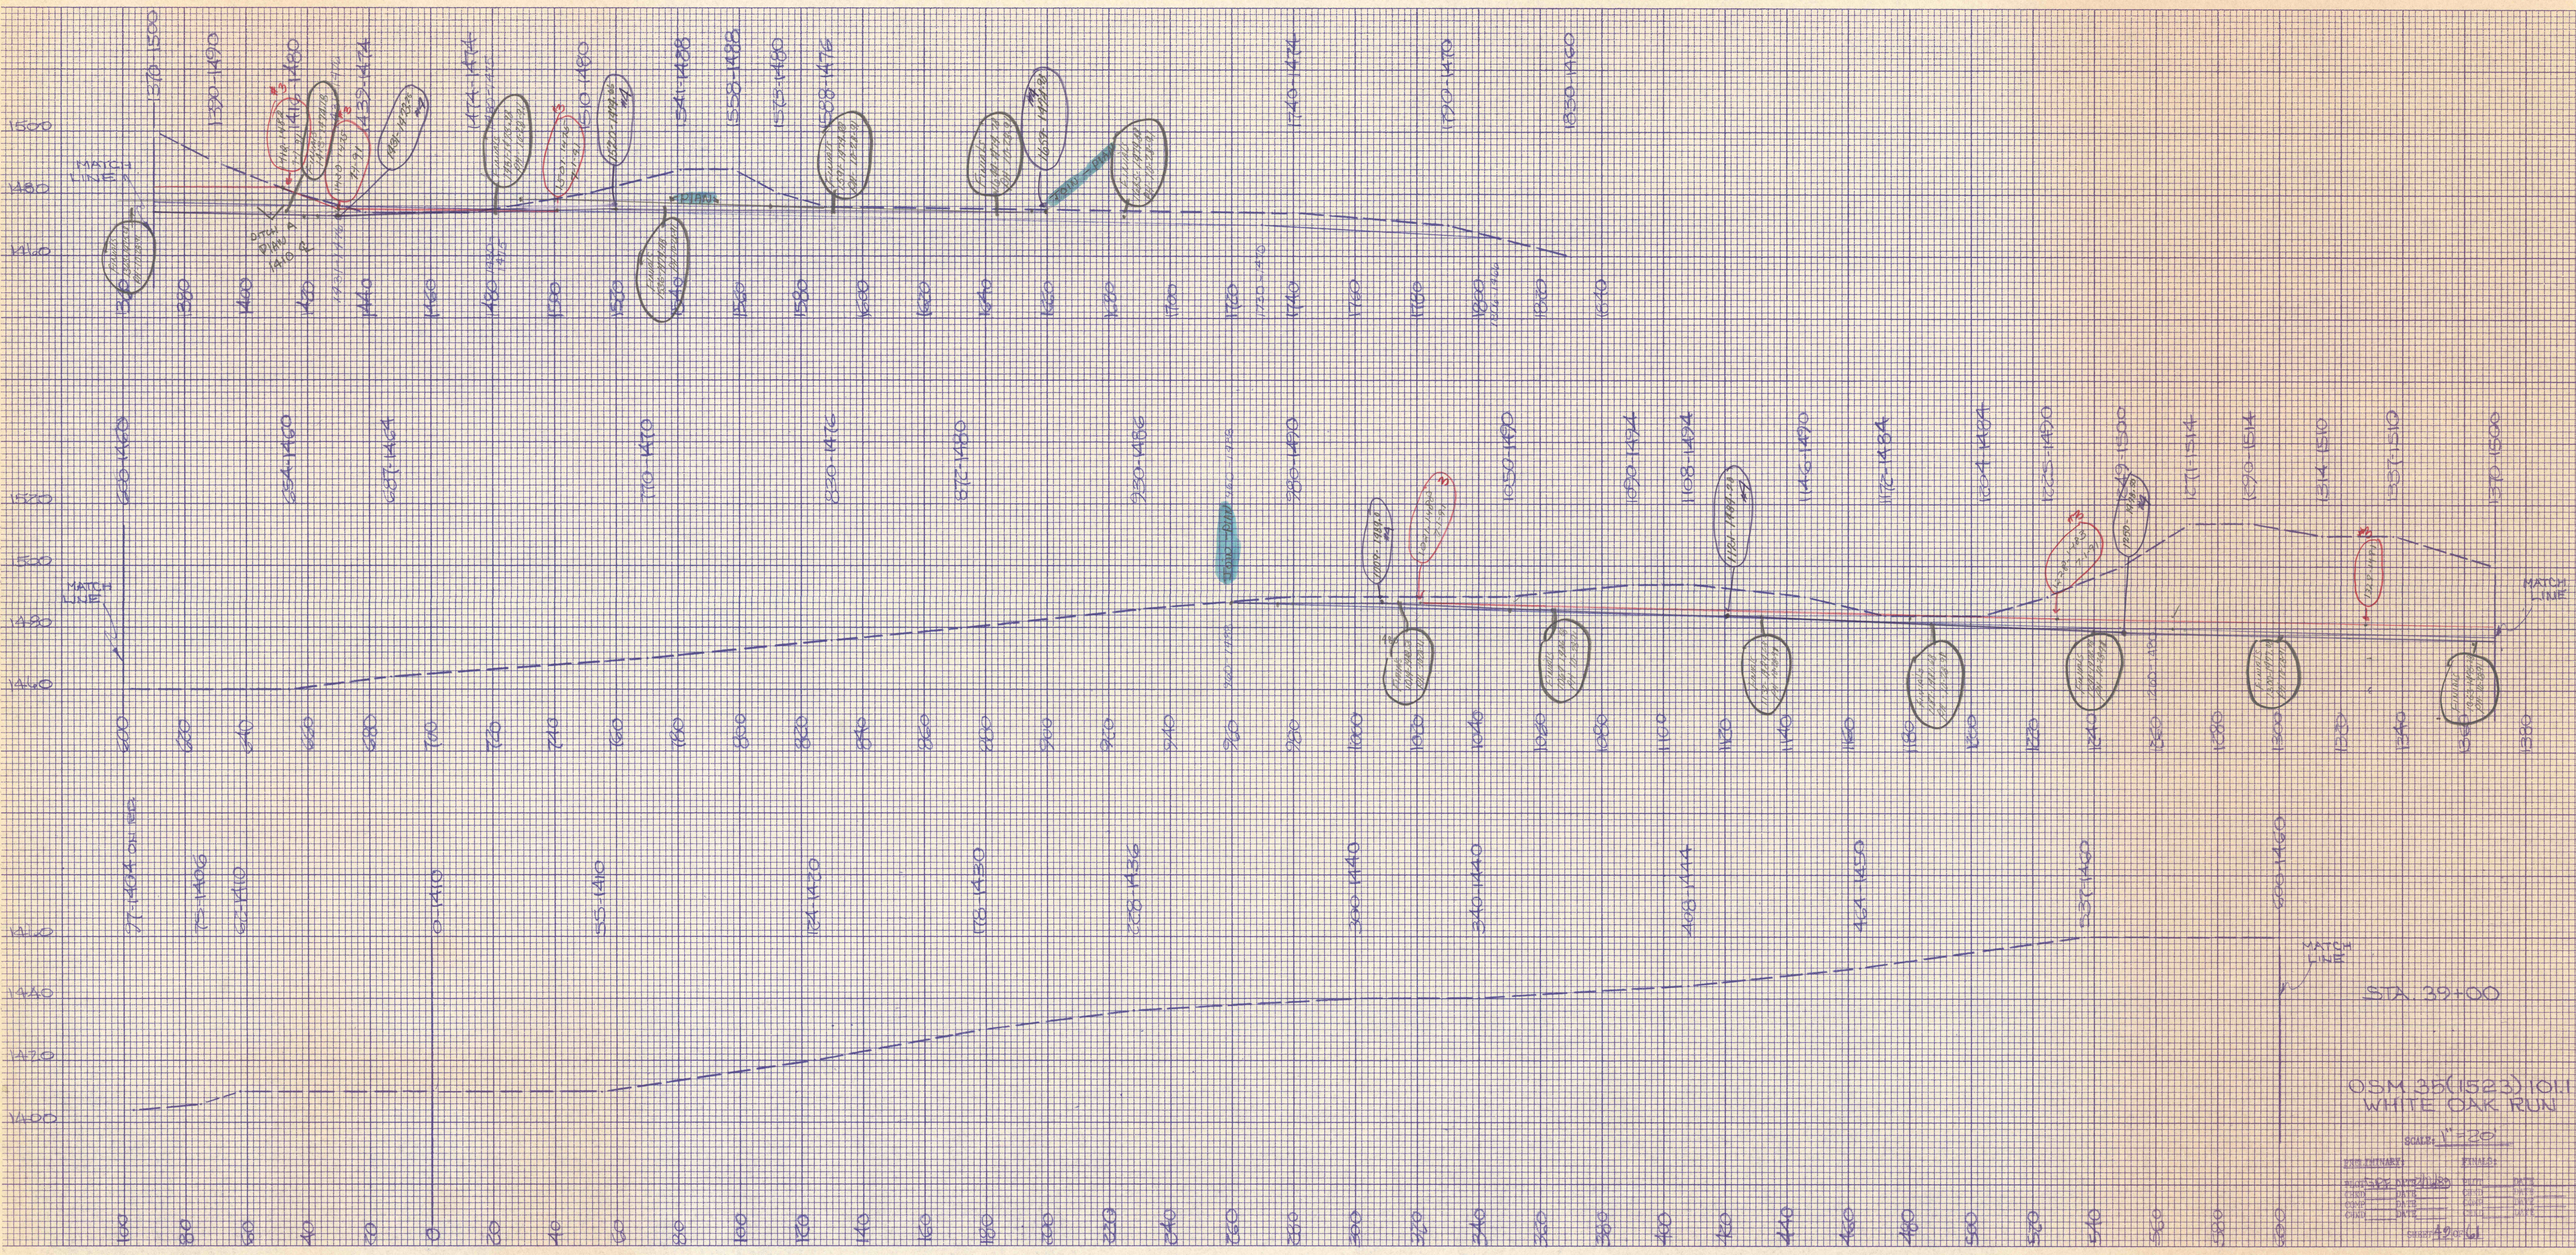

OSM 35(1523) 1011
WHITE OAK RUN
SCALE: 1"=20'

DATE	BY	CHKD	DATE
10/1/00
...
...
...

STA. 39+00

MATCH LINE

MATCH LINE

MATCH LINE

MATCH LINE

PROVISIONAL

FINAL

DATE DATE DATE DATE

BY BY BY BY

Sheet 49 of 61

PRINTED IN U.S.A.

DIETZEN
10 x 10 CROSS SECTION
PERFECT CROSS SECTION

PRINTED IN U.S.A.

DIETZEN
10 x 10 CROSS SECTION
PERFECT CROSS SECTION