


TOTAL CUT 2400 S.F.
EST #2 2160
240 S.F. remaining

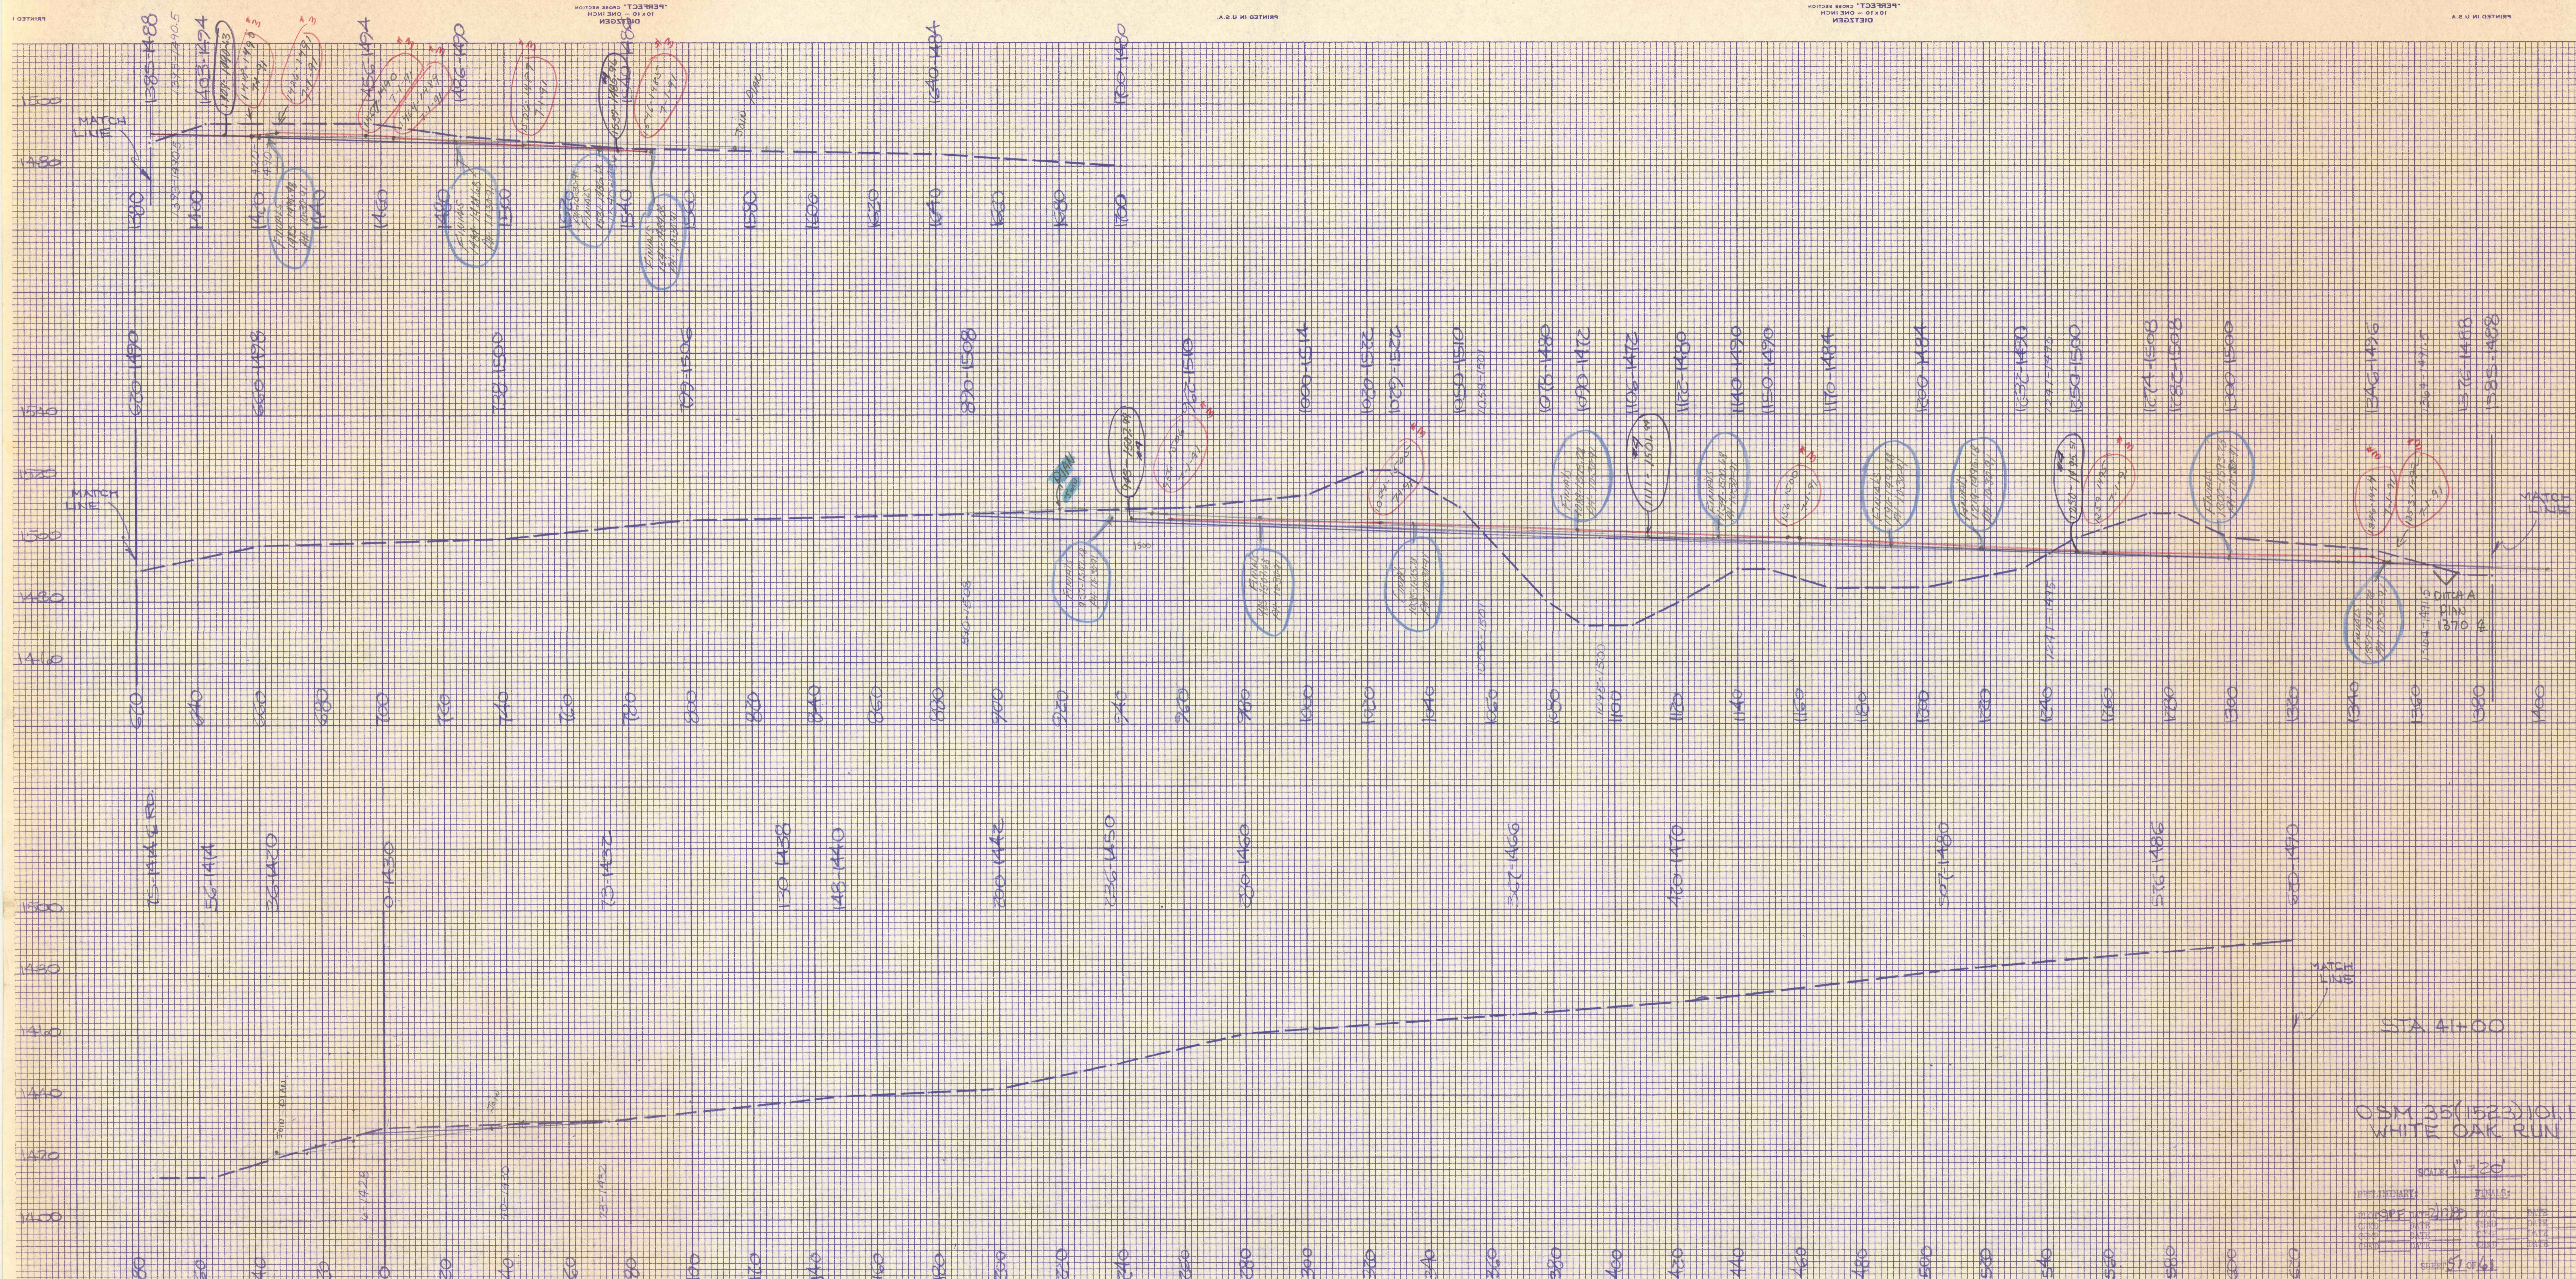

OSM 35(1523) 10.1
WHITE OAK RUN
Scale 1" = 20'

DATE	BY	REVISION

Sheet 51 of 61

PRINTED IN U.S.A.
DIELTZGEN
10 x 10 - ONE INCH

PRINTED IN U.S.A.
DIELTZGEN
10 x 10 - ONE INCH
