


CONTR. UNDER CUT @ THIS STA.
 CROSS SECTION FINAL GRADE LINE PLOTTED WORKS

TOTAL CUT = 5000 S.F.
 EST #3 2400
 #4

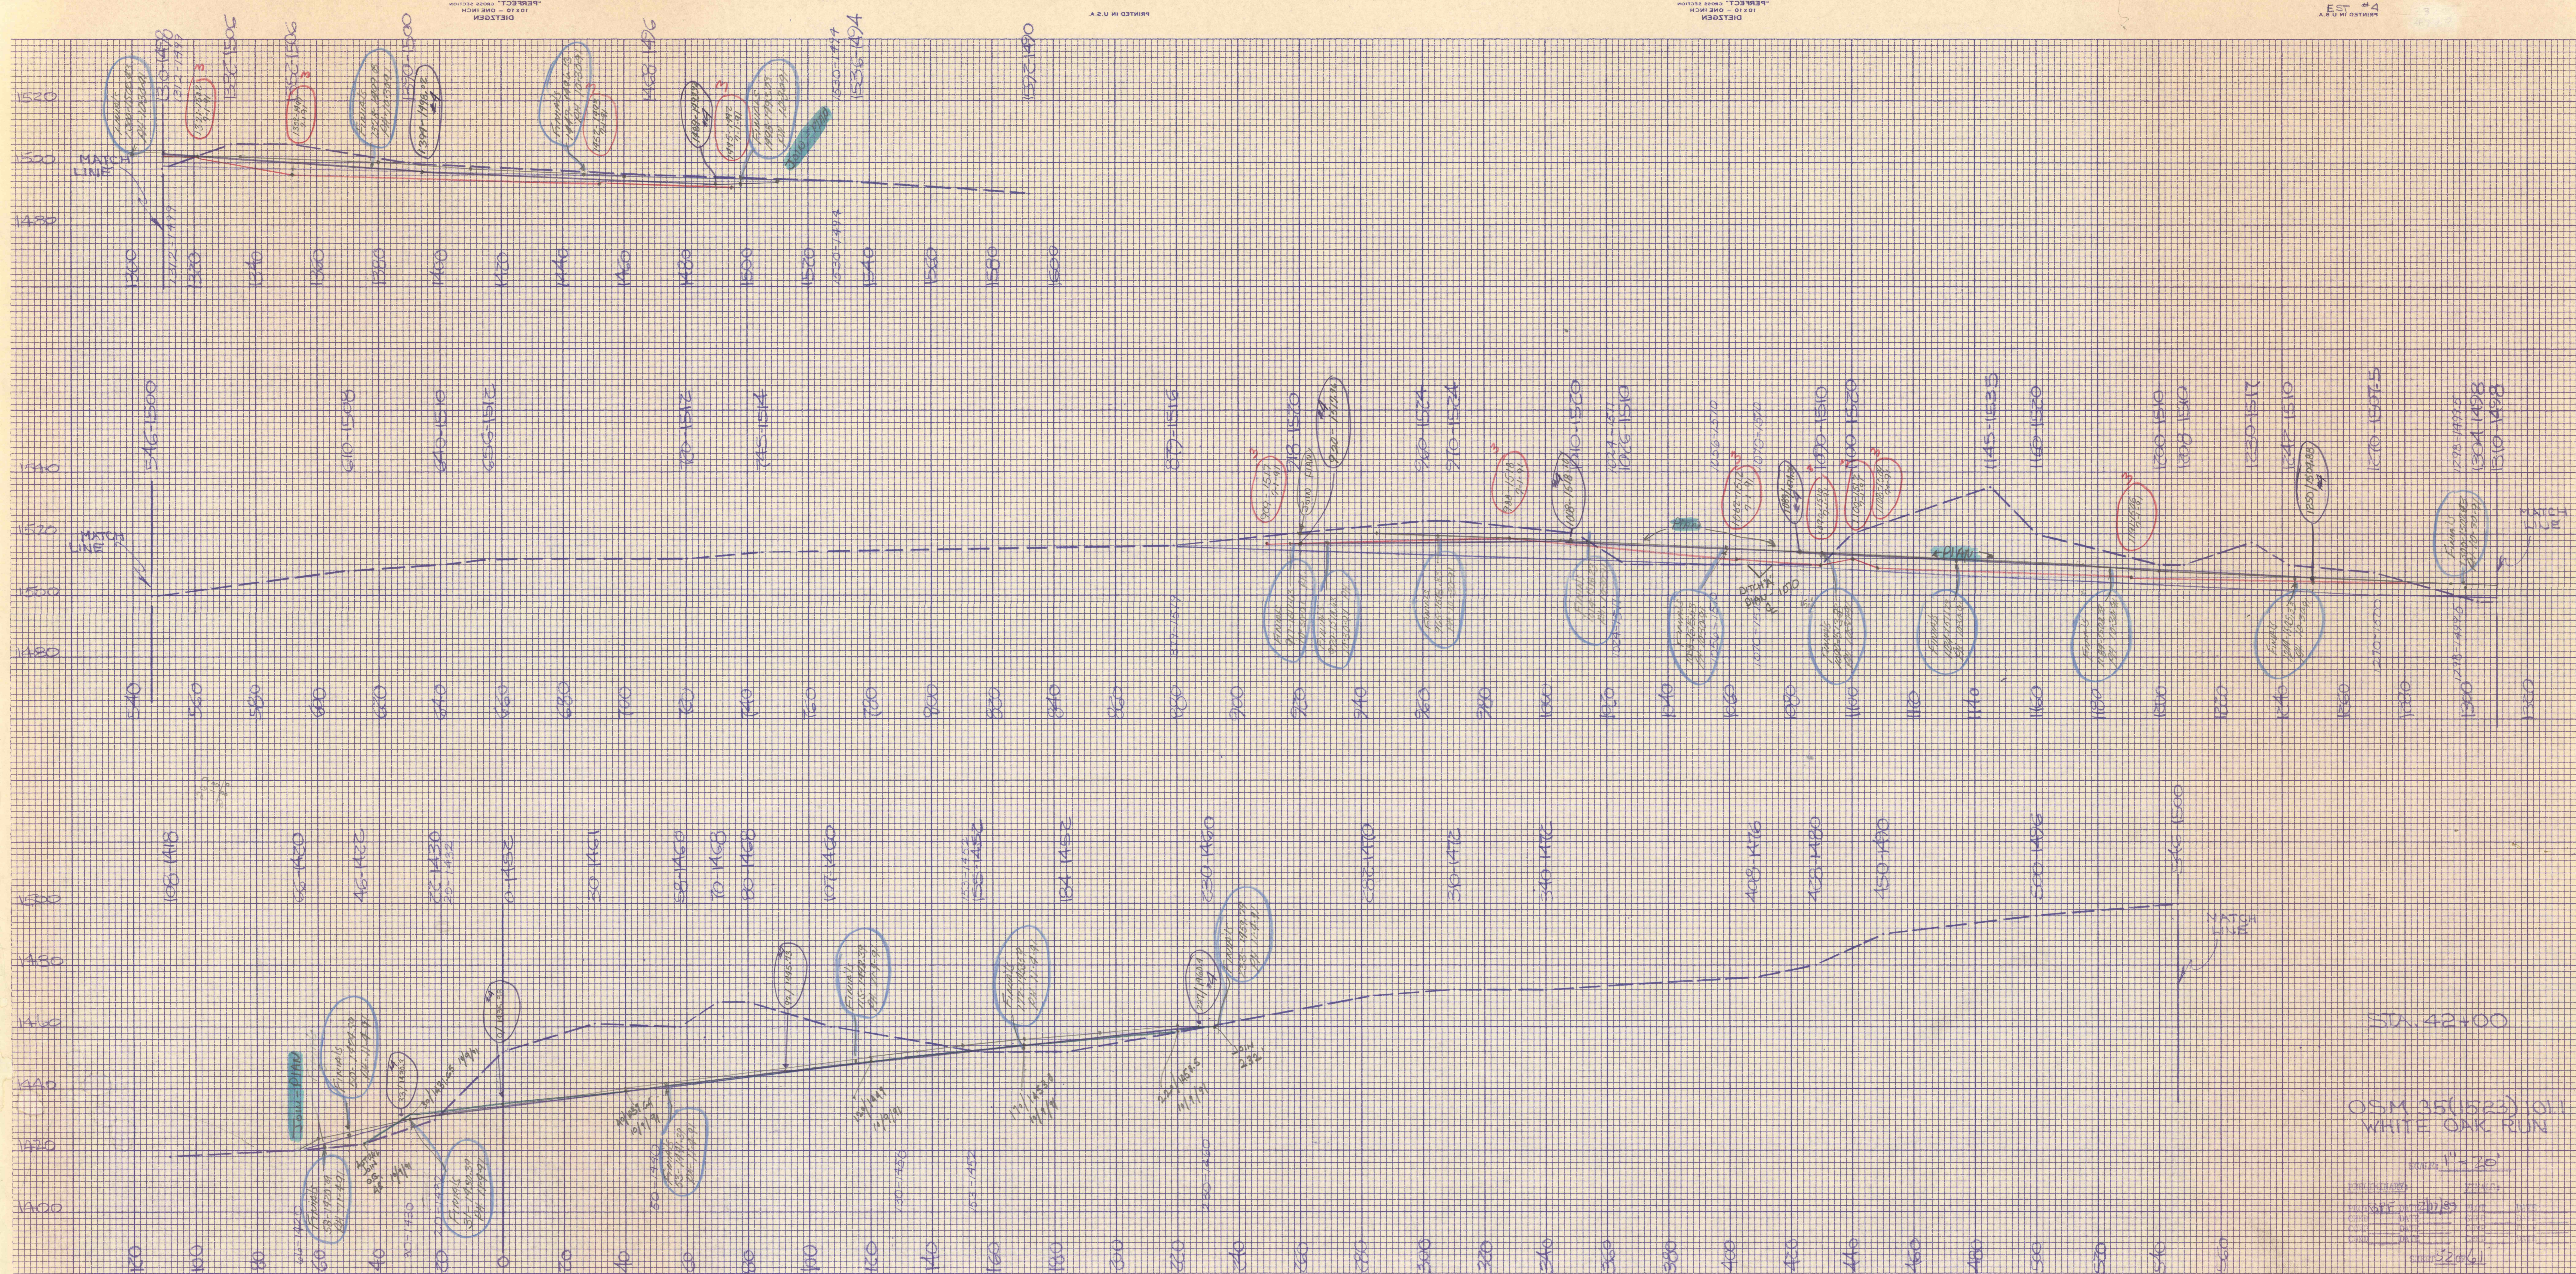

STA. 42+00
 OSM 35(1523) 101.1
 WHITE OAK RUN
 SCALE: 1" = 20'
 SHEET 22 OF 61