


TOTAL CUT = 800 S.F.
EST # 3 600

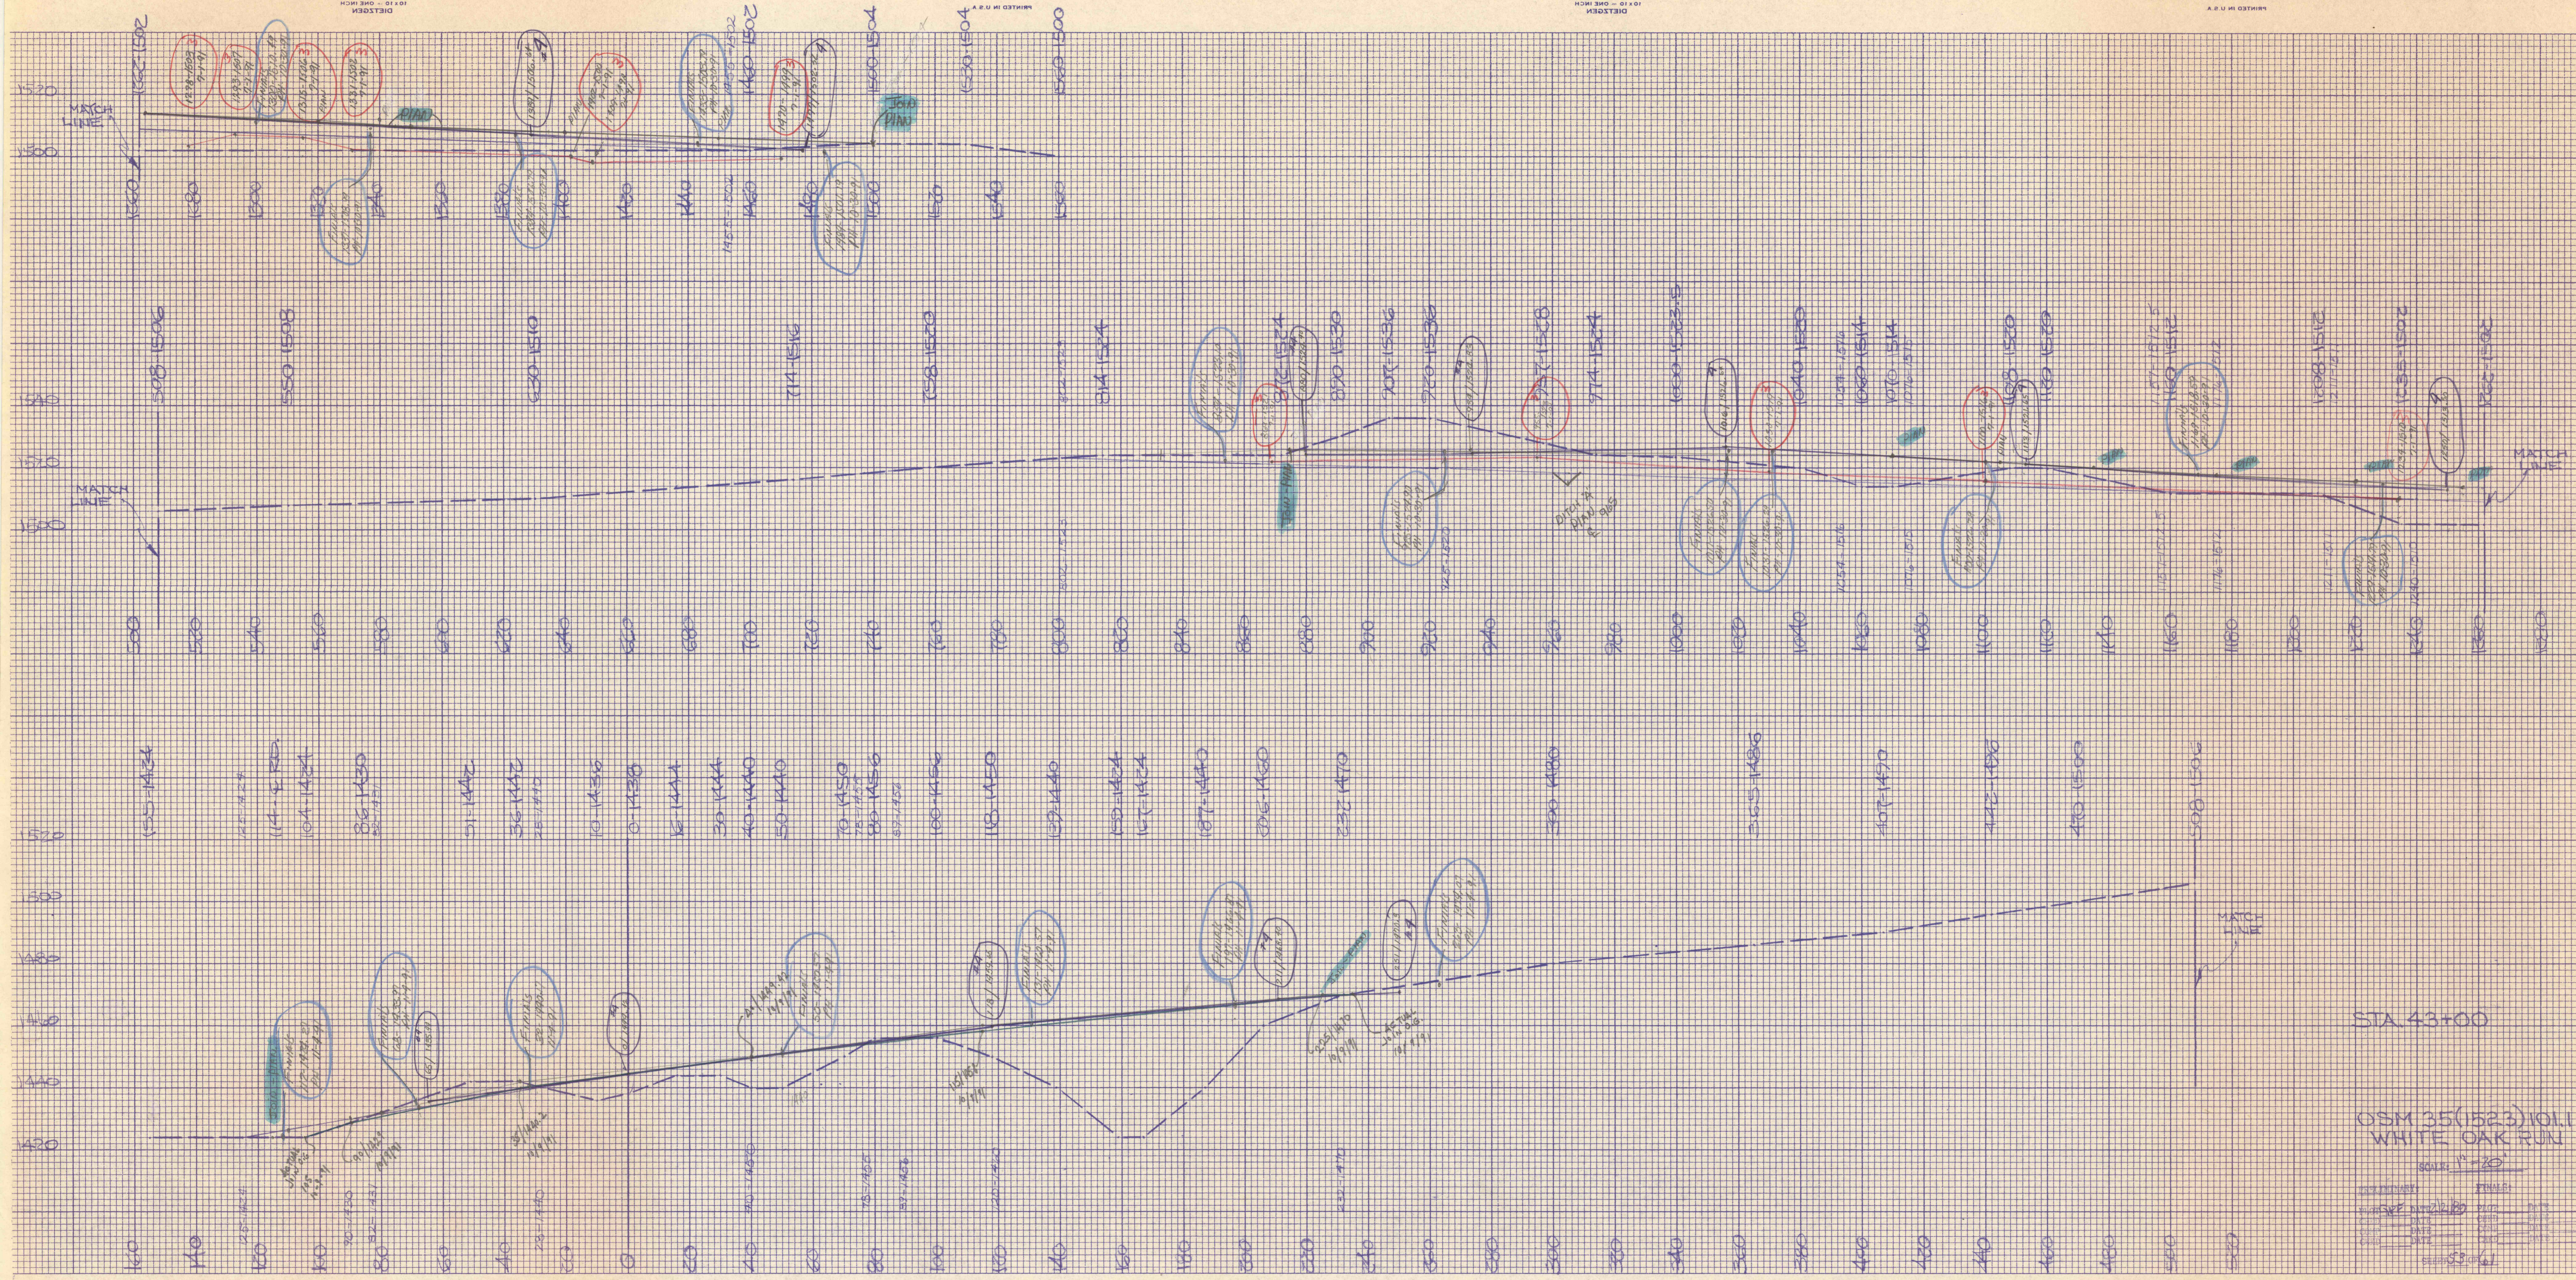

STA. 43+00

OSM 35(1523)10.1
WHITE OAK RUN

SCALE: 1" = 20'



DELTGEN
10 12 - ONE INCH
PERFECT COPY SECTION



CONTR.