
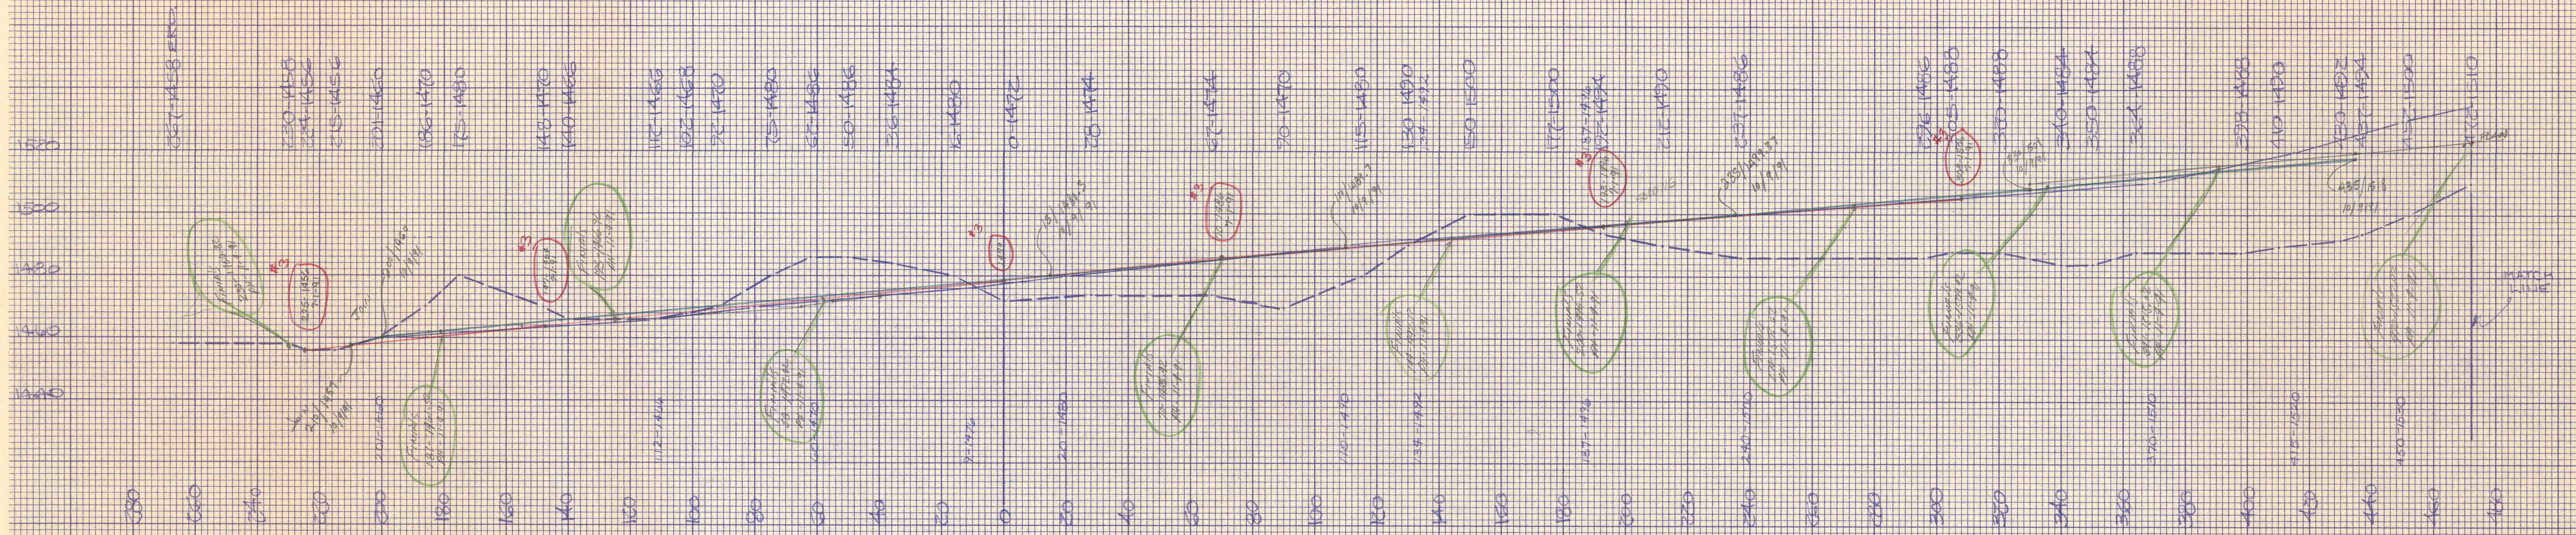


TOTAL CUT 1760 SF  
EST #3 1720

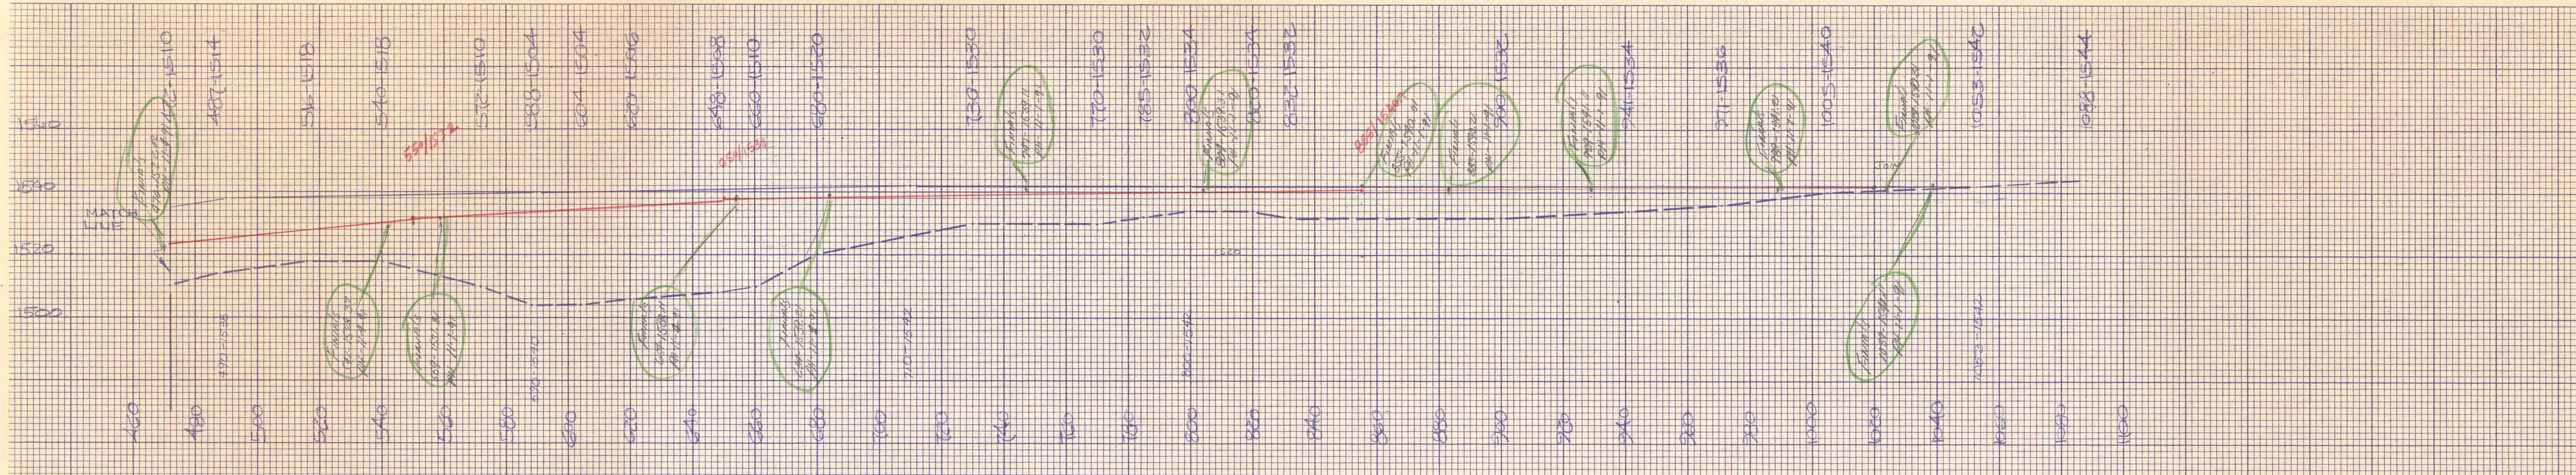

STA 48+00

OSM 35(1523) 101.1  
WHITE OAK RUN  
SCALE: 1"=20'

DATE	2/1/83	DATE	
BY		BY	
CHECKED		CHECKED	
DATE		DATE	
BY		BY	

PRINTED IN U.S.A. DEITGEN 10 1/2" CROSS SECTION 10 1/2" CROSS SECTION PERFECT CROSS SECTION DEITGEN 10 1/2" CROSS SECTION