℄ 1

℄ 1 WEST LAND LINE

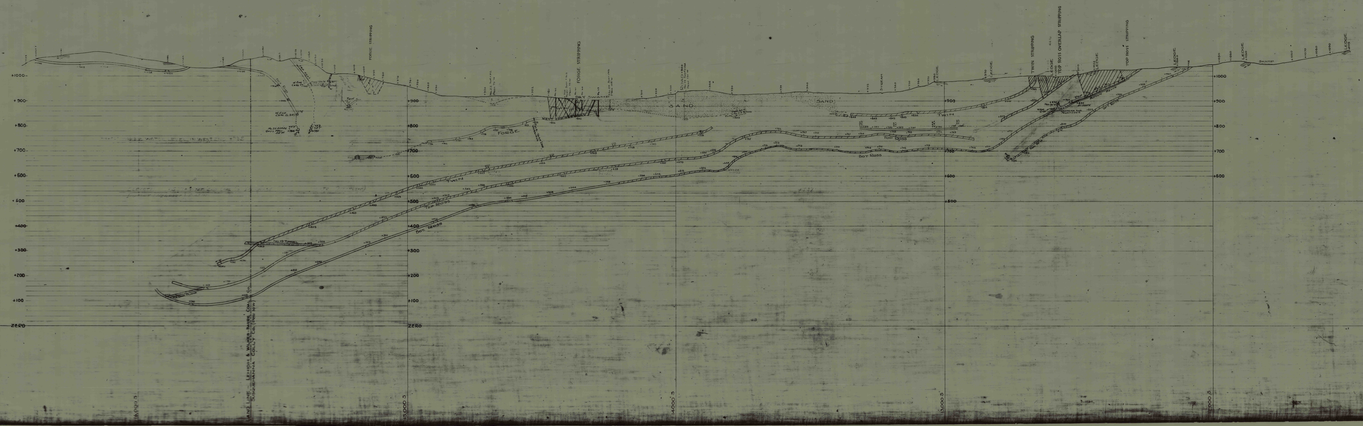

℄ 1 WEST LAND LINE