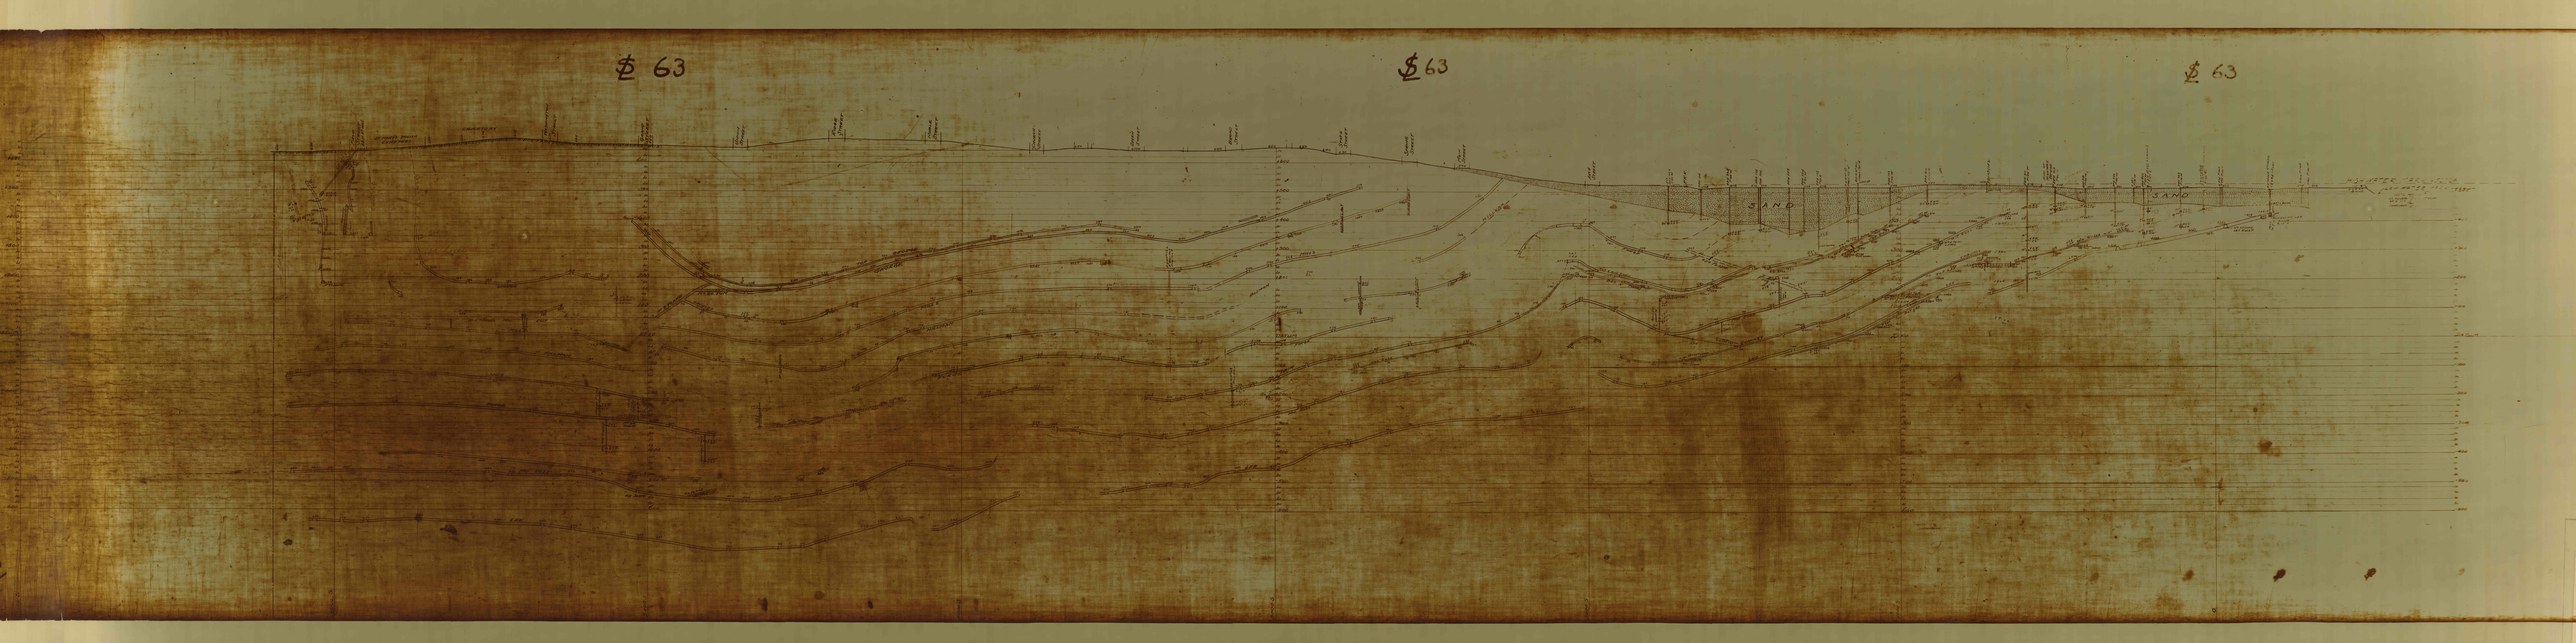
$ 63
$ 63
$ 63
SAND
SAND